



1112 Manatee Avenue West
Bradenton, FL 34205
purchasing@mymanatee.org

Solicitation Addendum

Addendum No.: 5
Solicitation No.: IFBC No. 24-TA005162JH
Project No.: 6093070
Solicitation Title: SR 684 (Cortez Road) Water Main and Force Main
Intracoastal Crossing
Addendum Date: April 10, 2024
Procurement Contact: Jeb Hayter, Procurement Agent III

IFBC No. 24-TA005162JH is amended as set forth herein. Responses to questions posed by prospective bidders are provided below. This Addendum is hereby incorporated in and made a part of IFBC No. 24-TA005162JH.

The deadline to submit all inquiries concerning interpretation, clarification or additional information pertaining to this IFBC was March 21, 2024.

REPLACE:

SECTION C, BID ATTACHMENTS, BID ATTACHMENT 3, PLAN SET/DRAWINGS, PLAN SHEET 4.

Replace Bid Attachment 3, Plan Set/Drawings (Revision 2), plan sheet 4 with Bid Attachment 3, Plan Set/Drawings (Revision 3), plan sheet 4 issued with and attached to Addendum 5, hereby incorporated into this IFBC.

CHANGE TO:

ADVERTISEMENT, DATE, TIME AND PLACE DUE:

The Due Date and Time for submission of Bids in response to this Invitation for Bid Construction (IFBC) is ~~April 11, 2024~~, April 23, 2024, at 11:00 AM ET. Bids must be delivered to the following location: Manatee County Administration Building, 1112 Manatee Avenue West, 7th Floor, Bradenton, FL 34205 prior to the Due Date and Time.

CHANGE TO:

SECTION A, INSTRUCTIONS TO BIDDERS, A.01, BID DUE DATE:

Addendum No. 5
IFBC No. 24-TA005162JH
SR 684 (Cortez Road) Water Main and Force Main Intracoastal Crossing
Revised 4/10/2024 8:34 AM

The Due Date and Time for submission of Bids in response to this Invitation for Bid Construction (IFBC) is ~~April 11, 2024~~, April 23, 2024, at 11:00 AM ET. Bids must be delivered to the following location: Manatee County Administration Building, 1112 Manatee Avenue West, 7th Floor, Bradenton, FL 34205 and time stamped by a Procurement representative prior to the Due Date and Time.

CHANGE TO:

SECTION A, INSTRUCTIONS TO BIDDERS, A.51 SOLICITATION SCHEDULE:

Scheduled Item	Scheduled Date
Mandatory Information Conference / Public Works building located at 1022 26 th Avenue East, Bradenton, FL 34208	March 7, 2024, 3:00 P.M.
Question and Clarification Deadline	March 21, 2024
Bid Response Due Date and Time	April 11, 2024 , 11:00 A.M. ET <u>April 23, 2024</u>
Project Award	May, 2024

QUESTIONS AND RESPONSES:

Q1. Was this design explored with any jack and bore contractors to determine if it was definitely buildable as shown prior to issuing the bid package? If so, are there any further details available to show how and where the boring pits might be built to accommodate the large diameter casings and jacking rigs? If not, would open cutting those pipelines be an option?

R1. An analysis of the constructability was performed for the jack and bore on the west side. The jack and bore was designed at the angle shown and permitted through the FDOT as a diagonal crossing to create more room for the jack and bore pits. The jack and bore east entrance side is 20 feet by 40 feet. Sheet 4 now depicts the approximate locations of the jack and bore pits as well as the dimensions. Open cutting is not currently an option.

NOTE:

Deleted items will be ~~struck through~~ in blue font, added or modified items will be underlined and in red font. All other terms and conditions remain as stated in the IFBC.

INSTRUCTIONS:

Receipt of this Addendum must be acknowledged as instructed in the solicitation document. Failure to acknowledge receipt of this Addendum may result in the response being deemed non-responsive.

END OF ADDENDUM

AUTHORIZED FOR RELEASE

This document, together with the concepts and designs presented herein, is intended only for the specific purpose and client for which it was prepared. Reuse of any information contained herein, in whole or in part, without the written authorization and approval of Kimley-Horn and Associates, Inc. shall be without liability to Kimley-Horn and Associates, Inc.



HORIZONTAL SCALE: 1" = 20'
VERTICAL SCALE: 1" = 4'

LEGEND



	SIDEWALK/CONCRETE DRIVEWAY RESTORATION
	FULL ROADWAY RESTORATION
	MILLING AND RESURFACING
	REMOVE & REPLACE CURB

NOTES:
THE ELEVATIONS OF THE UTILITIES MARKED WITH AN ASTERISK (*) HAVE BEEN ASSUMED ON THE BASIS OF TYPICAL ANTICIPATED SOIL COVERAGE. CONTRACTOR SHALL NOT RELY ON THIS INFORMATION FOR CONSTRUCTION, BUT SHALL BE RESPONSIBLE FOR FIELD LOCATIONS (HORIZONTAL AND VERTICAL) OF ALL UTILITIES CROSSING THE PROPOSED PIPELINES. CONTRACTOR SHALL INCLUDE IN THE UNIT COST OF THE SUBJECT FORCE MAIN CONSTRUCTION, THE COST OF UTILITY ADJUSTMENTS NECESSARY TO ATTAIN DESIGN MINIMUM SEPARATION FOR UTILITIES CONFLICTING WITH THE CONSTRUCTION OF THE PROPOSED FORCE MAIN. INTERRUPTIONS OF ANY EXISTING UTILITY SERVICES SHALL BE NOTICED TO EFFECTED CUSTOMERS A MINIMUM OF 48 HOURS IN ADVANCE AND SHALL NOT EXCEED 4 HOURS IN DURATION.

WHERE CONCRETE REPAIRS ARE NECESSARY AND EXPANSION JOINTS ARE PRESENT, CONTRACTOR TO REMOVE AND REPLACE CONCRETE UP TO THE NEXT EXPANSION JOINT; OTHERWISE, REPLACE CONCRETE AS NECESSARY.

- NOTES:
- CONTRACTOR SHALL RESTRAIN PIPE PER RESTRAIN LENGTHS TABLE ON DETAIL SHEET 24
 - CONSTRUCTION DEWATERING SHALL BE CONDUCTED IN ACCORDANCE WITH ALL FEDERAL, STATE, AND LOCAL REQUIREMENTS INCLUDING BUT NOT LIMITED TO CHAPTERS 62-621.300 AND 62-620 OF THE FLORIDA ADMINISTRATIVE CODE (FAC)
 - EXISTING 2" GAS LINE AND BURIED ELECTRIC TO BE FIELD LOCATED WHERE NECESSARY PRIOR TO CONSTRUCTION
 - WHERE LESS THAN 6" MINIMUM SEPARATION IS SHOWN ALL JOINTS SHALL BE RESTRAINED IN ORDER TO MEET FDEP SEPARATION REQUIREMENTS.

GROUNDWATER / DEWATERING NOTE:
THE PRESENCE OF GROUNDWATER SHOULD BE ANTICIPATED ON THIS PROJECT. CONTRACTOR'S BID SHALL INCLUDE CONSIDERATION FOR THIS ISSUE. WHEN PERFORMING GRADING OPERATIONS DURING PERIODS OF WET WEATHER, PROVIDE ADEQUATE DEWATERING, DRAINAGE AND GROUND WATER MANAGEMENT TO CONTROL MOISTURE OF SOILS.

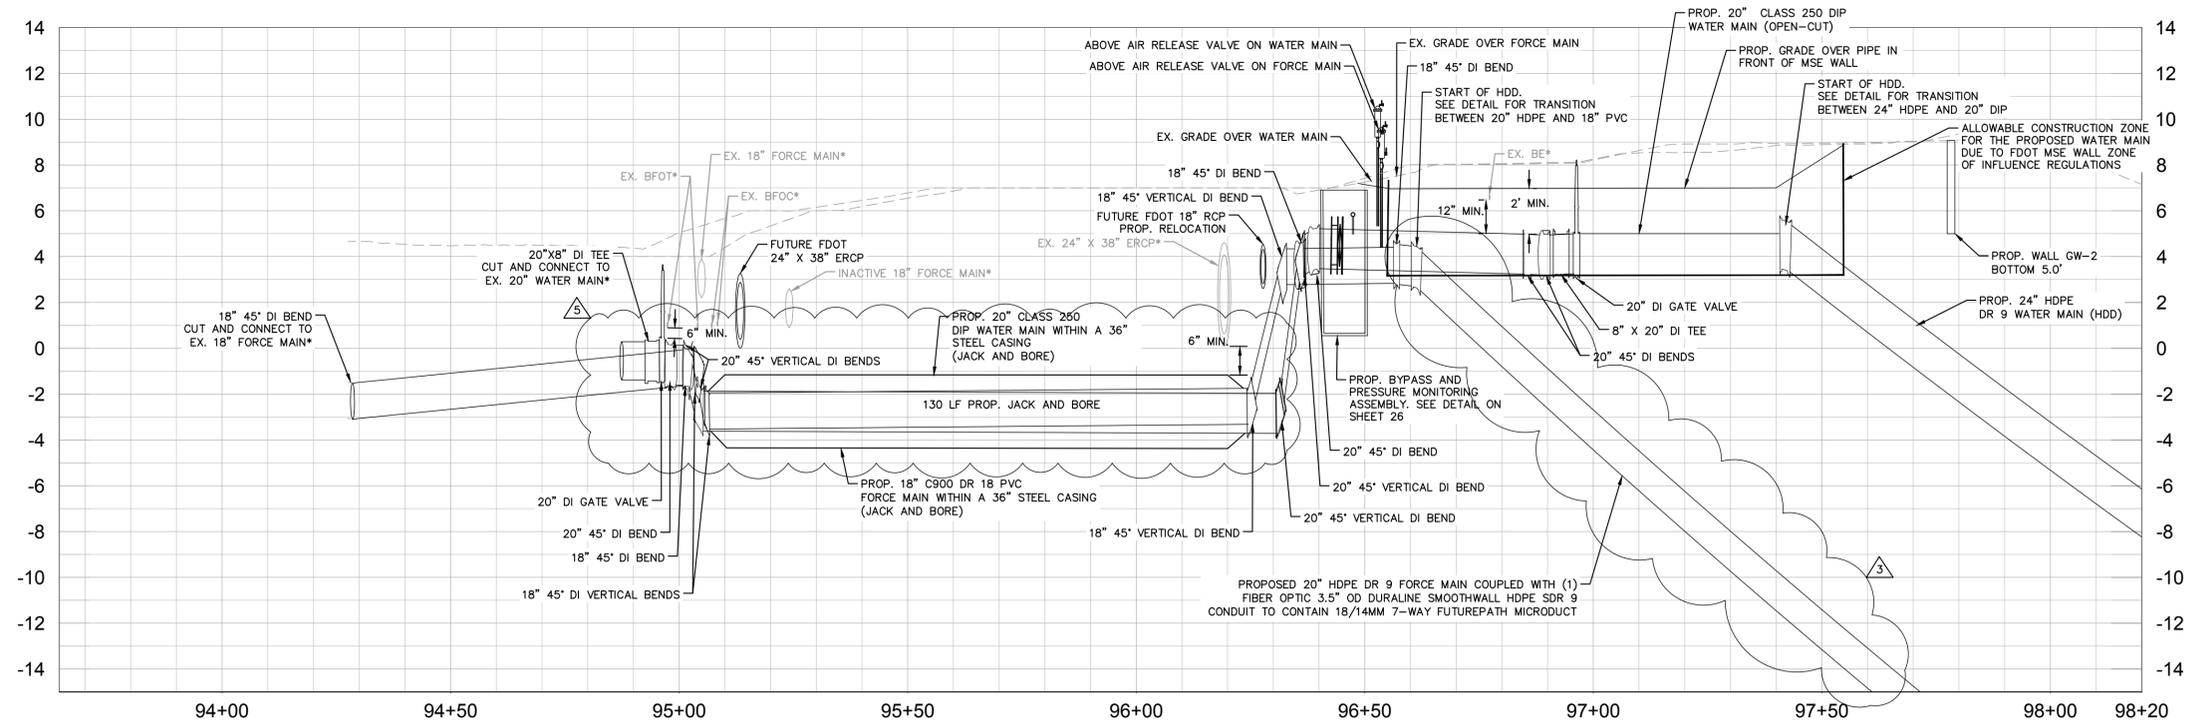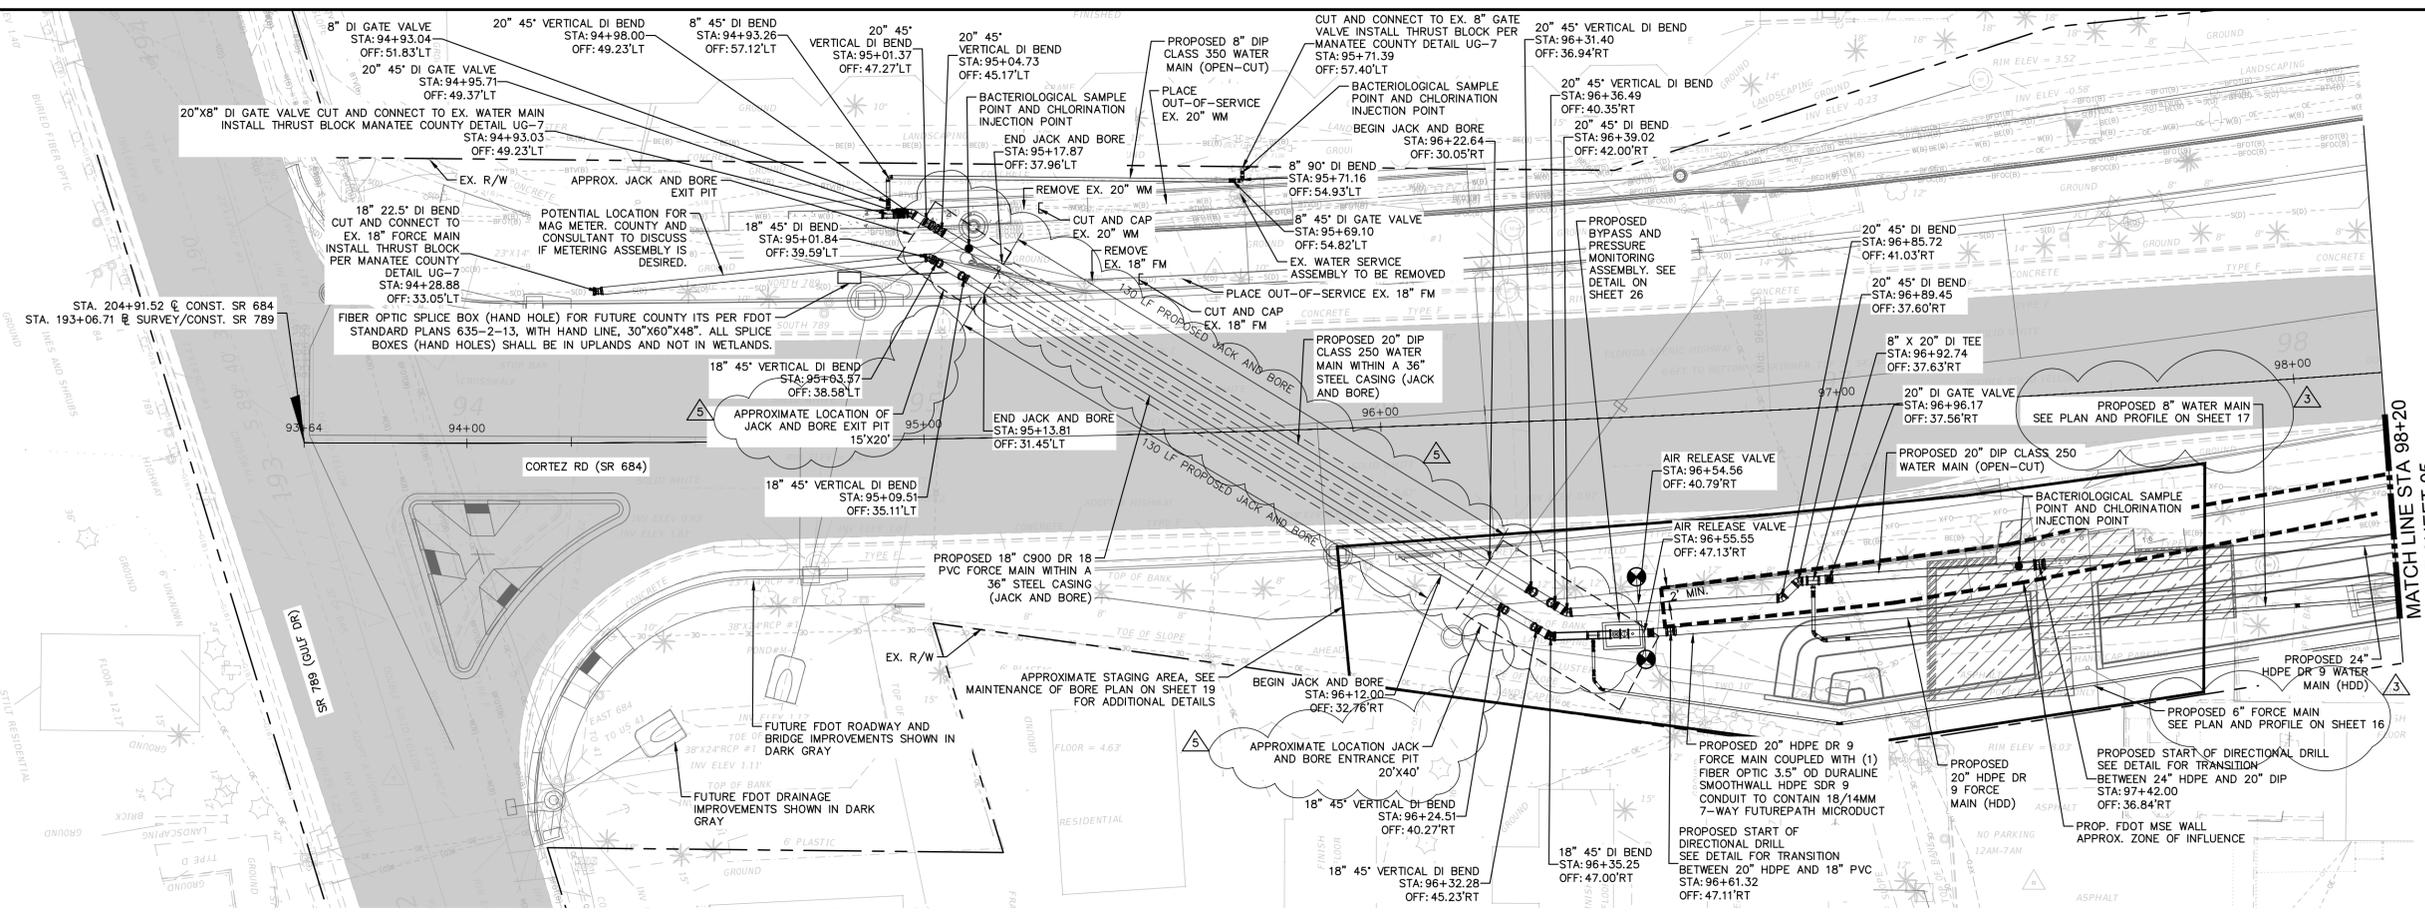

3	ADDENDUM NO. 3	3/25/2024	ALC
5	ADDENDUM NO. 5	4/9/2024	ALC
No.	REVISIONS	DATE	BY

Kimley-Horn

© 2024 KIMLEY-HORN AND ASSOCIATES, INC.
200 CENTRAL AVENUE, SUITE 600, ST. PETERSBURG, FL 33701
PHONE: 727-547-3999
WWW.KIMLEY-HORN.COM REGISTRY NO. 35106

KHA PROJECT 148400081
DATE MARCH 2024
SCALE AS SHOWN
DESIGNED BY JWW
DRAWN BY ALC
CHECKED BY KMS

Manatee County
SR 684 (CORTEZ ROAD) WATER MAIN AND FORCE MAIN INTRACOASTAL CROSSING
MANATEE COUNTY

LICENSED PROFESSIONAL
JORDAN W. WALKER, P.E.
FL LICENSE NUMBER 78652

WEST APPROACH

FL DATE:

SHEET NUMBER **04**