

January 23, 2009

TO: All Bidders

Reference: Invitation for Bid #08-3010BG/US 301

Roadway Improvements from Erie Road to CR 675 (Rutland Road)

ADDENDUM # 1

The following items are issued to add to, modify, and clarify the bid and contract documents. These items shall have the same force and effect as the original bidding and contract documents, and cost involved shall be included in the bid prices. Bids, to be submitted on the specified bid date, shall conform to the additions and revisions listed herein.

- 1. All requests for information or clarification of this IFB must be received by Manatee County Purchasing no later than 5:00 P.M. February 11, 2009.
- 2. Enclosed is a copy of the sign in sheets from the Non Mandatory Information Conference of January 14, 2009 (three (3) pages).
- 3. It was determined that the request that the County supply the bid form to bidders in a revisable digital (excel) format presented more potential negative outcomes than those of a positive nature. The revised bid form pages are included in non-revisable format as part of this addendum.
- 4. Wilson Miller, Inc. has provided the enclosed information: questions & answers, three (3) pages; revised bid form, ten (10) pages; and revised drawings, six (6) each.
- 5. This document in portable document format (PDF) is available on CD (compact disk) upon request. Copies may be obtained at no charge by contacting the Purchasing Division at: 1112Manatee Avenue West, Bradenton, FL 34205: phone (941) 749-3053 or the Manatee County Public Works Department located at: 1022 26th Street East, Bradenton, FL 34208: phone (941) 708-7450, between the hours of 8:00 A.M. and 4:00 P.M. Monday through Friday.

Financial Management – Purchasing Division

Suite 803 - 1112 Manatee Avenue West, Bradenton, FL 34205

PHONE: 941.749.3014 * FAX: 941.749.3034

www.mymanatee.org

January23, 2009

TO: All Bidders

Reference: Invitation for Bid #08-3010BG/US 301

Roadway Improvements from Erie Road to CR 675 (Rutland Road)

Addendum # 1

All sealed bids received will be opened on Wednesday, February 25, 2009 at 2:00 P.M. as detailed in the Invitation For Bid document.

Sincerely,

R.C. "Rob" Cuthbert, C.P.M., CPPO

Purchasing Manager

ATTENDANCE RECORD

INFORMATION CONFERENCE

Title: IFB #08-3010BG / US 301 ROADWAY IMPROVEMENTS FROM ERIE ROAD

TO CR675 (RUTLAND ROAD)

Location: 1022 26TH Ave East

Bradenton, FL

Public Works Conference Room A&B

Date / Time: January 14, 2009 @ 9:00am

Project: Referenced Above (SEE TITLE)

NAME / TITLE (PLEA	SE PRINT) REPRESENTING
Blair C Getz / Contract Negotiator	Manatee County Purchasing
ROB CUPHBERS	MC-RREHASNG
3 Sean D'Agostino	C-Squared CBC, Inc.
	JOHN CARLO INC.
Julie BAyen	GATOR GRANNG+PAUING
JACK MORSINK	aiguiotti Coutractio
MATT MERUCES	LL K
DON GWYN	PRINCE CONTEACTING, U.C.
K.C. COULTHART	E.T. MACKENZIE CO.
HIKE RYAN	UNIVERSAL ENGINEERING
Brewster Combkonsk,	Universal Engineering
Roy Smith	RUSSELL ENGINEERING Tre
JAN POWELL	LIRIGHT CONST. GROUPING
	Kuxhausen Const Inc
Don woodruff RICK Hoffman	Woodruff + Sons, Inc
ALAM AUTON MAR	FOOT
xxxxxxxxxxx	PAGE 1
	Blair C Getz / Contract Negotiator Rob CUPHBERS Bean D'Agostino DAVIS SLAWIAK SR BST. MINE BAYEN JACK MORBINK MATT MERUCLI DON GWYN K.C. COULTHIRT HIKE RYAN BROY SMITH JAN POWELL PAULS KUXHAUSEN DON WOODNUTF RICK HOFFMAN ALAN ANDTH CHET SUCS MAR

ATTENDANCE RECORD

INFORMATION CONFERENCE

tle: IFB #08-3010BG / US 301 ROADWAY IMPROVEMENTS FROM ERIE ROAD TO CR675 (RUTLAND ROAD)

Location: 1022 26TH Ave East

Bradenton, FL

Public Works Conference Room A&B

Date / Time: January 14, 2009 @ 9:00am

Project: Referenced Above (SEE TITLE)

TELEPHONE / FAX	NAME / TITLE (PLEA	ASE PRINT) REPRESENTING
941-359-7368	PHIL CHARMI	SARASSTA OPERATIONS
813-623-2856/813-620-160	2 DAN EGAN	Cove & Grothen
941-755-2850 941-727-5980	Jon Wymen	Superior Asphalt, Dec.
941-748-4693/941-744-1643	Russelly ATT, VP	HYATT SULVEY SKS. WSE
941 845 0124 /941 841 0135	Dean Daigler	Semper & Services
941-723-1611 941-729-8365	GENNY DUNN	WICSTRA CONST
\$13-248-3878 /813-367-4		- [4] [1] :
813-248-3878 /813-579-1106	TISH GATES	KIMMINS CENTRACTING
941-328-1053 941-328-110		NEAL COMMUNITIES
941-708-7262 /941-708-7506		MANATEE COUNTY TRAFFIC OPERATIONS
941-378-9273/94/-74772	34 Gene Baner	ENUTRON MENTAL ANALYSTS - PERMITTING
(863) 519 -2769	BRIAN BLAIR	PBS &J / FOOT ASST. PROJECT MAA
(863) 519-2534 863-519-1956	Jerrold R. Whitt	PBSET/FOOT-Utilities
(941) 486-3600 / 941-486-3600	DAVE REID	AJAX PAVING INDUSTRIES
941 708 2487	Sia Mollanazer	Manater Co. Gov.
941)355-7178 (941)359-9728	CRAGKETRON	APAC Southers ING
141-355-8525/94/- 351-8854	ROLAND CARTER	FREUSRICK DERRY CO, INC
XXXXXXXXXXXXXXXXXXXXXX	XXXXXXXXXXXXX	Page 2

ATTENDANCE RECORD

INFORMATION CONFERENCE

Title: IFB #08-3010BG / US 301 ROADWAY IMPROVEMENTS FROM ERIE ROAD TO CR675 (RUTLAND ROAD)

Location: 1022 26TH Ave East

Bradenton, FL

Public Works Conference Room A&B

Date / Time: January 14, 2009 @ 9:00am

Project: Referenced Above (SEE TITLE)

TELEPHONE / FAX	NAME / TITLE (PLEA)	SE PRINT) REPRESENTING
941-907-6900/907-6910		
li u	Parid Manning Mitch H-Knight Malm Biggers LARRY SAUS	11
(863) 519-2250	malm Bigetta	F)9.T
813 927 6887	LARRY SAUCS	URS
\$ 941-708-7450 ext 7338	Vincent CANNA	MCO-PWKS
	· · · · · · · · · · · · · · · · · · ·	
		0-
		2:-
XXXXXXXXXXXXXXXXXXXXXXXXXXXXXXXXXXXXXXX	xxxxxxxxxxx	Page 3

WilsonMiller®

ADDENDUM #1

January 23, 2009

To:

US 301 Bidders

Subject:

IFB #08-3010BG.

US 301 Roadway Improvements

The following information represents responses to questions received at the January 14, 2009, Information Conference and additional information.

- 1. Q: Who should bidders contact to request permission to make test holes within the project area?
 - A: Pond Nos. 1, 3, and 4 are existing ponds with very little earthwork required. Soil borings were performed on pond Nos. 2 and 5 and information is included in the plans. No additional borings appear to be needed.
- 2. Q: Page 37 of the Specifications Package contains provisions for price adjustments for gasoline and diesel fuel. Are price adjustments also allowed for bituminous material?
 - A: The Specifications Package included in the bid documents reflects revisions to the 2007 Edition of the Florida Department of Transportation Standard Specifications. Section 9-2.1.2, Bituminous Material, of the Standard Specifications remains in effect and is applicable to this project.
- 3. Q: The bid documents state 800-calendar-day contract completion time. Please clarify.
 - A: The contract completion time will be established by the contractor using the A+B bidding method as set out in the bid documents. The 800-calendar-day mentioned by the bidder could not be located in the bid documents and is inaccurate. Although Manatee County anticipates a maximum 730-calendar-day contract duration, the actual contract time will be established by the bidder.
- 4. Q: Will optional pipe materials be allowed?
 - A: Yes. Enclosed is Plan Sheet No. 22A, Optional Materials Tabulation. Please carefully read the general notes on this page.
- 5. Q: Plan sheet No. 24 contains "general notes pertaining to Construction Precautions for the Florida Sandhill Crane." The notes state no construction is to occur within 400 feet of any nest location between January and July. How is a bidder to determine all nest locations (and adjust bid accordingly) and will the contract duration be adjusted if new nests are discovered?

800.649.4336

941.907.6900

F 941.907.6910

6900 Professional Parkway East Suite 100 Sarasota, Florida 34240

WilsonMiller.com



WilsonMiller®

US 301 Bidders Re IFB #08-3010BG January 23, 2009 Page 2 of 3

A: The contractor must have a qualified biologist approved by the County, to locate any active sandhill crane nest(s) within the vicinity of the project limits prior to commencement of and throughout the duration of any construction. If any nests are discovered, the County will consider each situation on a case-by-case basis as to whether or not an adjustment of contract time is made. However, the contractor is responsible to use a qualified biologist approved by the County as described in the Plan Note and further, to follow instructions in accordance with Florida Fish Wildlife Conservation Commission in consultation with the County and the qualified biologist hired by the contractor.

Attached is revised plan sheet No. 24 with addition to Note 1 under "Construction Precautions for the Florida Sandhill Crane."

- 6. Q: Please clarify intent of sheet No. 23, note 14, "All existing damaged culverts and/or concrete mitered ends shall be repaired/replaced, as needed."
 - A: All existing culverts or mitered ends which are specified to remain in place and which are damaged by the Contractor shall be repaired/replaced at no additional cost to Manatee County.

Additional Information Presented at January 14, 1009, Information Conference

Pavement design is revised as follows:

Change Friction Course FC-12.5 (1½") Rubber
 friction Course FC-9.5 (1") Rubber

Change Type SP-12.5 Structural Course (Traffic C) (1½")
 to Type SP-12.5 Structural Course (Traffic C) (1½")
 and Type SP-9.5 Structural Course (Traffic C) (1")

Change Mill Existing Asphalt Pavement (1½" Average Depth)
 Mill Existing Asphalt Pavement (1" Average Depth)

Attached are Revised Bid Form and Revised Plan Sheet Nos. 12 and 13 reflecting these changes.

WilsonMiller®

US 301 Bidders Re IFB #08-3010BG January 23, 2009 Page 3 of 3

Additional Questions Received from Bidders

1. Q: Regarding alternate bid items 12-A and 12-B. Are these items for the line stop that is called out for in the utility adjustment plans on sheet 321 at station 130+60?

Also in the plan package there are 2 sets of utility adjustment plans. They both seem to be the same other than the dates stamped are different. One is printed on 8-26-08 and the other on 7-28-08. The set that was printed on 7-28-08 has a Manatee Co. health dept. stamp dated 9-18-08. Which set should be used?

A: The alternate bid items 12-A and 12-B are to obtain alternate bid prices for the installation of the line stop located at station 130+60, left as shown on utility adjustment sheet 321. Manatee County wants to have these alternate bid prices to allow them the opportunity to choose which method of isolating the 20-inch water main will work the best in this situation.

On the CD provided to all bidders, there are several sets of utility adjustment plans, all with Manatee County's utilities shown.

The two sets referred to in this question are located in the subfolder for "Utility Adjustment Plans" and are permit sets approved by Manatee County Health Department (HRS) dated September 18, 2008, for the potable water system relocations and new water main installations, including test sample locations, and the FDEP wastewater permit set dated August 26, 2008. These two sets of Manatee County utility adjustment plan permit sets are provided to each bidder to assist them in their identification of the permit testing requirements and incorporate into their bid as the bidder deems necessary.

The utility adjustment plans to be used in preparing each bid are included in the overall US 301, Segment "B" construction plan set, sheets 299 through 366 located in folder "F - Plans" on the CD provided to all bidders.

Sincerely,

WilsonMiller, Inc.

Mitchell D. McKnight, P.E.

With Mulph

Vice President

Regional Manager, Transportation

Encl. - as noted

ITEM	FDOT ITEM	DESCRIPTION	UNIT	QTY	UNIT PRICE	AMOUNT
1	101-1	MOBILIZATION	LS	1		
2	102-1	MAINTENANCE OF TRAFFIC	LS	. 1		
3	102-3	COMMERCIAL MATERIAL FOR DRIVEWAY MAINTENANCE	CY	922		
4	102-14	TRAFFIC CONTROL OFFICER	МН	160		· · · · · · · · · · · · · · · · · · ·
5	102-99	CHANGEABLE VARIABLE MESSAGE SIGN - TEMPORARY	ED	365		
6	104-10-2	SYNTHETIC BALES	LF	6,680		
7	104-11	FLOATING TURBIDITY BARRIER	LF	938		
8	104-13-1	STAKED SILT FENCE, TYPE III	LF	67,061		
9	104-15	SOIL TRACKING PREVENTION DEVICE	EA	5		
10	104-16	ROCK BAG	EA	1,500		
11	109-71-4	FIELD OFFICE,1200 SQ FT	DA	730		
12	110-1-1	CLEARING & GRUBBING	LS	1		
13	110-4	REMOVAL OF EXISTING CONCRETE PAVEMENT	SY	2,834		
14	110-7-1	MAILBOX, F&I SINGLE	EA	15		
15	120-1	REGULAR EXCAVATION	CY	68,886		
16	120-4	SUBSOIL EXCAVATION	CY	12,000		
17	120-6	EMBANKMENT	CY	98,755		
18	160-4	TYPE B STABILIZATION	SY	225,204		
19	285-701	OPTIONAL BASE, BASE GROUP 01	SY	2,274		
20	285-709	OPTIONAL BASE, BASE GROUP 09	SY	198,875		
21	327-70-1	MILLING EXIST ASPH PAVT, 1" AVG DEPTH	SY	5,348		
22	334-1-13	SUPERPAVE ASPHALTIC CONC, TRAFFIC C	TN	23,035		
23	337-7-32	ASPHALTIC CONCRETE FRICTION COURSE-INC BIT/RUBBER, FC-9.5 (RUBBER) (1")	TN	9,583		
24	400-1-11	CONCRETE CLASS I, RETAINING WALLS	CY	222		
25	400-1-15	CONCRETE PAD AROUND POLES & PULL BOXES	CY	8		
26	400-1-2	CONCRETE CLASS I, ENDWALLS	CY	63		
27	425-1-351	INLETS, CURB, TYPE P-5, <10'	EA	53		
28	425-1-352	INLETS, CURB, TYPE P-5, >10'	EA	2		
29	425-1-355	INLETS, CURB, TYPE P-5, PARTIAL	EA	2		
30	425-1-451	INLETS, CURB, TYPE J-5, <10'	EA	2		
31	425-1-452	INLETS, CURB, TYPE J-5, >10'	EA	1		
32	425-1-361	INLETS, CURB, TYPE P-6, <10'	EA	38		

ITEM	FDOT ITEM	DESCRIPTION	UNIT	QTY	UNIT PRICE	AMOUNT
33	425-1-461	INLETS, CURB, TYPE J-6, <10'	EA	1		
34	425-1-462	INLETS, CURB, TYPE J-6, >10'	EA	3		
35	425-1-541	INLETS, DT BOT, TYPE D, <10'	EA	45		
. 36	425-1-542	INLETS, DT BOT, TYPE D, >10'	EA	1		
37	425-1-543	INLETS, DITCH BOTTOM, TYPE D, J BOT, <10'	EA	13		
38	425-1-544	INLETS, DITCH BOTTOM, TYPE D, J BOT, >10'	EA	2		.•
39	425-1-545	INLETS, DITCH BOTTOM, TYPE D, PARTIAL	EA	2		
40	425-1-901	INLETS, SPECIAL, <10'	EA	20		
41	425-1-902	INLETS, SPECIAL, >10'	EA	6		
42	425-2-41	MANHOLES, P-7, <10'	EA	20		
43	425-2-43	MANHOLES, P-7, PARTIAL	EA	1		
44	425-2-61	MANHOLES, P-8, <10'	EA	9		
45	425-2-71	MANHOLES, J-7, <10'	EA	38		
46	425-2-72	MANHOLES, J-7, >10'	EA	11		
47	425-2-91	MANHOLES, J-8, <10'	EA	2		
48	425-2-92	MANHOLES, J-8, >10'	EA	7		
49	425-90-1	WEIR	EA	2		
50	430-175-101	PIPE CULVERT OPTIONAL MATERIAL, ROUND - SHAPE, 0-24" STORM SEWER	LF	13,229		
51	430-175-102	PIPE CULVERT OPTIONAL MATERIAL, ROUND - SHAPE, 25-36" STORM SEWER	LF	8,539		trans management of the contract of the contra
52	430-175-103	PIPE CULVERT OPTIONAL MATERIAL, ROUND - SHAPE, 37-48" STORM SEWER	LF	4,238		
53	430-175-104	PIPE CULVERT OPTIONAL MATERIAL, ROUND - SHAPE, 49-60" STORM SEWER	LF	3,181		
54	430-175-105	PIPE CULVERT OPTIONAL MATERIAL, ROUND - SHAPE, 61" OR GREATER STORM SEWER	LF	224		
55	430-175-201	PIPE CULV, OPTIONAL MATERIAL, OTHER - ELIP / ARCH, 0-24SS "	LF	4,228		
56	430-175-202	PIPE CULV, OPTIONAL MATERIAL, OTHER - ELIP / ARCH, 25-36SS "	LF	800		
57	430-175-203	PIPE CULV, OPTIONAL MATERIAL, OTHER - ELIP / ARCH, 37-48SS "	LF	301		
58	430-982-129	MITERED END SECTION, OPTIONAL ROUND, 24 CD "	EA	4		
59	430-982-145	MITERED END SECTION, OPTIONAL ROUND, 72" CD	EA	1		
60	430-984-125	MITERED END SECTION, OPTIONAL ROUND, 18 SD "	EA	2		-
61	430-984-129	MITERED END SECTION, OPTIONAL ROUND, 24 SD "	EA	. 2		
62	430-984-141	MITERED END SECTION , OPTIONAL ROUND, 48 SD "	EA	2		
63	430-984-143	MITERED END SECTION , OPTIONAL ROUND, 60 SD "	EA	2		
64	430-984-625	MITERED END SECT, OPTIONAL - ELLIPTICAL / ARCH, 18 SD "	EA	3		-
65	430-984-629	MITERED END SECT, OPTIONAL - ELLIPTICAL / ARCH, 24 SD "	EA	6		

ITEM	FDOT ITEM	DESCRIPTION	UNIT	QTY	UNIT PRICE	AMOUNT
66	440-1-50	UNDERDRAIN, TYPE V	LF	3,030		
67	440-1-60	UNDERDRAIN, TYPE SPECIAL	LF	13,679		
68	440-73-2	UNDERDRAIN OUTLET PIPE, 6 "	LF	1,759		
69	514-72	LINER (IMPERVIOUS) PVC	SY	7,000		
70	515-2-301	PEDESTRIAN, BICYCLE RAILING, ALUMINUM ONLY, 42" PICKET RAIL	LF	1,260		
71	520-1-7	CONCRETE CURB & GUTTER, TYPE E	LF	6,755		
72	520-1-10	CONCRETE CURB & GUTTER, TYPE F	LF	39,166		
73	520-1-8	CONCRETE CURB & GUTTER, SPECIAL	LF	55		
74	520-5-12	TRAFFIC SEPARATOR CONCRETE-TYPE I, 6' WIDE	LF	322		
75	520-5-41	TRAFFIC SEPARATOR CONCRETE- TYPE IV, 4' WIDE	LF	665		
76	522-1	SIDEWALK CONCRETE, 4 THICK "	SY	20,246		
77	522-2	SIDEWALK CONCRETE, 6 THICK "	SY	1,793		
78	530-3-4	RIPRAP, RUBBLE, F&I, DITCH LINING	TN	23		
79	550-10-220	FENCING, TYPE B, 5.1-6.0, STANDARD	LF	824		
80	550-10-222	FENCING, TYPE B, 5.1-6.0, W/ VINYL COATING	LF	1,077		
81	550-60-212	FENCE GATE, TYPE B, SINGLE, 6.1 -12.0' OPENING	EA	1		
82	550-60-222	FENCE GATE, TYPE B, DOUBLE, 6.1-12.0' OPENING	EA	3		
83	555-1-1	DIRECTIONAL BORE, LESS THAN 6 "	LF	590		
84	570-1-2	PERFORMANCE TURF, SOD	SY	182,618		
85	630-1-11	CONDUIT - SIGNALS, FURNISH & INSTALL, ABOVEGROUND	LF	65		
86	630-1-12	CONDUIT UG PVC SCH 40-3"	LF	22,410		
87	632-7-1	CABLE, SIGNAL, FURNISH & INSTALL	PI	3		
88	634-4-112	SPAN WIRE ASSEMBLY, F&I, 2 WIRE, DIAGONAL	PI	1		
89	635-1-11	PULL & JUNCTION BOXES, F&I, PULL BOX	EA	23		
90	639-1-13	SIGNALS, ELECTRICAL POWER SERVICE, OVERHEAD	AS	1		
91	639-1-22	SIGNALS,ELECTRICAL POWER SERVICE,UNDERGROUND,	AS	2		
92	639-2-1	SIGNALS, ELECTRICAL SERVICE WIRE	LF	750		
93	641-2-11	PRESTRESSED CONCRETE POLE, F&I, TYPE P-II PEDESTAL	EA	2		
94	641-2-15	PRESTRESSED CONCRETE POLE, F&I, TYPE P-V	EA	2		
95	649-31-202	MAST ARM,F&I, WIND SPEED-130,SINGLE ARM,W/0 LUMINAIRE-46	EA	1		
96	649-31-203	MAST ARM,F&I, WIND SPEED-130,SINGLE ARM,W/0 LUMINAIRE-60	EA	1		
97	649-31-204	MAST ARM,F&I, WIND SPEED-130,SINGLE ARM,W/0 LUMINAIRE, ARM LENGTH 70.5	EA	1		
98	649-31-212	MAST ARM,F&I, WIND SPEED-130,DOUBLE ARM,W/0 LUMINAIRE, 36-60	EA	1		

ITEM	FDOT ITEM	DESCRIPTION	UNIT	QTY	UNIT PRICE	AMOUNT
99	649-31-216	MAST ARM,F&I, WIND SPEED-130,DOUBLE ARM,W/0 LUMINAIRE, 46-70.5	EA	1		
100	650-51-311	TRAFFIC SIGNAL, F&I, 3 SECTION, 1 WAY, STANDARD	AS	15		
101	650-51-511	TRAFFIC SIGNAL, F&I, 5 SECTIONS, 1 WAY, STANDARD	AS	2		
102	653-191	PEDESTRIAN SIGNAL, F&I, LED - COUNT DOWN, 1 DIRECTION	AS	4		/
103	653-192	PEDESTRIAN SIGNAL, F&I, LED - COUNT DOWN, 2 DIRECTIONS	AS	2		
104	659-101	SIGNAL HEAD AUXILIARIES, F&I, BACK PLATES 3 SECT	EA	10		
105	659-106	SIGNAL HEAD AUXILIARIES, F&I, TUNNEL VISOR	EA	60		
106	659-107	SIGNAL HEAD AUXILIARIES, F&I, ALUMINUM PEDESTAL	EA	7		
107	659-118	SIGNAL HEAD AUXILIARIES, F&I, BACK PLATES 5 SECT CLUSTER	EA	2		
108	663-74-11	VEHICLE DETECTOR ASSEM, F&I, OPTICAL TYPE	EA	4		
109	665-11	PEDESTRIAN DETECTOR, F&I, DETECTOR STATION, POLE OR CONTROLLER CABINET MOUNTED	EA	8		
110	670-5-111	TRAFFIC CONTROLLER ASSEMBLY, F&I, NEMA, 1 PREEMPTION	AS	2		
111	690-10	SIGNAL HEAD TRAFFIC ASSEMBLY REMOVAL	EA	4		
112	690-32-1	POLE REMOVAL, SHALLOW, DIRECT BURIAL	EA	1		
113	690-33-1	POLE REMOVAL, DEEP DIRECT BURIAL	LF	20		
114	690-80	SPAN WIRE ASSEMBLY, REMOVE	EA	1		
115	690-90	CONDUIT & CABLING REMOVE	ΡΙ	1		
116	690-100	SIGNAL EQUIPMENT MISCELLANOUS REMOVE	PI	1		
117	699-1-1	INTERNAL ILLUM SIGN, ST NAME	EA	4		
118	700-20-11	SINGLE POST SIGN, F&I, LESS THAN 12SF	AS	114		
119	700-20-12	SINGLE POST SIGN, F&I, 12SF - 20SF	AS	10		
120	700-20-40	SINGLE POST SIGN, RELOCATE	AS	28		
121	700-20-60	SINGLE POST SIGN, REMOVE	AS	19		
122	700-21-11	MULTI-POST SIGN, F&I, LESS THAN 50SF	AS	2		
123	700-48-18	SIGN PANELS, F&I, 15 OR <	EA	21		
124	705-11-1	DELINEATOR, FLEXIBLE TUBULAR	EA	39		
125	706-3	RETRO-REFLECTIVE PAVEMENT MARKERS (RPM)	EA	2,074		
126	710-11-190	PAINTED PAVEMENT MARKINGS, STANDARD, WHITE, ISLAND NOSE	SF	237		
127	710-11-290	PAINTED PAVEMENT MARKINGS, STANDARD, YELLOW, ISLAND NOSE	SF	412		
128	710-90	PAINTED PAVEMENT MARKINGS, FINAL SURFACE	LS	. 1		
129	711-11-111	THERMOPLASTIC, STANDARD, WHITE SOLID 6"	NM	8		
130	711-11-112	THERMOPLASTIC, STANDARD, WHITE, SOLID, 8"	NM	3		
131	711-11-123	THERMOPLASTIC, STANDARD, WHITE, SOLID, 12"	LF	5,529		

ITEM	FDOT ITEM	DESCRIPTION	UNIT	QTY	UNIT PRICE	AMOUNT
132	711-11-114	THERMOPLASTIC, STANDARD, WHITE, SOLID, 18"	NM	2		
133	711-11-125	THERMOPLASTIC, STANDARD, WHITE, SOLID, 24"	LF	822		
134	711-11-131	THERMOPLASTIC, STANDARD, WHITE, SKIP, 6"	GM	8		
135	711-11-141	THERMOPLASTIC, STANDARD, WHITE, SKIP, 6"	LF	1,644		
136	711-11-160	THERMOPLASTIC, STANDARD, WHITE, MESSAGE	EA	158	-	
137	711-11-170	THERMOPLASTIC, STANDARD, WHITE, ARROW	EA	115		
138	711-11-211	THERMOPLASTIC, STANDARD, YELLOW, SOLID 6"	NM	8		
139	711-11-222	THERMOPLASTIC, STANDARD, YELLOW, SOLID 8"	LF	1,991		
140	711-11-224	THERMOPLASTIC, STANDARD, YELLOW, SOLID, 18"	LF	1,384		
141	711-11-241	THERMOPLASTIC, STANDARD, YELLOW, SKIP, 6"	LF	1,467		
142	715-1-13	CONDUCTOR #4 INSULATED	LF	109,450		
143	715-1-63	REMOVE EXIST. 3#4 CONDUCTORS - DISPOSE	LF	150		
144	715-2-11	CONDUIT UNDERGROUND PVC SCH 40 - 2"	LF	23,090		
145	715-7-11	LOAD CENTER (SECONDARY VOLTAGE)	EA	3		
146	715-7-21	REWORK EXIST. LOAD CENTER '50'	EA	1		
147	715-10-2	CONCRETE FOUNDATION RELOCATED POLE	EA	1		
148	715-14-12	PULL BOX (SIDEWALK)	EA	226		
149	715-500-1	POLE CABLE DISTRIBUTION SYSTEM (CONVENTIONAL)	EA	146		
150	715-516-150	LIGHTING POLE COMPLETE (ALUM) POLE TOP MOUNT 50'	EA	129		
151	715-516-414	LIGHTING POLE COMPLETE (FIBERGLASS) POLE TOP MOUNT 14'	EA	16		
152	715-540-000	RELOCATE EXIST. LIGHT POLE	EA	1		
153		WEIR (TEMPORARY)	EA	1		
154		REPLACE BRICK PAVERS AND RIBBON CURB	SY	140		
155		POND 5 WELL AND CONTROLS	LS	1		
156		POND 5 AERATOR	EA	3		
157		POND 5 PIPING	LS	1		
158	xxx-xxx	DISCRETIONARY WORK (Roadway)			STO TO THE	\$2,600,000.00
		SUBTOTAL BASE BID PRICE (Road Construction)				

ITEM	FDOT ITEM	DESCRIPTION	UNIT	QTY	UNIT PRICE	AMOUNT
l	UTILITIES					
		WASTEWATER MAIN RELOCATIONS				
1		REMOVE 2"ARV (ABOVE GROUND)	LF	4		
2		REMOVE 4"PVC FM PIPE & FITTINGS	LF	347		
3		REMOVE 6" PVC FM PIPE & FITTINGS	LF	406		
4		REMOVE 8" PVC FM PIPE & FITTINGS	LF	7,896		
5		REMOVE 10" PVC FM PIPE & FITTINGS	LF	2,609		
6		REMOVE 16" PVC FM PIPE & FITTINGS	LF	392		
7		REMOVE VALVE BOX (RISER)	EA	5		
8		REMOVE CASINGS, ALL DIAMETERS	LF	65		
9		MODIFY 4' DIA. MANHOLE RIM & COVER	EA	1		
10		ADJUST 4' DIA. MANHOLE RIM & COVER	ĘA	1		The state of the s
11		MODIFY 5' DIA. MANHOLE RIM & COVER	EA	4		
12		ADJUST 5' DIA. MANHOLE RIM & COVER	EA	8		
13		CORE BORE EXIST. MH FOR 12" FM	EA	1		
14		ADJUST VALVE BOXES TO NEW GRADE	EA	18		
15		2" PVC (CL-200) RJ FM PIPE	LF	409		
16		4" PVC (C-900, DR-18) FM PIPE	LF	113		
17		4" PVC (C-900, DR-18) RJ FM PIPE	LF	188		
18		6"HDPE (DR-11) FM - (F&I)	LF	260		
19		8" PVC (C-900, DR-18) R.J. FM PIPE	LF	95		
20		8" HDPE (DR-11) FM - DIRECTIONAL BORE	LF	145		
21		10" PVC (C-900, DR-18) R.J. FM PIPE	LF	45		
22		10" HDPE (DR-11) FM PIPE - (F&I)	LF	120		
23		12" HDPE (DR-11) FM PIPE (F&I)	LF	165		
24		16" PVC (C-905, DR-18) R.J. FM PIPE	LF	40		
25			LF	403		
26		18" HDPE (DR-11) FM PIPE (F&I)	LF	225		
27		8 A.100 WALL STEEL CASING (P&I)	LF	55		
28		12" X .188" WALL STEEL CASING (J&B)	LF	135		
29		24" X .344" WALL STEEL CASING (J&B)	EA	4		
30		2" PLUG VALVE 4" PLUG VALVE	EA	6	-	

ITEM	FDOT ITEM	DESCRIPTION	UNIT	QTY	UNIT PRICE	AMOUNT
31		6" PLUG VALVE	EA	3		
32		10" GATE VALVE	EA	1		
33		10" PLUG VALVE	EA	1		
34		18" PLUG VALVE	EA	1		
35		16" X 2" DOUBLE STRAP TAPPING SADDLE & 2" CORP STOP	EA	3		
36		16" X 2" DOUBLE STRAP TAPPING SADDLE & 2" TAPPING VALVE	EA	2		
37		16" X 8" TAPPING SLEEVE & 8" TAPPING VALVE	EA	3		
38		2" ARV ASS'Y - ABOVE-GROUND	EA	3		
39		1" ARV ASS'Y IN 5' DIA DOGHOUSE MH	EA	1		
40		2" ARV ASS'Y IN 5' DIA DOGHOUSE MH	EA	9		
41		TYPE A - 16" PVC RJ FM RELOCATION (HORIZ. ADJ.) W/ EX. FM RESTRAINMENT	EA	7		
42		TYPE B - 16" PVC RJ FM RELOCATION (VERT. ADJ.) W/ EX. FM RESTRAINMENT	EA	2		
43		TYPE "D" - 16" PVC RJ FORCE MAIN RELOCATION W/ EX. FM RESTRAINMENT	EA	1		
44		TYPE "G" - 16" PVC RJ FORCE MAIN RELOCATION W/ EX. FM RESTRAINMENT	EA	3		
45		TYPE "H" - 16" PVC RJ FM RELOCATION (VERT. ADJ.) W/ EX. FM RESTRAINMENT	EA	1		
46		PROTECT 16" PVC FM AT (CURB INLET)	EA	3		
47		RESTRAIN EXISTING 16" PIPE	LF	90		
48		4" FORCE MAIN CUT-IN	EA	2		
49		6" FORCE MAIN CUT-IN	EA	5		
50		8" FORCE MAIN CUT-IN	EA	1		
51		10" FORCE MAIN CUT-IN	EA	1		
52		16" FORCE MAIN CUT-IN	EA	30		
53		8" PVC (SDR-26) GRAVITY SEWER MAIN	LF	88		
54	xxx-xxx	DISCRETIONARY WORK (Wastewater Relocations)			And the frame of the state of t	\$ 110,000.00
		SUBTOTAL, WASTEWATER RELOCATIONS				

US 301 - Segment B

From Erie Road to CR 675 Manatee County #6066760

ITEM	FDOT ITEM	DESCRIPTION	UNIT	QTY	UNIT PRICE	AMOUNT
		PARRISH FORCE MAIN				
1		4" PVC (C-900, DR-18) FM PIPE	LF	1,310		
2		4" PVC (C-900, DR-18) RJ FM PIPE	LF	374		
3		12" X .188" WALL STEEL CASING (F&I)	LF	113		
4		16" PVC (C-905, DR-18) R.J. FM PIPE	LF	190		
5		18" PVC (C-905, DR-18) R.J. FM PIPE	LF	123		
6		18" HDPE (DR-11) FM - FIELD LAID	LF	2,147		
7		18" HDPE (DR-11) FM - DIRECTIONAL BORE	LF	710		
8		4" PLUG VALVE	EA	4		
9		16" PLUG VALVE	EA	3		
10		18" PLUG VALVE	EA	3		
11		36" X .406" WALL STEEL CASING (J&B)	LF	90		
12		16" FORCE MAIN CUT-IN	EA	1		
13		1" ARV ASS'Y IN 5' DIA MH	EA	2		
14		2" ARV ASS'Y IN 5' DIA MH	EA	4		***
15		ROAD RESTORATION	CY	70		
16	xxx-xxx	DISCRETIONARY WORK (Parrish Force Main)	And a second			\$ 72,000.00
	•	SUBTOTAL, PARRISH FORCE MAIN				
		8" DIAMETER WATER MAINS & SMALLER				
1		REMOVE 6"PVC WM	LF	143		
2		REMOVE 8" PVC WM PIPE & FITTINGS	LF	375		The state of the s
3		ADJUST VALVE BOXES TO NEW GRADE	EA	26		
4		6" PVC (C-900, DR-18) R.J. WM PIPE	LF	202		
5		8" PVC (C-900, DR-18) R.J. WM PIPE	LF	563		
6		8" DIP (CL-51) R.J. WM PIPE	LF	287		·····
7		16" X .219" WALL STEEL CASING (F&I)	LF	281		
8		16" X .219" WALL STEEL CASING (J&B)	LF	205		
9		6" GATE VALVE	EA	4		
10		8" GATE VALVE	EA	7		
11		FIRE HYDRANT ASSEMBLY RELOCATION	EA	2		
12		FIRE HYDRANT ASSEMBLY	EA	16		
13		FIRE HYDRANT ASSEMBLY W/ 90 DEGREE BEND	EA	4		

ITEM	FDOT ITEM	DESCRIPTION	UNIT	QTY	UNIT PRICE	AMOUNT
14		6" WATER MAIN CUT-IN	EA	4		
15		8" WATER MAIN CUT-IN	EA	5		
16		2" BLOW-OFF ASSEMBLY	EA	1		
17		WATER METER ADJUSTMENTS	EA	9		
18		REMOVE VALVE BOX (RISER)	EA	2		
19		PROTECT EX. 6" WATER MAIN	EA	1		
20		PROTECT EX. 8" WATER MAIN	EA	1 .		
21	XXX-XXX	DISCRETIONARY WORK (8" Diameter Water Mains & Smaller)	2 20		APPENDING	\$ 29,000.00
		SUBTOTAL, 8" DIAMETER WATER MAINS & SMALLER				
		WATER MAINS, 10" & LARGER			· · · · · · · · · · · · · · · · · · ·	
1		REMOVE 12" VALVE & BOX	EA	1		
2		REMOVE 12" PVC WM PIPE & FITTINGS	LF	1,434		
3		REMOVE EX. BLOW-OFF & CONNECT TO WM	EA	3		
4		REMOVE 20"DIP WM PIPE & FITTINGS	LF	65		
5		REMOVE 20" BUTTERFLY VALVE AND ADD PLUG TO TEE	EA	1		
6		REMOVE 24"PVC WM PIPE & FITTINGS	LF	38		
7		REMOVE STEEL CASING, ALL DIA.	LF	20		
8		REMOVE VALVE BOX (RISER)	EA	1		·
9		10" GATE VALVE	EA	1		
-10		12" GATE VALVE	EA	3		
.11		20" BUTTERFLY VALVE	EA	8		
12		20" WATER MAIN LINE STOP	EA	1		
13		12" PVC (C-900, DR-18) R.J. WM PIPE	LF	161		
14		12" DIP (CL-51) WM	LF	210		
15		20" DIP (CL-51) WATER MAIN	LF	3,619		
16		20" DIP (CL-51) R.J. WATER MAIN	LF	5,208		
17		20" DIP (CL-51) R.J. WATER MAIN W/ VITON GASKETS	LF	230		
18		24" DIP (CL-51) R.J. WATER MAIN	LF	42		
19		24" X .344" WALL STEEL CASING (J&B)	LF	234		
20		36" X .406" WALL STEEL CASING (F&I)	LF	204		
21		36" X .406" WALL STEEL CASING (J&B)	LF	55		
22		20" X 6" TAPPING SLEEVE & 6" TAPPING VALVE	EA	5		****

ITEM	FDOT ITEM	DESCRIPTION	UNIT	QTY	UNIT PRICE	АМО	UNT
23		20" X 8" TAPPING SLEEVE & 8" TAPPING VALVE	EA	1			
24		20" DIP (CL-51) PIPE X 6" TANGENTAL OUTLET	EA	4			
25		10" WATER MAIN CUT-IN	EA	1			
26	-	12" WATER MAIN CUT-IN	EA	5			
27		20" WATER MAIN CUT-IN	EA	13			
28		24" WATER MAIN CUT-IN	EA	8			
29		24" WATER MAIN TIE-IN	EA	1			
30		TYPE "C" - 20" DIP RJ WM RELOCATION (VERT. ADJ.) W/ EXISTING WM RESTRAINMENT	EA	3			
31		TYPE "E" - 20" DIP RJ WM RELOCATION (VERT. ADJ.) W/ EXISTING WM RESTRAINMENT	EA	1			
32		TYPE "F" - 20" DIP RJ WM RELOCATION (HORIZ. ADJ.) W/ EXISTING WM RESTRAINMENT	EA	2			
33		TYPE "I" - 24" DIP RJ WM RELOCATION (VERT. & HORIZ. ADJ.) W/ EXISTING WM RESTRAINMENT	EA	3			
34		PROTECT 20" PVC WM AT (CURB INLET)	EA	2			
35		RESTRAIN EXISTING 20" PIPE	LF	325			
36		RESTRAIN EXISTING 24" PIPE	LF	456			
37	XXX-XXX	DISCRETIONARY WORK (10" Diameter Water Mains & Larger)	100		Arabi Tarah	\$ 20	0,000.00
		SUBTOTAL, 10" DIAMETER WATER MAINS & LARGER					
ALTERN	ATIVE BID IT	EMS*					
12-A		20" MULTI-FLEX LINE STOP PLUGS BY PETERSEN PRODUCTS	EA	1			
12-B		20" HYDRA-STOP FOR DIP WATER MAINS BY MUNICIPAL PIPE SERVICES	EA	1			
		SUBTOTAL, UTILITIES (without Item #12-A and #12-B)				\$	-
		TOTAL (ROAD CONSTRUCTION AND UTILITIES) (without Item #12-A	and #12-0I	3)		\$	-
		TOTAL (ROAD CONSTRUCTION AND UTILITIES) (with Item #12-A)				s	-
		TOTAL (ROAD CONSTRUCTION AND UTILITIES) (with Item #12-B)				s	-

CONSTRUCTION PLANS FOR

ADDENDUM 1

200 100

THIS CONTRACT PLAN SET INCLUDES

ROADWAY PLANS SIGNING PLANS SIGNALIZATION PLANS LIGHTING PLANS CENTERLINE CONTROL SURVEY

INDEX OF ROADWAY PLANS

12-13 SUMMARY OF DRAINAGE STRUCTURES EXISTING DRAINAGE DATA SHEET TYPICAL SECTIONS SUMMARY OF PAY ITEMS

25-27 23-24 22A (A) OPTIONAL MATERIALS TABULATION PROJECT LAYOUT GENERAL NOTES US 301 PLAN

91-107 108-156 157-164 POND DETAILS DRAINAGE STRUCTURES INTERSECTION GRADING DETAILS

85-90

FT HAMER RD PROFILE

DRIVEWAY PROFILES US 301 PROFILE

165-171 214-270 172-213 ROADWAY & PONDS GEOTECHNICAL DATA DRAINAGE DETAILS

273-298 271-272 STORM WATER POLLUTION PREVENTION PLAN TRAFFIC CONTROL PLANS

BEST MANAGEMENT PRACTICES JTILITY ADJUSTMENT PLANS

٦	*
	DENOTES
	SHEETS
	SHEETS SUBMITTED
1	ŏ
	TO S.W.F.W.M.D.
-	


LENGTH OF PROJECT

	LINEAR FT.	MILES
ROADWAY	19,460.00	3.686
BRIDGES	N/A	N/A
NET LENGTH OF PROJ.	19,460.00	3.686
EXCEPTIONS	A/N	N/A
GROSS LENGTH OF PROJ.	19,460.00	3.686

US 301 (SR 43) - SEGMENT B MANATEE COUNTY (SECTION 13020) **RUTLAND ROAD (CR 675)**

PREPARED FOR WILLIAMS & HEROLD, LLC 714 MANATEE AVENUE EAST, BRADENTON, FL 34208

FDOT FINANCIAL PROJECT ID 422603-1-58-01 MANATEE CO PROJECT ID 6066760

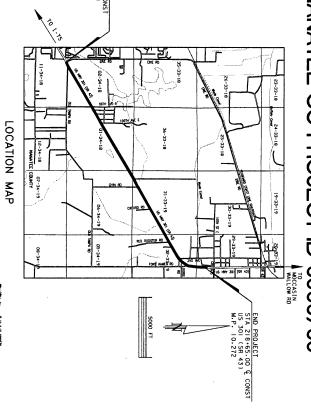

ATTENTION IS DIRECTED TO THE FACT THAT THESE PLANS MAY HAVE BEEN ALTERED IN SIZE BY REPRODUCTION. THIS MUST BE CONSIDERED WHEN OBTAINING SCALED DATA.

COVERNUM STANDARDS AND SPECIFICATIONS: FLORIDA DEPARTMENT OF TRANSPORTATION, DESIGN STANDARDS MATED 2008 AND APPLICABLE SECTIONS, ARTICLES AND SUBJECTULES OF THE AUTOMOBILE SECTIONS AND SECTIONS OF THE AUTOMOBILE SECTIONS OF THE AUTOMOBILE SECTIONS OF THE AUTOMOBILE SECTIONS OF THE AUTOMOBILE SECTION OF

FOR DESIGN STANDARDS MODIFICATIONS CLICK ON "DESIGN STANDARDS" AT THE FOLLOWING WEB SITE: http://www.dot.state.fl.us/rddesign/ APPLICABLE DESIGN STANDARDS MODIFICATIONS: 07-01-08

ROADWAY PLANS
ENGINEER OF RECORD:
MITCHELL D. McKNIGHT, P.E. DATE P.E. NO.: 41444

UTILITY PLANS ENGINEER OF RECORD: ROBERT J. HALBACH, P.E. P.E. NO.: 51601 P.E. NO.: 40139


900 Professional Purtury East, Safe 100 - Survacia, Florica 9240-4444 - Phone 947-4500 - Fax 947-9570 - Web Site Invasibian Medican FINAL PLANS-NOVEMBER, 2008


Planners - Engineers - Ecologists - Surveyors - Landscape Architects - Transportation Consultants

WilsonWiller, Inc.

VilsônMiller

RETURNS TO LEGG. PROJECT MARKET. (1935) - 1000-000 PROJECT MARKET. (1935)	05925-000-0	Putter	TOTAL THE SOUTH TOTAL SOUTH SOUTH STATE SOUTH SOUTH STATE SOUTH SO	US 301 - SEGMENT B	-	PHECHANIES - PARAME, FINAL SALES - PROVINCES - PARAMETERS - PARAMETERS - PARAMETERS - PROVINCES - PARAMETERS	- Barusel, Florin, 5668	'estany But, Ada III	DATE: BROWN P / DR. NO. OCCUPA P / DR. NO. NAT. APPROVED BY: DRAW P /		RY NO. RYSSON AUGENOUS T
FLORIDA LIC. NO. 41444 ACCX NAMES: D-05925-000-000XXX	PAY ITEMS	RY OF			PROJECT:	Total William Company of the Company		Tener - Dylant			
MITCHELL D. MCKNIGHT, P.E.		1	5/07 ITLE:	WILLIAMS & HEROLD ILC	CLIENT:	VilotaMiller			ACTIVITY MITHAS/CIDE, NO. DATE DESIGNED BY:		
	3,030	ТF		UNDERDRAIN, TYPE V	440-1-50			EA	INLETS, CURB, TYPE J-6, <10'	425-1-461	
	6	EA	AL / ARCH, 24 SD "	MITERED END SECT, OPTIONAL - ELLIPTICAL / ARCH, 24 SD."	430-984-629	38		EA	INLETS, CURB, TYPE P-6, <10'	425-1-361	
	ω	EA	'AL / ARCH, 18 SD "	MITERED END SECT, OPTIONAL - ELLIPTICAL / ARCH, 18 SD "	430-984-625	1		EA	INLETS, CURB, TYPE J-5, >10'	425-1-452	
	2	EA	ID, 60 SD *	MITERED END SECTION, OPTIONAL ROUND, 60 SD *	430-984-143	2		EA	INLETS, CURB, TYPE J-5, <10'	425-1-451	
	и	ΕA	ID, 48 SD *	MITERED END SECTION, OPTIONAL ROUND, 48 SD."	430-984-141	ы		EA	INLETS, CURB, TYPE P-5, PARTIAL	425-1-355	
	2	EA	D, 24 SD "	MITERED END SECTION, OPTIONAL ROUND, 24 SD "	430-984-129			EA	INLETS, CURB, TYPE P-5, >10'	425-1-352	
	ы	EA	D, 18 SD "	MITERED END SECTION, OPTIONAL ROUND, 18 SD."	430-984-125	53		EA	INLETS, CURB, TYPE P-5, <10°	425-1-351	
	_	EA	D, 72 CD "	MITERED END SECTION, OPTIONAL ROUND, 72 CD "	430-982-145	63		CY	CONCRETE CLASS I ENDWALLS	400-1-2	
	4	EA	D, 24 CD "	MITERED END SECTION, OPTIONAL ROUND, 24 CD "	430-982-129	8		CY	CONCRETE PAD AROUNG POLES & PULL BOXES	400-1-15	
	301	뷰	- ELIP / ARCH, 37-48SS "	PIPE CULV, OPTIONAL MATERIAL, OTHER - ELIP / ARCH, 37-48SS."	430-175-203	222	2	CY	CONCRETE CLASS I, RETAINING WALLS	400-1-11	
	800	LF	- ELIP / ARCH, 25-36SS "	PIPE CULV, OPTIONAL MATERIAL, OTHER - ELIP / ARCH, 25-36SS "	430-175-202	83	9,583	TN	ASPHALT CONCRETE FRICTION COURSE, FC-9.5 (RUBBER) (1")	△ 337-7-32	2
	4,228	LF.	- ELIP / ARCH, 0-24SS "	PIPE CULV, OPTIONAL MATERIAL, OTHER - ELIP / ARCH, 0-24SS "	430-175-201	35	23,035	Ŋ	SUPERPAVE ASPHALTIC CONC, TRAFFIC C	△ 334-1-13	. 2
	224	LF.	IND - SHAPE, 61" OR	PIPE CULVERT OPTIONAL MATERIAL, ROUI GREATER STORM SEWER	430-175-105	#	5,348	SY	MILLING EXIST ASPH PAVT, I" AVG DEPTH	A 327-70-1	4
	3,181	LF	ND - SHAPE, 49-60"	PIPE CULVERT OPTIONAL MATERIAL, ROUND - SHAPE, 49-60" STORM SEWER	430-175-104	75	198,875	SY	OPTIONAL BASE, BASE GROUP 09	285-709	
	4,238	FF.	ND - SHAPE, 37-48"	PIPE CULVERT OPTIONAL MATERIAL, ROUND - SHAPE, 37-48" STORM SEWER	430-175-103	74	2,274	SY	OPTIONAL BASE, BASE GROUP 01	285-701	
	8,539	LF.	ND - SHAPE, 25-36"	PIPE CULVERT OPTIONAL MATERIAL, ROUND - SHAPE, 25-36" STORM SEWER	430-175-102	X	225,204	SY	TYPE B STABILIZATION	160-4	
	13,229	H	IND - SHAPE, 0-24"STORM	PIPE CULVERT OPTIONAL MATERIAL, ROUND - SHAPE, 0-24" STORM SEWER	430-175-101	55	98,755	CY	EMBANKMENT	120-6	
	2	EA		WEIR	1-06-57	96	1,000	CY	SUBSOIL EXCAVATION	120-4	
	7	EA		MANHOLES, J-8, >10'	425-2-92	8	68,886	CX	REGULAR EXCAVATION	120-1	
	ы	EA ·		MANHOLES, J-8, <10'	425-2-91	15		EA	MAILBOX, F&I SINGLE	110-7-1	
	11	EA		MANHOLES, J-7, >10'	425-2-72	ጃ	2,834	SY	REMOVAL OF EXISTING CONCRETE PAVEMENT	110-4	
	38	EA		MANHOLES, J-7, <10'	425-2-71	н]		rs.	CLEARING & GRUBBING	110-1-1	
	9	EA		MANHOLES, P-8, <10'	425-2-61	730	7.	DA	FIELD OFFICE, 1200 SQ FT	109-71-4	
	1	EA		MANHOLES, P-7, PARTIAL	425-2-43	8	1,500	EA	ROCK BAG	104-16	
	20	EA		MANHOLES, P-7, <10'	425-2-41	5		EA	SOIL TRACKING PREVENTION DEVICE	104-15	
	6	EA		INLETS, SPECIAL, >10'	425-1-902	51	67,061	뚜	STAKED SILT FENCE, TYPE III	104-13-1	
	20	EA		INLETS, SPECIAL, <10'	425-1-901	938	9.	TF.	FLOATING TURBIDITY BARRIER	104-11	
	2	EA		INLETS, DITCH BOTTOM, TYPE D, PARTIAL	425-1-545	88	6,680	뉴	SYNTHETIC BALES	104-10-2	
	2	EA	O	INLETS, DITCH BOTTOM, TYPE D, J BOT, >10	425-1-544	365	ىي	E	CHANGEABLE VARIABLE MESSAGE SIGN - TEMPORARY	102-99	
	13	EA	Q	INLETS, DITCH BOTTOM, TYPE D, J BOT, <10°	425-1-543	160	_	MH	TRAFFIC CONTROL OFFICER	102-14	
	_	EA		INLETS, DT BOT, TYPE D, >10'	425-1-542	922	٠	Ç	COMMERCIAL MATERIAL FOR DRIVEWAY MAINTENANCE	102-3	
	45	EA		INLETS, DT BOT, TYPED, <10'	425-1-541	<u></u>		rs.	MAINTENANCE OF TRAFFIC	102-1	
	3	EA		INLETS, CURB, TYPE J-6, >10'	425-1-462	<u></u>		LS	MOBILIZATION	101-1	
ADDENDUM 1	QTY	TINU		DESCRIPTION	FDOT ITEM		QTY	UNIT	DESCRIPTION	FDOT	

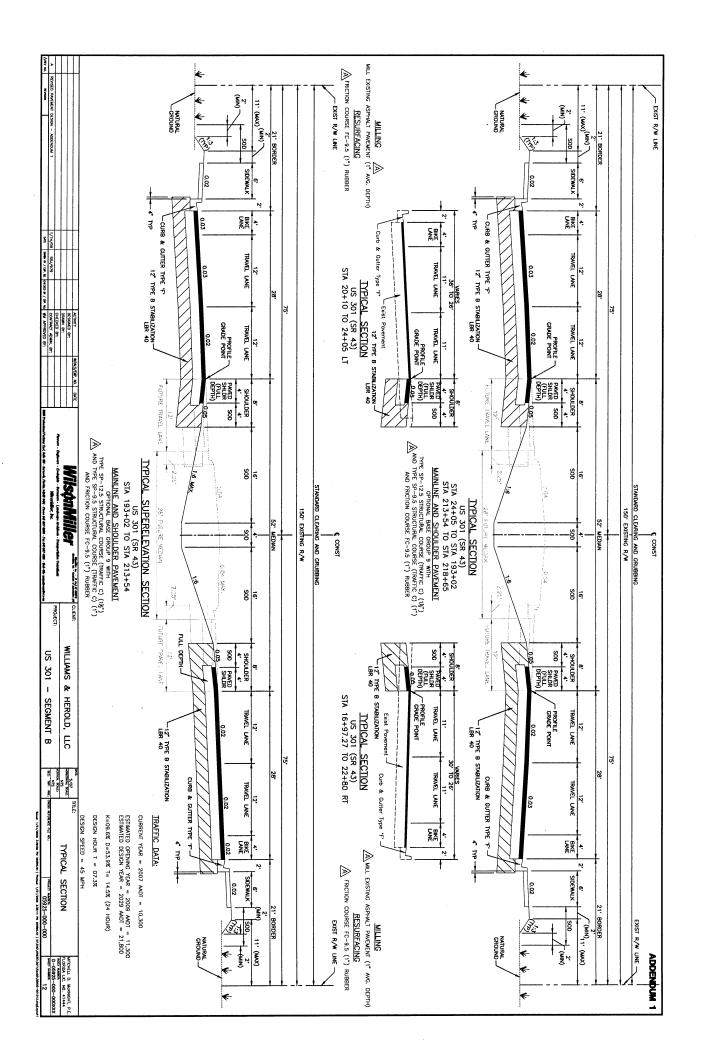

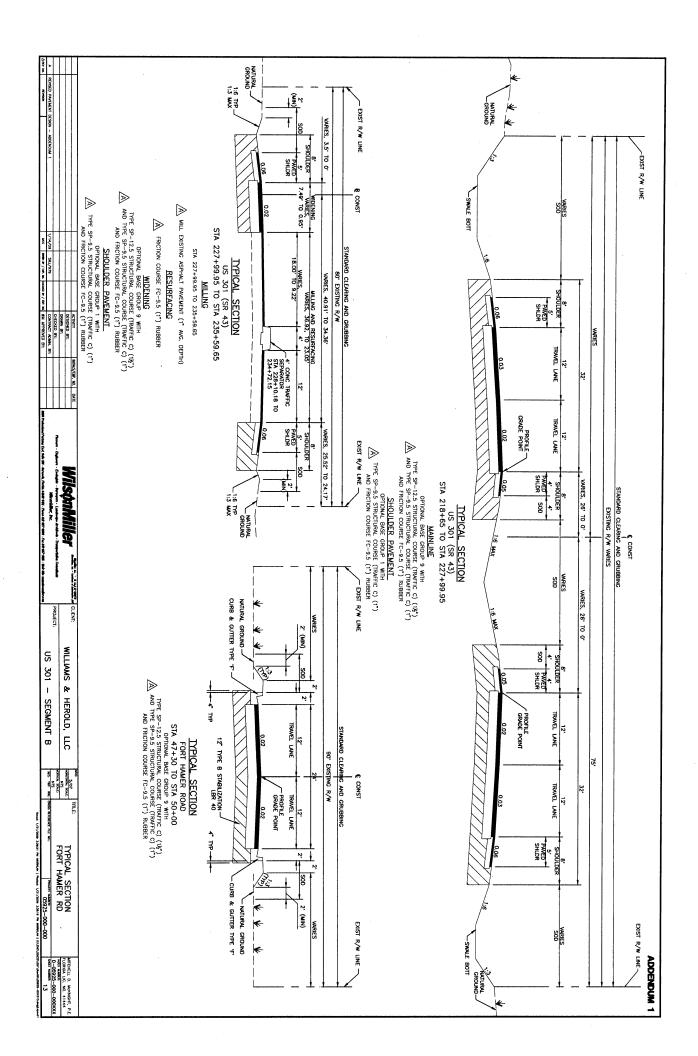

GENERAL NOTES

- 1. THE CONTRACTOR MAY USE ANY OF THE OPTIONAL PIPE MATERIALS TABULATED FOR A GIVEN STRUCTURE. ONLY THE MATERIAL OPTIONS TABULATED FOR A GIVEN STRUCTURE CAN BE USED.
- 2. ADJUSTMENT TO THE BID QUANTITIES, PROCES AND PAYMENT WILL NOT BE ALLOWED DELTO INFORMATION OF CONSTRUCTION RECESSANCE IN STRUCTURES SEE, SHAPE, LENGTH, WIDTH, DEFIN OF ACCESSORY CONSTRUCTION RECESSANCE TO ACCOUNTED THE WILL BE NO ADDED OR REDUCE AUTERNAL OTHER THAN THE "PLOTTED" OPTION, LICKWISE, THERE WILL BE NO ADDED OR REDUCE WILL OTHER OTHER WILL BE NO ADDED OR REDUCE WILL SHOW OTHER OTHER OTHER WILL BE NO ADDED OR REDUCE WILL SHOW OTHER OTHER OTHER OTHER WILL BE NO ADDED OR REDUCE WILL SHOW OTHER OTHER
- 4. IF ADJUSTMENTS ARE REQUIRED DUE TO PLAN TRROPS OR OMISSIONS OR AUTHORIZED FIELD CHANGES, THE "DOTTER" AMERIKA, AND NOT THE MATERIAL ELECTED BY THE CONTRACTOR WOULD BE USED TO ESTABLISH NEW PAY QUANTIES.
- 5. THE CONTRACTOR SHALL NOTIFY THE DEPARTMENT IN WRITING AS TO WHICH OPTIONAL PIPE MATERALS HE CHOOSES TO USE AT THE PRECONSTRUCTION CONFERENCE, ONCE DENTIFIED THE CONTRACTOR MAY NOT CHANGE PIPE MATERIAL SELECTED WITHOUT THE APPROVAL OF THE ENGINEER.
- PIPE SHAPES OTHER THAN ROUND (ELLIPTICAL/ARCH) ARE SUMMARIZED AND PAID FOR USING EQUIVALENT ROUND PIPE DIAMETER.
- 7. HOPE CLASS II IS UNDER INTERII ACCEPTANCE AND SHOULD NOT BE USED UNDER LIMITED ACCESS FACILITIES, IN THE FLORIDA KETS, OR ON CERTAIN CRITICAL ROUDWIN'S AS DIRECTED BY THE INSTRUCT DRAINANCE EMBREER.

STRUCTURE SIZE (NICHES)	204 006 007 008 1115 81	74 ST	Ш	PO HEG	30 81	10.0	2	36 ST	10 c		42 SIE	48 Sit	54 STE	90 SIE	共	TO SIE	U.	8 8	8 8 8	5 8 8 3	72 16.25 19.30 26.45 36.55
MATERIAL	STEEL JERNYORGED CONCRETE PIPE (RICP) CLASS II NON-REINFORGED CONCRETE (PIRCP) TO GA CORRIGATED ALLINAILMI (CAPISRAP) POLYVINI CHICARDE (PICQ, ASTIN E 949 HIGH DENSITY POLYETHY LEHE (HDPE), CLASS II	EL BENEORGED CONCRETE PIDE (BOD) CLASS II	NON-REINFORCED CONCRETE (NICP) 10 GA CORRUGATED ALUMINUM (CAPISRAP)	POLYVINYL CHLORIDE (PVC), ASTM F.949 HIGH DENSITY POLYETHY LENE (HDPE), CLASS II	STEEL-REINFORCED CONCRETE PIPE (RCP), CLASS II	NOTE SEEM ON COLOR OF THE CARCE) 10 GA. CORRUGATED ALUMINUM (CAPISRAP) 20 YUMAY THE COLOR OF A SEEM E BAS	HIGH DENSITY POLYETHY LENE (HDPE), CLASS II	STEEL-REINFORGED CONCRETE PIPE (RCP), CLASS II	10 GA CORRUGATED ALUMINUM (CAPISRAP) POLYVINYL CHLORIDE (PVC) ASTM F-949	HIGH DENSITY POLYETHY LENE (HDPE), CLASS II	STEEL REINFORCED CONCRETE PIPE (RCP.), CLASS II 10 GA. CORRUGATED ALUMINUM (CAPISRAP) HIGH DENSITY POLYETHY LENE (HDPE), CLASS II	STEEL REINFORCED CONCRETE PIPE (RCP), CLASS II 10 GA, CORRUGATED ALLIMNUM (CAPISRAP)	HIGH DENSITY POLYETHY LENE (HDPE), CLASS II	HIGH DENSTY POLYETHY LENE (HDPE), CLASS II STEEL HERNORGED CONCRETE PIPE (HCP), CLASS II 10 GA, CORRUGATED ALLMANIM (CAPSIAP) 146H DENSTY POLYETHY LENE (HDPE), CLASS II	HIGH DENSITY POLYETHY LENE POPED, CLASS II STELL REINPORCED CONNORTE PIPE (RCP), CLASS II STELL REINPORCED CONNORTE PIPE (RCP), CLASS II STELL REINFORMED DOMNORTE PIPE (RCP), CLASS II STELL REINFORMED DOMNORTE PIPE (RCP), CLASS II HIGH DENSITY POLYETHY LENE (RGP) CLASS II	HIGH DENSITY POLYETHY LENE POPED, CLASS II STEEL, REMPORCED CONCRETE PIPE (RCP), CLASS II WHIGH DENSITY POLYETHY LENE (ROPE), CLASS II STEEL REMPORCED CONCRETE PIPE (RCP), CLASS II	HIGH DE MENT POUVETHY LENE PODES; CLÁSS II STELL REMINORED CONVOETE PRE (RCP) CLASS II TO CAL CORRIGATOR LUMINUM (CAP STADE) HIGH DE MENT POLYTETHY LENE (ROPE), CLASS II WIGH DE MENT POLYTETHY LENE (ROPE), CLASS II WIGH DE MENT POLYTETHY LENE (ROPE), CLASS II WIGH DE MENT POLYTETHY LENE (ROPE), CLASS II STELL REMINORED CONVOETE PRE (ERCP), CLASS II STELL REMINORED CONVOETE PRE (ERCP), CLASS II TO CAL CORRIGATED ALLIMINUM (CAP STADE)	HIGH DE HISTY POLYETHY LENE (PÓPE), CLÁSS II STELL REINFORCED CONCRETE PPE (RCP), CLÁSS II TO GA, CORRIGATED ALMANIMA (ZAPSKAP) HIGH DE HISTY POLYETHY LENE (HPOPE), CLÁSS II STELL REINFORCED CONCRETE PPE (RCP), CLÁSS II TO GA, CORRIGATED ALMANIMA (CAPSKAP), CLÁSS II TO GA, CORRIGATED ALMANIMA (CAPSKAP), CLÁSS II TO GA, CORRIGATED ALMANIMA (CAPSKAP)	HIGH DENSITY POLYREMY LENE PIONE), CLÁSSII STELL ABBRORGED CONVASTE PIOE (RCP), CLASSII 10 CA. CORRIGATED ALLIANINI (CAP SIGNO) HIGH DENSITY POLYREMY LENE (ROPE), CLASSII NO LENSITY POLYREMY LENE (ROPE), CLASSII STELL ABBRORGED CONVASTE PIOE (RCP), CLASSII STELL ABBRORGED CONVASTE PIOE (RCP), CLASSII 10 CA. CORRIGATED ALLIANINI, (CAP SIGNO) 10 CARGO CAPITED ALLIANINI, (CAP SIGNO) 11 CARGO CAPITED ALLIANINI, (CAP SIGNO) 12 CARGO CAPITED ALLIANINI, (CAP SIGNO) 13 CARGO CAPITED ALLIANINI, (CAP SIGNO) 14 CARGO CAPITED ALLIANINI, (CAP SIGNO) 15 CARGO CAPITED ALLIANINI, (CAP SIGNO) 16 CARGO CAPITED ALLIANINI, (CAP SIGNO) 17 CARGO CAPITED ALLIANINI, (CAP SIGNO) 18 CARGO CAPITED ALLIANININI, (CAP SIGNO) 18 CARGO CAPITED ALLIANINININI, (CAP SIGNO)	HIGH DENSITY POLYETHY LENE PODES, CLASS II TO THE ARRIPOPOZED CONNECTE PIPE (RCP) CLASS II TO THE CORRESPONDED CONNECTE PIPE (RCP) CLASS II STELL REINFORCED CONNECTE PIPE (RCP) CLASS II STELL REINFORCED CONNECTE PIPE (RCP) CLASS II STELL REINFORCED CONNECTE PIPE (RCP) CLASS II TO CANDERSONDED CONNECTE PIPE (RCP) CLASS II TO CANDERSONDE	HIGH DENSITY POLYETHY LENE (PÓPE), CLÁSS II STEL, REINFORCED CONCRETE PIE (ROP), CLÁSS II TO COCRRIGATED CONCRETE PIE (ROP), CLÁSS II STEL REINFORCED CONCRE
РІОПЕВ	×	Υ	,		×			×			×	· · ·		×	×	× × × >	××××	x x x x x	* * * * * *	× × × × × ×	× × × × × × ×
AS BUILT																					
REMARKS	TYPICAL DRY CAST ONLY IN CLEAN BACKFILL SEE NOTE 7	TYPICAL DOV CAST	ONLY IN CLEAN BACKFILL	SEE NOTE 7	TYPICAL DRY CAST	ONLY IN CLEAN BACKFILL	SEE NOTE 7	TYPICAL DRY CAST	ONLY IN CLEAN BACKFILL	SEE NOTE 7	TYPICAL DRY CAST ONLY IN CLEAN BACKFILL SEE NOTE 7	TYPICAL DRY CAST	SEE NOTE 7	SEE NOTE 7 TYPICAL DRY CAST ONLY IN GLEAN BACKFILL SEE NOTE 7	RY CAST FAN BACKFILL T RY CAST	RY CAST 7 RY CAST 7 RY CAST 7 RY CAST 7 RY CAST	RY CAST				

05925-000-000		٠	מט טטו – טרמשבועו נ	-	SEED Professional Partitary Clark, Robe SEE - Surrawit, Florida SAED - 894 - Flores 647-4525 - Flore 647-4525 - Flore 647-4525 - SEED -		WIM APPROVED BY:	DATE DIMEN BY / LIP. NO. OCCURD BY / CIP. NO. WIM APPROVED BY	8	ARCY NO. REVISION
D-05925-	NIS NIS CONTRACTOR OF THE PERSON NIS		115 301 _ SE	T. COLLOI.	Hitoridies, Inc.		CONTRACT ADMIN. BY:	/09 MRK/2473	ADDENDUM 1	A SHEET ADDED - ADDENDUM 1
IABULATION		NOT.		PBO IECT.	Planuer - Bylhaers - Endeptie - Parrejeer - Landrogo Arabbad - Presportatio Consedeste		CHECKED BY:			
	NTS .		10 miles				DRAWN BY:			
OPTIONAL MATERIALS			WILLIAMS & HEROLD IIO				DESIGNED BY:			
	3706	DATE		CLENT	District CLIENT	TIMES/EMP. NO. DATE	ACTIVITY			

	SEGMENT B		HEROLD, LLC
	20 70 100	NUS ACMICA ROND	NLZ HONTONEM SCATE
medefiles/ccol.co-scrop/sown/cot/scrop/ard/sr interior in a start soot/12/1 amina interior na system soot/12/1 amin	RC: Ten. RC: CHOCK RETRICKE FLE NO: PROJECT MARKET. 05925-000-000		RALS
25\001\8+06\01825-001022\degl.oped	Secti Numbers 22A	D-05925-000-000XXX	FLORIDA LIC. NO. 41444

CONSTRUCTION RESTRICTIONS FOR BALD EAGLE

- THE PROJECT EXISTS IN AM AREA POTENTIALLY UTILIZED BY MESTING BALD EAGLES. A RECEW OF INFORMATION FOUND ON THE FLORDAN FISH AND WILDLIFE CONSERVATION COMMISSION WEB SITE https://mid.twc.sigle.flub/eagle/eaglenests/2 MAY NOTICNTE EAGLE NESTS.
- THE COMPACTOR MUST HAVE A QUALIFED BIOLOGY APPROVED BY FIDOT LOCATE ANY ACTIVE MEST SITE(S) THAN HAY EAST, IN THE PROLECT INCOMITY, PRIOR TO COMMENCEMENT OF AND THROUGHOUT THE DURATION OF ANY CONSTRUCTION.
- 3. NO CONSTRUCTION ACTIVITES WILL OCCUP DURING THE NESTING SEASON WITHIN THE O' TO 200 FEFTER OF ANY NEST LOCATIONS, CONSTRUCTION BETWEEN THE 3.30° AND 660° BUFFER WILL EITHER OCCUR OUTSIDE OF NESTING SEASON OR A QUALIFIED BOLOGEST, APERBOYED FOR PROTE, BY THE OUTSING SEASON CHARLES OF THE OUTSING SEASON CHARLES OUTSING SEASON C
- . IF THE CONTRACTOR DESIRES TO MODIFY THE ABOVE CONDITION IN ANY WAY, IT IS THE CONTRACTOR'S RESPONSIBILITY TO COORDINATE WITH THE FOOT CONSTRUCTION PROJECT MANAGER PRORF TO INITIATION OF COORDINATION WITH THE LUS. FISH AND WILDLER SERVICE AND RECEIVE WRITTEN CONFIRMATION OF ANY MODIFICATIONS TO THESE BALD EACH RESTRICTIONS, IT WILL BE THE CONTRACTOR'S RESPONSIBILITY TO PERFORM ANY MONITORING OR OTHER ACTIVITIES REQUIRED BY THE ACENCY AT THEIR OWN EXPENSE.
- 5. THE CONTRACTOR SHALL INCLUDE ALL COSTS ASSOCIATED WITH CONSTRUCTION SEQUENCING TO ANDIO ACTIVE REST SITES AND MONITORING OF NEST SITES UNDER PAY ITEM NO. 110-1-1, CLEARNG AND GROBBING (1.5).
- A 196. CONTRACTOR. IN COORDINATION WITH THE FROY CONSTRUCTION PROJECT MANDER, SHALL ASD SE RESPONSIBLE FOR DEPLOYING AND CARRYING OUT MY MANGERIANT PLANS/) AGRECIATION STEEDERS. THE PROPERTY RECOLUTION ACROICES DUE TO THE COURTENCE OF UNEXPECTION STEEDERS OF STEEDERS AND STEEDERS OF STEEDERS AND STEEDERS OF STEEDERS

CONSTRUCTION PRECAUTIONS FOR THE FLORIDA SANDHILL CRANE

- THE PROJECT EXISTS IN AN AREA POTENTIALLY UTILIZED BY NESTING SANDHILL GRANES. THE CONTRACTOR MUST HAVE A QUALIFIED BIOLOGIST, APPROVED BY MANIECT CUMITY, TO LOCATE ANY ACTIVE SANDHLL CRAVE HERE(S), WITHIN THE PROJECT LIMITS PRIOR TO COMMENCEMENT OF AND THROUGHOUT THE DURATION OF ANY CONSTRUCTION.
- SUPPLYS FOR ACTIVE SANDHILL CRAME MESTS SHOULD OCCUR NO SOUNCE THAN TWO WEEKS BEFORE AUMINAY AND CONINET PROFUNCION THE MESTING SUSCIAL AND SIETEMANDED BY THE QUALIFIED BROCKET, THIS SURVEY PROFUNCIAL SHOULD BE MPELEMENTED THROUGHOUT THE LIFE OF THE CONSTRUCTION PROFUEL WHEN CONSTRUCTION ACTIVITIES WILL OCCUR DURING THE SANDHILL OCCUR DURING THE SANDHILL OCCUR DURING THE
- 2. NO CONSTRUCTION IS TO OCCUR WITHIN 400 FEET OF THE SANDHLL CRAME NEST(S) OCATION DENGED THE MINI AND SUBSEQUENT NESTING SECONS (MANARY THROUGH JULY). IF AN ACTIVE CRAME NEST(S) IS LOCATED WITHIN 400 FEET OF THE PROJECT LIMIS, THE CONTROL THE FLOREDA FISH AND WILLIEF CONSTRUCTION CONSUMERY THE ANALYTE COUNTROL CONSUMERY THE MANAGES SHALL COPINGT THE FLOREDA FISH AND WILLIEFS WITHIN 400 FEET OF THE NEST SHALL CRASS (MILL) PERFORM IS RECEIVED FROM THE MANARE COUNTY CONSTRUCTION PROJECT MANAGES. IT WILL BE THE CONTROLTON CONSTRUCTION AND MINISTRUCTION OR TOWN FLORED STANDARD MAN ADDITIONAL MONITORING OR OTHER ACTIVITIES RECOURED BY THE WILLDIFF AGENCY AT THEIR OWN EXPENSE.
- THE CONTRACTOR SHALL INCLUDE ALL COSTS ASSOCIATED WITH CONSTRUCTION SCOUENCING TO ANDID ACTION EAST SITES AND MONITORING OF NEST SITES UNDER PAY ITEM NO. 110-1-1, CLEARING AND GRUBBING (LS).
- A THE CONTRACTOR, IN COODMINION WITH THE MANNEE COUNTY CONSTRUCTION PROJECT MANGER, SHALL ALSO BE RESPONSIBLE FOR DEPLICIPING AND CARRYING DUT ANY MANGER, SHALL ALSO BE RESPONSIBLE FOR DEPLICIPING AND CARRYING DUT ANY MANGER SHALL ALSO BE RESPONSIBLE FOR DEPLICIPING AND CARRYING DUT ANY COUNTRICTOR OF THE COUNTRACTION OF THE PROJECT DEPLICES AND FACELY AND CHARTER POLICIFIED SPECES AND FACELY AFFECT OR SECONDALIZE HE SPECES IN ACCORDANCE WITH THE ENDANGERED SPECIES ACT. THE CONTRACTION, IN COORDINATION WITH THE MANGER COUNTRICTION STORES AND CONTRACTION OF THE SHAMMER COUNTRICTION OF THE SHAMMER COUNTRICTION OF THE SHAMMER SHALL ALSO BE RESPONSIBLE FOR MANKER ANY MODIFICATIONS TO THE PROJECT MANGER, SHALL ALSO BE RESPONSIBLE FOR MANKER ANY MODIFICATIONS TO THE PROJECT MANGER, SHALL ALSO BE RESPONSIBLE FOR MANKER ANY MODIFICATIONS TO THE PROJECT MANGER, SHALL ALSO BE RESPONSIBLE FOR MANKER ANY MODIFICATIONS TO THE PROJECT MANGER, SHALL ALSO BE RESPONSIBLE FOR MANKER ANY MODIFICATIONS TO THE PROJECT MANGER SHALL ALSO BE RESPONSIBLE FOR MANKER ANY MODIFICATIONS TO THE PROJECT MANGER SHALL ALSO BE RESPONSIBLE FOR MANKER ANY MODIFICATIONS. TO THE PROJECT MANGER SHALL ALSO BE RESPONSIBLE FOR MANKER ANY MODIFICATIONS. TO THE PROJECT MANGER SHALL ALSO BE RESPONSIBLE FOR MANKER ANY MODIFICATIONS. TO THE PROJECT MANGER SHALL ALSO BE RESPONSIBLE FOR MANKER ANY MODIFICATIONS. THE MANGER SHALL AND THE MANG

CONSTRUCTION PRECAUTIONS FOR THE EASTERN INDIGO SNAKE

- THE EASTERN NUMBO SNAME (DRYMARCHON CORAIS COUPER) COULD BE PRESENT IN THE PROJECT AREA. IN ORDER TO INMINIZE HEAD TO THIS SPECIES, THE FOOT HAS COMMITTED IMPLEMENT THE FOLLOWING PROTECTION MEASURES:
- . A PROVIDE EASTERN INDICO SNAKE EDUCATIONAL INFORMATION TO EMPLOYEES PRIOR TO THE INITIATION OF ANY CLEARING OR CONSTRUCTION ACTIVITIES. AN EDUCATIONAL EXHIBIT THAT HAS BEEN APPROVED BY USPAYS SHALL BE POSTED CONSPICUOUSLY A A SITE ACCESSBLE TO ALL EMPLOYEES AND A HANDOUT WILL BE DISTRIBUTED TO EMPLOYEES.
- B. THE CONTRACTOR SWALL POST AND DISTRIBUTE EDUCATIONAL INCREMATION TO ALL ITS WORKERS, THE EXHBERT AND BROCHMESS SWALL INCLUDE PROJOGRAPHS OF THE EXPERIEN INDIGO SWAKE, INFORMATION ON LIFE. HISTORY, AND LECAL PROTECTION OF THE SPECIES IN FLORMA, AND HOW TO ANDID IMPACTS TO THE SPECIES, THIS WATERIAL SWALL BE SUPPLIED TO THE CONTRACTOR BY THE CONSTRUCTION EMPROHMENTAL LIMISON AT THE PRE-CONSTRUCTION CONFERENCE.
- ALSO BE RESPONSIBLE FOR DESCRIPTION WITH THE FROM CONSTRUCTION PROJECT MANAGER, SHALL ALSO BE RESPONSIBLE FOR DESCRIPTION AND CARRYING OUT MY MANAGER WITH PARAMETER PROJECTS AND THE TOTAL COURTERONE OF HAVEN PROJECTS SHOULD HAVE PROJECTS OF SECIES AND THE RECOLLATION OF THE PROJECTS HOT MENTIONED ABOVE THAT ARE DESIDIED DURING THE CONSTRUCTION OF THE PROJECT OF MEDIANCE HE PRE-CONSTRUCTION SHOULD ALLOW FOR CONSTRUCTION SHOWS. THE AMAGEMENT PANASS/MERECT OR SUSPANDEZ THE SECIES IN ACCORDANCE WITH THE ENHANCERS SECIES AND CONTRACTOR, IN COORDINATION WITH THE FORD CONSTRUCTION PROJECT MANAGER, SHALL ALSO BE RESPONSIBLE FOR MANAGE AN MANAGE AND MODERATIONS TO THE PRODUCTS IN COORDINATION WITH THE FORD CONSTRUCTION PANASS/MODERATION OF THE PRODUCTS OF THE PROPOSED OF THE PROPO

GENERAL NOTE CONCERNING CONTAMINATION:

- CONTRACTOR SHOULD BE AWARE OF POSSIBLE CONTAMINATION AS NOTED ON PLAN SHEETS.

 THE MARKED RACS AGE ESTIMATED, AND COULD MARY IN SIZE FROM WHAT IS SHOWN.
 CONTAMINATED MATERAL (INCLUDING GROUNDWATER) WILL BE DISPOSED OF BY OTHERS AS IT IS
 ENCLUMITERED DIMINIC CONSTRUCTION. CONTRACTOR SHALL COORDINATE SO-DEFDULE OF
 CONSTRUCTION ACTIVITIES WITH MANATEE COUNTY'S ASSESSMENT/REMEDIATION CONTRACTOR.
- CONTRACTOR SHALL PROVIDE AN AREA (OR AREAS) FOR TEMPORARY (2-4 WEEKS PER STIE)
 STOCKPUING OF CONTMINIATED SOIL. THE STOCKPIE AREA(S) SHALL BE WINHIN THE PROJECT
 LIMITS. ASSESSMENT/REMEMBRIAND CONTRACTOR WILL REPORT THE EXCANATED SOIL WITH
 SUIPABLE CLEM MATERIAL, BACKFILLING TO PRE-EXCANATION ELEMITONS (DIVLESS OTHERWISE
 DIRECTED BY THE EXONERSE). IF THERE IS SUITABLE EXCESS MATERIAL ON THE PROJECT, IT
 SHALL BE ANAILABLE FOR THESE BACKFILLING OPERATIONS.
- IF DEWLERING IS REQUIRED, CONTRACTOR SHALL PROVIDE JAEK(S) TO ACCOMMONATE ONE OR MORE LARGE, WHITE TREATMENT APPRAINTING TYPICALLY A 50 UNMETER HOUNDE POOL, CARRON, CRLIS, MUDINTID ON A FURIED TRUILER, AND A MOBILE LARDORANDRY, TREES JAEKES SHALL BE AS JOZEN AS POSSIBLE TO THE DEWLERING DEPOSTROM AND IN MO CASE SHALL THEY DE OUTSIDE THE PROLECT LIMITS (UNILESS DIRECTED BY THE PROLECT EMBLER). IT IS POSSIBLE THAT THE CONFIDENCIN OF THE TREATMENT APPARAITIS MAY BE ALTERED (LONGER AND MARGORIES) BASED UPON SITE CONDITIONS.
- CONTRACTOR SHALL COORDINATE WITH ASSESSMEN/FEREIDATION CONTRACTOR IN SETTING UP DEWLERING (APPRAINTS TO ANDID DEWLERING CONTAMINATED JAECAS, ALTON HIT CONTRACTOR WISHES TO DEWLER A CONTAMINATED JAECAS, IF THE CONTRACTOR WISHES TO DEWLER A CONTAMINATED JAECAS, WISHES AND ADMICTATION OF THE FERDINE TO USE SEPARATE HEADER SECTION(S) AND ADDITIONAL PUMPS TO KEEP DISCHARGE(S) SEPARATE.
- S. ALL OF THE ABOVE CONDITIONS AND REQUIREMENTS SHALL PERTAIN 10 ALL UTILITY WORK.
 INCLUEDS IN, ASSOCIATED WITH, OR AFFECTED BY THE PROJECT, THEY SHALL ALSO PERTAIN
 TO ANY CONTAMINATED AREAS DISCOVERED AFTER PREPARATION OF THESE PLANS.
- all costs related to the requirements of this general note shall be included in the various related bid items (pipe, excavation, etc.).

	DATE DESIGN TO JUSTIC DE IND WAL APPROVED BY: date Principles (Particle State State Control of Particle State State State Control of Particle State St		CHECKED BY: Tanner - Biffurer - Endpair - Landruge Andread - Temperishin Charles - PROJECT:			ACTIVITY BINESCOPE NO. DATE
	OF CAMETAL O	IN TOT I SECMENT R		ט פר יובויסרט, רדס	WILLIAMS & HEROLD IIO	
	_	MIC THE MIC COOR MUTUALIST FLE	OWER TOWN	NS.	3/0/	III
Sensit 1/21/2008 3/28-56 PM MICROWN PMILLE 1/21/2008 3/28/58 MI MODRICAN Z/CHC/CSEZS/CD1/AmicR/CSEZS-CD104-Ampliament	-	S NOTIFICAL FLE NO:		GENERAL NOTES		
1/21/2009 3/26/26 PM RESERVE STANDAYOL	5925-000-000					