

VERIFY SCALES: BAR IS ONE INCH ON ORIGINAL DRAWING 0 1 IF NOT ONE INCH ON THIS SHEET, ADJUST SCALE ACCORDINGLY

PLOTTED June 8, 2010 9:09 AM PLOTTED BY: SCHEUERMAN, JAMES
X:\MANATEE PROJECTS\12007391 TARA # 20 MASTER LIFT STATION - W44\CADD\G-1 COVER SHEET.DWG




MANATEE COUNTY, FLORIDA

IMPROVEMENTS AT TARA #20 MASTER LIFT STATION


PROJECT NO. 6022087

RECORD DRAWINGS


MAY 2010

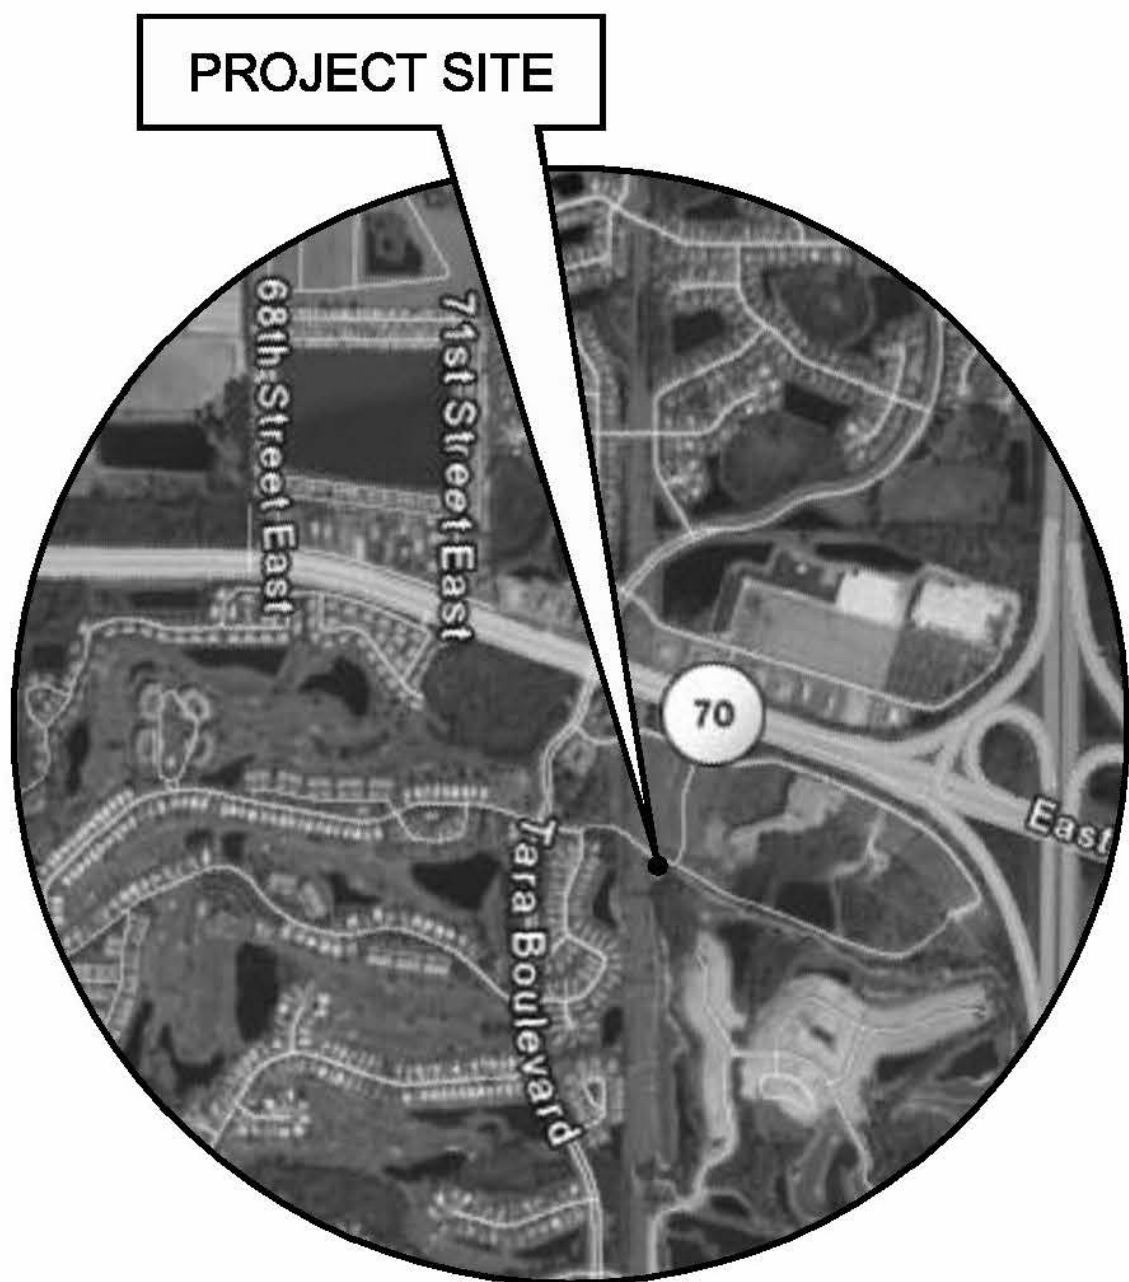


PROJECT MAP
7211 STONE RIVER ROAD
BRADENTON, FLORIDA

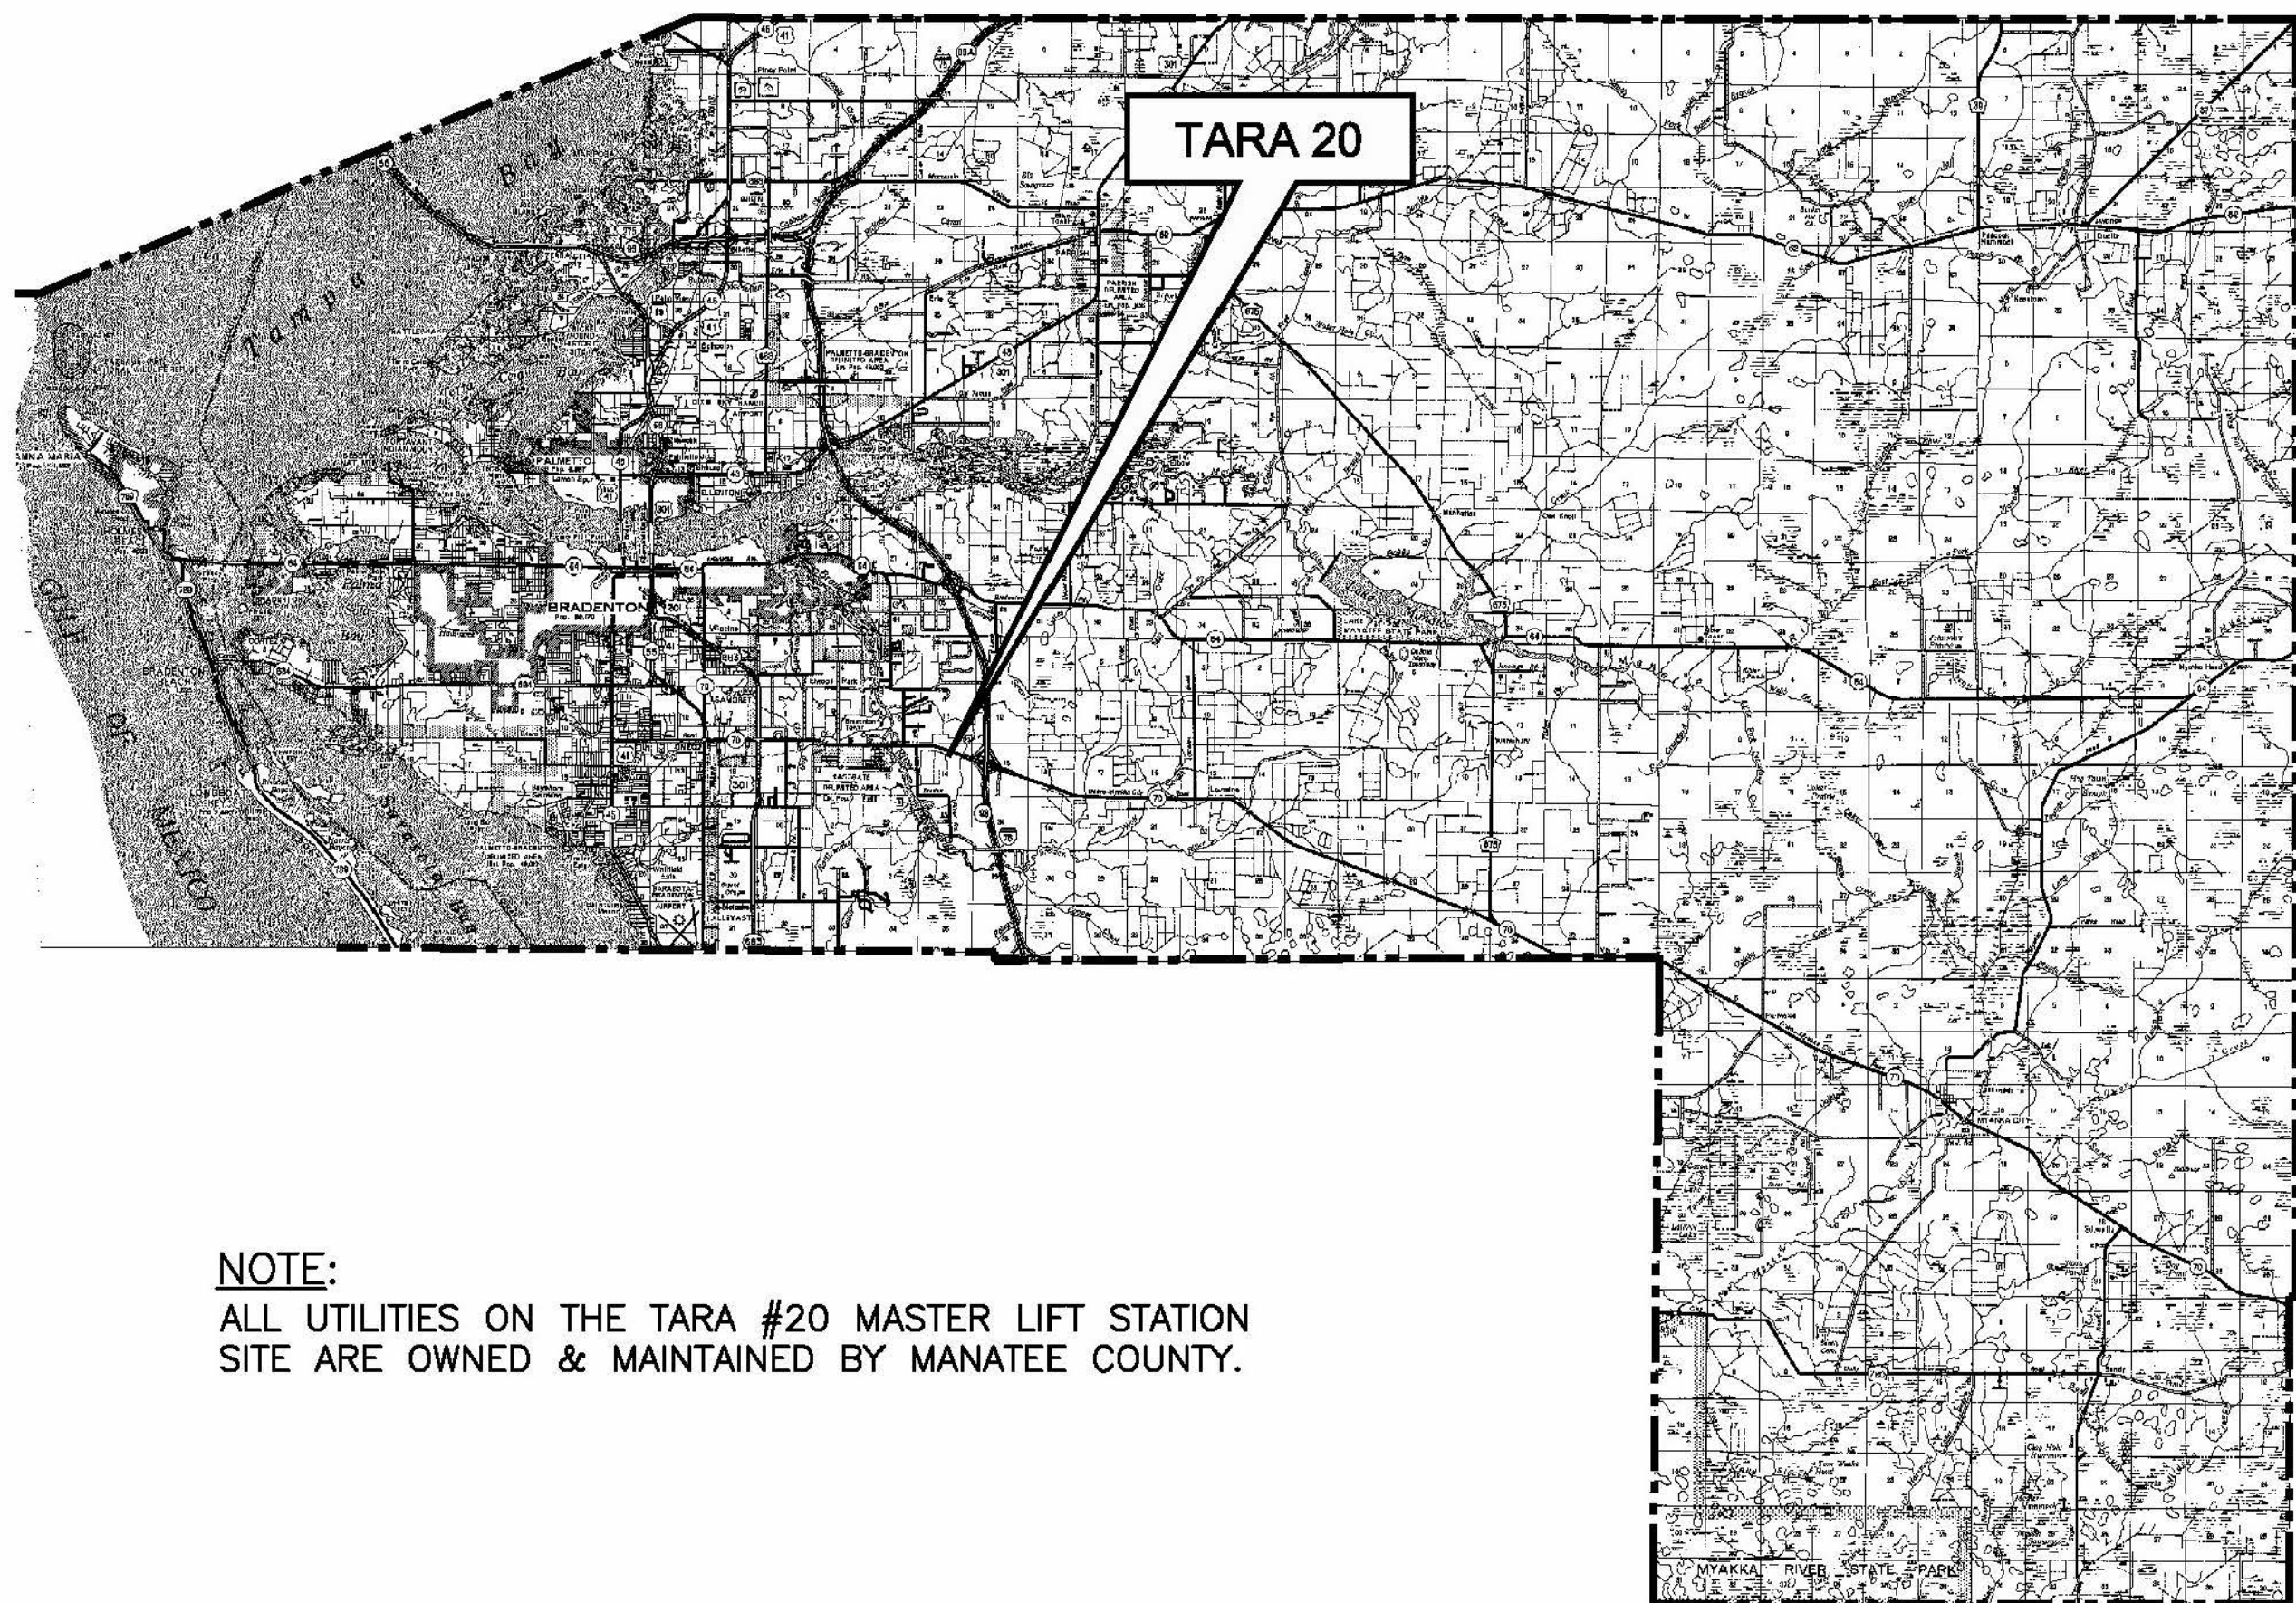

NOTE:
ALL UTILITIES ON THE TARA #20 MASTER LIFT STATION
SITE ARE OWNED & MAINTAINED BY MANATEE COUNTY.

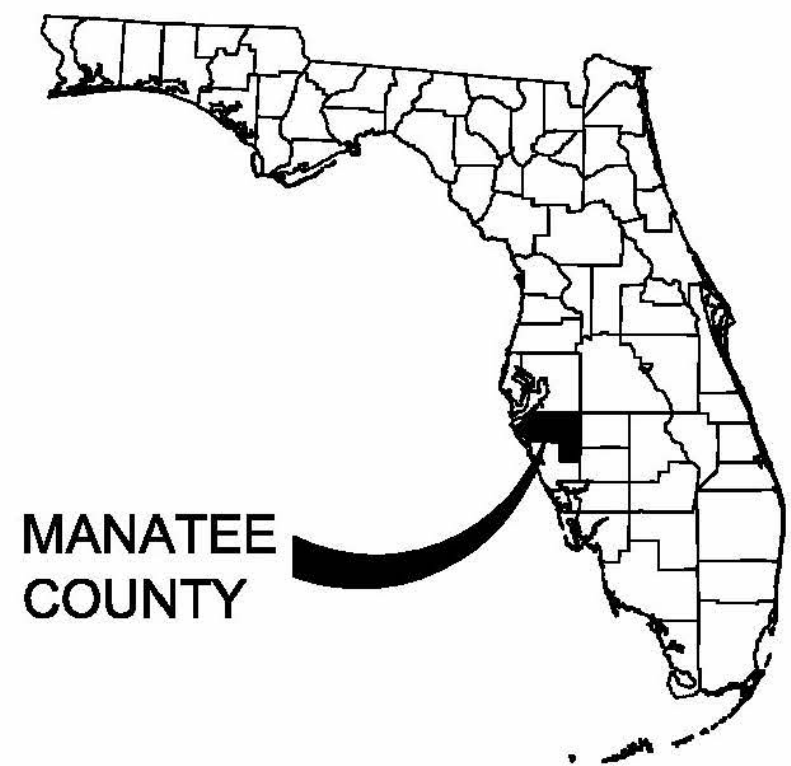

RECORD DRAWING

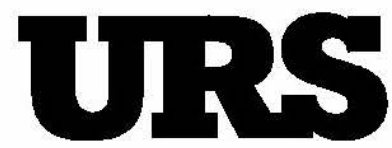

7650 West Courtney Campbell Causeway
Suite 700
Tampa, Florida 33607
Ph: (813) 286-1711 Fax: (813) 286-6587
Florida Engineering Number: 000002

NO.	BY	DATE	DESCRIPTION
REVISIONS			

URS JOB NUMBER
12007391
PM: C. OSMANSKI
ENG: R. AVALOS
DRW: J. SCHEUERMAN
FILE SAVE DATE:
May 14, 2010



IMPROVEMENTS AT
TARA #20 MASTER LIFT STATION
FOR
MANATEE COUNTY GOVERNMENT
MANATEE COUNTY, FLORIDA

COVER SHEET

CRAIG P. OSMANSKI
FLORIDA P.E. NO. 48961

PROJECT STATUS
RECORD DRAWINGS
MAY 2010

G-1

TARA #20 MASTER LIFT STATION IMPROVEMENTS, PROJECT NO. 6022087, MAY 2010, RECORD DRAWINGS

VERIFY SCALES: BAY IS ONE INCH ON ORIGINAL DRAWING 0 1 IF NOT ONE INCH ON THIS SHEET, ADJUST SCALE ACCORDINGLY

11/20/2010 9:10 AM PLOTTED BY: SCHEUERMAN, JAMES
X:\MANATEE PROJECTS\12007291 TARA # 20 MASTER LIFT STATION - WMA CADD\G-2 INDEX GENERAL NOTES SYMBOLS AND ABBREVIATIONS.DWG

INDEX TO SHEETS	
SHEET NUMBER	SHEET TITLE
GENERAL	
G-1	COVER SHEET
G-2	INDEX TO SHEETS, GENERAL NOTES, SYMBOLS AND ABBREVIATIONS
CIVIL	
C-1	EXISTING SITE PLAN & DEMOLITION PLAN
C-2	PROPOSED SITE PLAN
C-3	CIVIL DETAILS
C-4	CIVIL DETAILS
MECHANICAL	
M-1	PUMP STATION DEMO UPPER PLAN
M-2	PUMP STATION DEMO LOWER PLAN
M-3	PUMP STATION DEMO SECTION
M-4	PUMP STATION PROPOSED PLAN
M-5	PUMP STATION PROPOSED SECTION
M-6	GENERATOR ENCLOSURE & FUEL TANK
M-7	ELECTRICAL BUILDING
ELECTRICAL	
E-1	ELECTRICAL ABBREVIATIONS, SYMBOLS LEGEND & NOTES
E-2	ELECTRICAL SITE PLAN
E-3	ELECTRICAL BUILDING PLAN
E-4	GENERATOR ENCLOSURE PLAN
E-5	ELECTRICAL WET WELL PLAN
E-6	SINGLE LINE DIAGRAM
E-7	PLC INPUT-OUTPUT SCHEDULE

GENERAL NOTES

- LOCATION, ELEVATION, AND DIMENSIONS OF THE EXISTING UTILITIES, STRUCTURES, AND OTHER FEATURES ARE SHOWN ACCORDING TO THE BEST INFORMATION AVAILABLE AT TIME OF THE PREPARATION OF THESE PLANS. THE CONTRACTOR SHALL VERIFY THE LOCATIONS, ELEVATIONS, AND DIMENSIONS OF ALL EXISTING UTILITIES, STRUCTURES AND OTHER FEATURES AFFECTING THIS WORK PRIOR TO CONSTRUCTION.
- CONTRACTOR SHALL FIELD VERIFY ALL MEASUREMENTS AND SUBMIT ONLY EQUIPMENT THAT MEETS THE SPECIFICATIONS AND FITS IN THE SPACE AVAILABLE.
- THE CONTRACTOR SHALL EXERCISE EXTREME CAUTION IN AREAS OF BURIED UTILITIES AND SHALL PROVIDE AT LEAST 48 HOURS NOTICE TO THE UTILITY COMPANIES PRIOR TO CONSTRUCTION TO OBTAIN FIELD LOCATIONS OF EXISTING UNDERGROUND UTILITIES. CALL SUNSHINE ONE CALL CENTER OF FLORIDA AT 1-800-432-4770 TO ARRANGE FIELD LOCATIONS. THE CONTRACTOR SHALL REPAIR ALL DAMAGES RESULTING FROM FAILURE TO COMPLY WITH THIS REQUIREMENT.
- CONTRACTOR SHALL INVESTIGATE ALL AREAS OF THE WORK AND PREPARE AND PLAN FOR UNFORESEEN CONDITIONS LIKE EMERGENCY PUMPING, NEIGHBORHOOD NOTICES, BYPASS PUMPING AND CLOSURE NOTICES.
- MAINTENANCE OF TRAFFIC, IF NECESSARY, WILL BE THE RESPONSIBILITY OF THE CONTRACTOR, AND SHALL BE PREPARED PER FDOT STANDARDS. MOT PREPARER SHALL HOLD THE NEW WORK ZONE TRAFFIC CONTROL ADVANCED LEVEL TRAINING CERTIFICATION. A COPY OF THE CERTIFICATION SHALL BE SUBMITTED TO THE ENGINEER ALONG WITH THE MOT FOR APPROVAL BY FDOT. ALL WORK ZONES SHALL BE SET UP AND MAINTAINED BY SOMEONE WHO HAS WORK ZONE TRAFFIC CONTROL INTERMEDIATE LEVEL TRAINING. ACCESS TO EXISTING RESIDENCES AND BUSINESSES MUST BE MAINTAINED AT ALL TIMES.
- UNLESS OTHERWISE SPECIFIED IN THE CONTRACT DOCUMENTS AND SPECIFICATIONS, THE CONTRACTOR SHALL PROVIDE SUITABLE BORROW MATERIAL, APPROVED BY THE ENGINEER, AND INSTALL SAID MATERIAL IN ACCORDANCE WITH THE PLANS AND SPECIFICATIONS.
- OVERALL CLEAN UP SHALL BE ACCOMPLISHED BY THE CONTRACTOR IN ACCORDANCE WITH COUNTY STANDARDS OR AS DIRECTED BY THE ENGINEER. ANY AND ALL EXPENSES INCURRED FOR THIS WORK SHALL BE INCLUDED IN THE BID PRICE.
- THE CONTRACTOR SHALL ENDEAVOR TO PROTECT PRIVATE PROPERTY. ANY DAMAGE CAUSED BY THE CONTRACTOR IN THE PERFORMANCE OF HIS WORK SHALL BE CORRECTED TO THE SATISFACTION OF THE ENGINEER AT THE CONTRACTOR'S EXPENSE. PAYMENT SHALL NOT BE MADE FOR THIS WORK.
- ANY DAMAGE TO STATE, COUNTY, OR LOCAL ROADS CAUSED BY THE CONTRACTOR'S HAULING OR EXCAVATION EQUIPMENT SHALL BE REPAIRED BY THE CONTRACTOR TO THE SATISFACTION OF THE COUNTY PROJECT ENGINEER. PAYMENT SHALL NOT BE MADE FOR THIS WORK.
- ANY U.S.C. AND G.S. MONUMENT WITHIN LIMITS OF CONSTRUCTION IS TO BE PROTECTED. IF IN DANGER OF DAMAGE, THE CONTRACTOR SHALL NOTIFY: GEODETIC INFORMATION CENTER
ATTN.: MARK MAINTENANCE CENTER
ATTN.: N/CG-162
6001 EXECUTIVE BLVD. ROCKVILLE,
MARYLAND 20852
PH (301)443-8319
- THE CONTRACTOR(S) PERFORMING TRENCH EXCAVATION ON THIS CONTRACT, SHALL COMPLY WITH THE OCCUPATIONAL SAFETY AND HEALTH ADMINISTRATION'S (OSHA) TRENCH EXCAVATION SAFETY STANDARDS, 29 C.F.R., 5.1926.650, SUBPART P, INCLUDING ALL SUBSEQUENT REVISIONS OR UPDATES TO THE STANDARDS AS ADOPTED BY THE DEPARTMENT OF LABOR AND EMPLOYMENT SECURITY (DLES).
- UNLESS OTHERWISE SPECIFIED IN THE PLANS, ALL DISTURBED AREAS SHALL BE SADDLED.
- THE CONTRACTOR SHALL BE RESPONSIBLE FOR THE REMOVAL OF ALL EXCESS MATERIAL AND THE PROPER DISPOSAL OF THE SAME.
- CONTRACTOR IS TO PROVIDE EROSION CONTROL/SEDIMENTATION BARRIER (HAY BALES OR SILT FENCE) TO PREVENT SILTATION OF ADJACENT PROPERTY STREETS, STORM SEWERS, AND WATERWAYS. IF IN THE OPINION OF THE ENGINEER AND/OR LOCAL AUTHORITIES, EXCESSIVE QUANTITIES OF EARTH ARE TRANSPORTED OFF-SITE EITHER BY NATURAL DRAINAGE OR VEHICULAR TRAFFIC, THE CONTRACTOR IS TO REMOVE AND CLEAN SAID EARTH TO THE SATISFACTION OF THE ENGINEER AND/OR AUTHORITIES. THE MAINTENANCE OF EROSION CONTROL DEVICES AND THEIR COMPLETE REMOVAL ARE TO BE INCLUDED IN THE UNIT BID PRICE FOR EACH INDIVIDUAL ITEM.
- THE CONTRACTOR SHALL PROVIDE ROUTINE MAINTENANCE OF PERMANENT AND TEMPORARY EROSION CONTROL FEATURES UNTIL THE PROJECT IS COMPLETE AND ALL BARED SOILS ARE STABILIZED.
- THE CONTRACTOR SHALL BE RESPONSIBLE FOR THE MAINTENANCE OF THE EXISTING DRAINAGE SYSTEM WITHIN THE LIMITS OF THE PROJECT AREA, FOR THE DURATION OF THE PROJECT. NO ADDITIONAL PAYMENT WILL BE MADE FOR THE WORK INVOLVED.
- THE CONTRACTOR IS RESPONSIBLE FOR REPAIRING ANY DAMAGE TO EXISTING FACILITIES, ABOVE OR BELOW GROUND THAT MAY OCCUR AS A RESULT OF THIS WORK PERFORMED IN THIS CONTRACT.
- THE CONTRACTOR IS TO "PROTECT IN PLACE" THE FACILITIES THAT ARE NOT TO BE RELOCATED AND/OR REMOVED, BUT ARE TO REMAIN IN PLACE.
- THE CONTRACTOR IS TO ADJUST OR RELOCATE ALL THE FACILITIES THAT FALL IN CONFLICT IN ACCORDANCE WITH COUNTY STANDARDS.
- ALL UTILITY CONSTRUCTION SHALL BE IN CONFORMANCE WITH THE LATEST VERSION OF THE MANATEE COUNTY UTILITIES STANDARDS.
- ALL BURIED DUCTILE IRON PIPE SHALL BE POLYWRAPPED.
- THE CONTRACTOR SHALL PROVIDE DETAILED RECORD DRAWINGS, ANY & ALL EXPENSES INCURRED FOR THIS WORK SHALL BE INCLUDED IN THE CONTRACTOR'S BID. REDLINE DRAWINGS SHALL BE CURRENT WITH EACH PAY APPLICATION & WILL BE CHECKED AS PART OF THE PAY APPLICATION REVIEW PROCESS.
- ELEVATIONS SHOWN ON THE PLANS REFERENCE NATIONAL GEODETIC VERTICAL DATUM OF 1929 (NGVD 1929).

REFERENCE:

THE FOLLOWING RECORD DRAWINGS WERE USED IN CONJUNCTION WITH SITE VISITS TO PREPARE THE BASE SHEETS FOR THIS PROJECT. TO OBTAIN A COPY OF THE RECORD DRAWINGS, CONTACT OLGA ROSIER, MANATEE COUNTY UTILITIES, AT (914) 792-8811

- SOUTHEAST SUBREGIONAL WASTEWATER TREATMENT FACILITIES - PROJECT 6049-32 BY CDM, OCTOBER 12, 1988
- TARA NO. 20 (RTU #323) LIFT STATION UPGRADE - PROJECT 402-5102680 BY FRED C JONES PROFESSIONAL ENGINEER, JUNE 2002


ABBREVIATIONS:

#	NUMBER	HB	HOSE BIBB
A/C	AIR CONDITIONER	HDPE	HIGH DENSITY POLYETHYLENE
AC	ASBESTOS CEMENT PIPE	HORZ	HORIZONTAL
ADDL	ADDITIONAL	HT	HEIGHT
ADJ	ADJUSTABLE	ID	INSIDE DIAMETER
ADPT	ADAPTER	IE	INVERT ELEVATION
ALUM	ALUMINUM	LF	LINER FEET
APPROX	APPROXIMATE (LY)	LT	LEFT
ARV	AIR RELEASE VALVE		
ASPH	ASPHALT	MATL	MATERIAL
AUTO	AUTOMATIC	MAX	MAXIMUM
AUX	AUXILIARY	MECH	MECHANICAL
AVG	AVERAGE	MFD	MANUFACTURED
		MFG	MANUFACTURER
		MFR	MANHOLE
BM	BENCHMARK	MH	MINIMUM
BV	BALL VALVE	MISC	MISCELLANEOUS
BFV	BUTTERFLY VALVE		
BLDG	BUILDING	NTS	NOT TO SCALE
BOT	BOTTOM	OC	ON CENTER
		OD	OUTSIDE DIAMETER
CATV	CABLE TV	O/E	OR EQUAL
CHKD	CHECKED		
CL	CENTERLINE	PE	PLAIN END
CL2	CHLORINE	PL	PROPERTY LINE
CI	CAST IRON	PP	POWER POLE
CMP	CORRUGATED METAL PIPE	PROP	PROPOSED
CMU	CONCRETE MASONRY UNITS	PS	PUMP STATION
CO	CLEAN OUT	PSI	POUNDS PER SQUARE INCH
CONC	CONCRETE	PVC	POLYVINYL CHLORIDE PIPE
CONST	CONSTRUCTION	PVMT	PAVEMENT
CPLG	COUPLING	PW	POTABLE WATER
CTR	CENTER (ED)		
CV	CHECK VALVE	R/W	RIGHT-OF-WAY
		RAD	RADIUS
D	DRAIN	RCF	REINFORCED CONCRETE PIPE
DEMO	DEMOLITION	RCW	RECLAIMED WATER
DEPT	DEPARTMENT	RED	REDUCER
DI	DUCTILE IRON	RMJ	RESTRAIN MECHANICAL JOINT
DIA	DIAMETER	RR	RAILROAD
DIAG	DIAGONAL	RT	RIGHT
DIM	DIMENSION	RW	RAW WATER
DN	DOWN		
		SAN	SANITARY
EA	EACH	SCH	SCHEDULE
ECC	ECCENTRIC	SFM	SANITARY FORCE MAIN
EFF	EFFLUENT	SHC	SODIUM HYPOCHLORITE
EL	ELEVATION	SHT	SHEET
EOP	EDGE OF PAVEMENT	SQR	SQUARE
EQ	EQUAL (LY)	SS	SANITARY SEWER
EQIV	EQUIVALENT	SST	STAINLESS STEEL
EQUIP	EQUIPMENT	STD	STANDARD
ESMT	EASEMENT	STL	STEEL
ETC	ETCETERA	SW	SOLVENT WELD
EW	EACH WAY	SWLK	SIDEWALK
EXIST	EXISTING		
EXP	EXPANSION	T&B	TOP AND BOTTOM
		TBM	TEMPORARY BENCHMARK
FIG	FIGURE	TEL	TELEPHONE
FIN	FINISH (ED)	THD	THREADED
FLG	FLANGE	THK	THICK (NESS)
FLR	FLOOR	TYP	TYPICAL
FM	FORCE MAIN		
FRP	FIBERGLASS REINFORCED PIPE	UD	UNDERDRAIN
FT	FOOT OR FEET	VERT	VERTICAL
		W/	WITH
GAL	GALLON	WM	WATERMAIN OR WATER METER
GALV	GALVANIZED	WV	WATER VALVE
GV	GATE VALVE	WWM	WOVEN WIRE MESH
		XFMR	TRANSFORMER

PIPE AND FITTING SYMBOLS

DOUBLE LINE	SINGLE LINE	
		90° ELBOW
		90° ELBOW ROTATED UP
		90° ELBOW ROTATED DOWN
		TEE
		TEE ROTATED UP
		TEE ROTATED DOWN
		REDUCER
		ECCENTRIC REDUCER
		BALL VALVE
		BUTTERFLY VALVE
		GATE VALVE
		CHECK VALVE
		PLUG VALVE
		HOSE BIBB & VALVE
		FLOW METER
		TO BE REMOVED

DETAIL & SECTION DESIGNATION

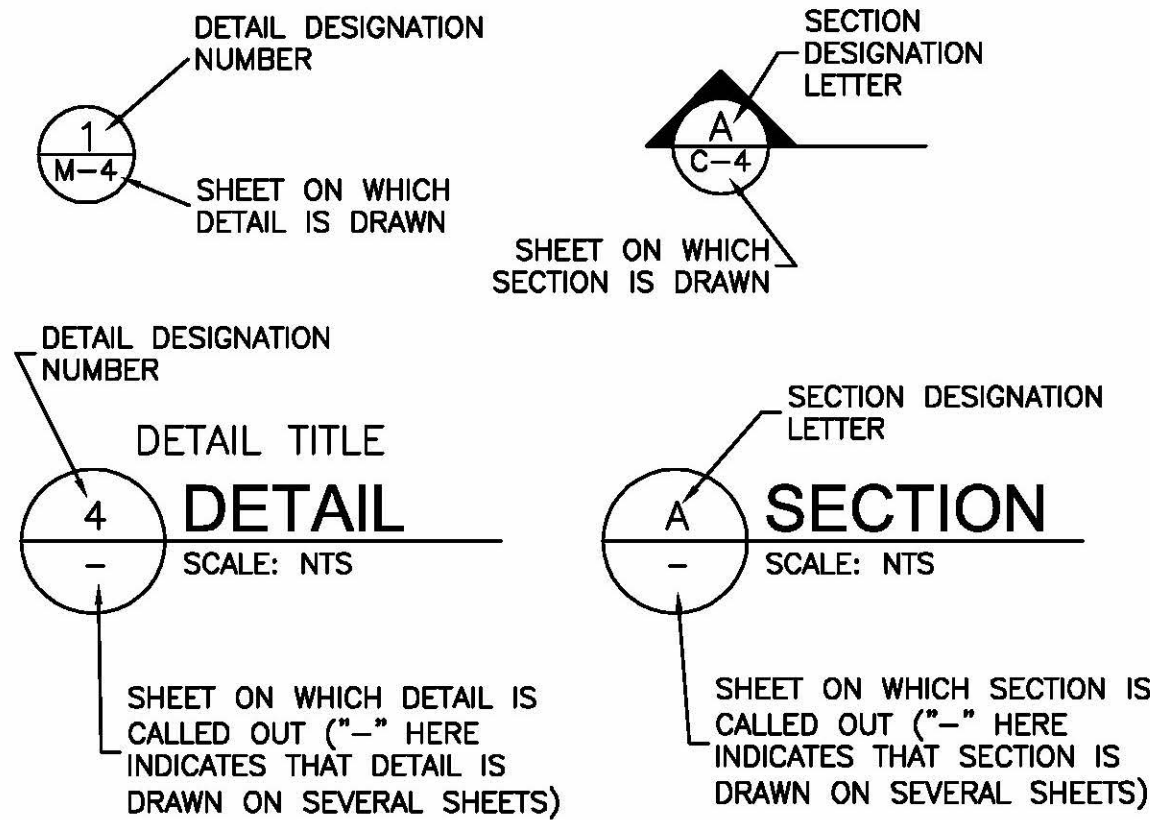

FITTING TYPE SYMBOLS

	DOUBLE LINE	SINGLE LINE
FLANGE		
MECHANICAL JOINT		
PUSH ON JOINT		

RECORD DRAWINGS LEGEND

DESIGN - INVERT ELEV. ~~24.80~~
RECORD - INVERT ELEV. **24.75**
 RELOCATED OR REMOVED
- X - X - PER AS-BUILT DRAWINGS



7650 West Courtney Campbell Causeway
Suite 700
Tampa, Florida 33607
Ph: (813) 286-1711 Fax: (813) 286-6587
Florida Engineering Number: 000002

NO.	BY	DATE	DESCRIPTION
REVISIONS			

URS JOB NUMBER
12007391
PM: C. OSMANSKI
ENG: C. OSMANSKI
DRW: J. SCHEUERMAN
FILE SAVE DATE:
June 7, 2010



IMPROVEMENTS AT
TARA #20 MASTER LIFT STATION
FOR
MANATEE COUNTY GOVERNMENT
MANATEE COUNTY, FLORIDA

INDEX, GENERAL NOTES, SYMBOLS
AND ABBREVIATIONS

CRAIG P. OSMANSKI
FLORIDA P.E. NO. 48961


PROJECT STATUS
RECORD DRAWINGS
MAY 2010

G-2

RECORD DRAWING

VERIFY SCALES: BAR IS ONE INCH ON ORIGINAL DRAWING 0 1 IF NOT ONE INCH ON THIS SHEET, ADJUST SCALE ACCORDINGLY

PLOTTED June 15, 2006 3:51 PM PLOTTED BY: SCHEUERMAN, JAMES
X:\MANATEE PROJECTS\12007391 TARA # 20 MASTER LIFT STATION - W44\CADD\C-1 EXISTING SITE PLAN & DEMOLITION PLAN.DWG

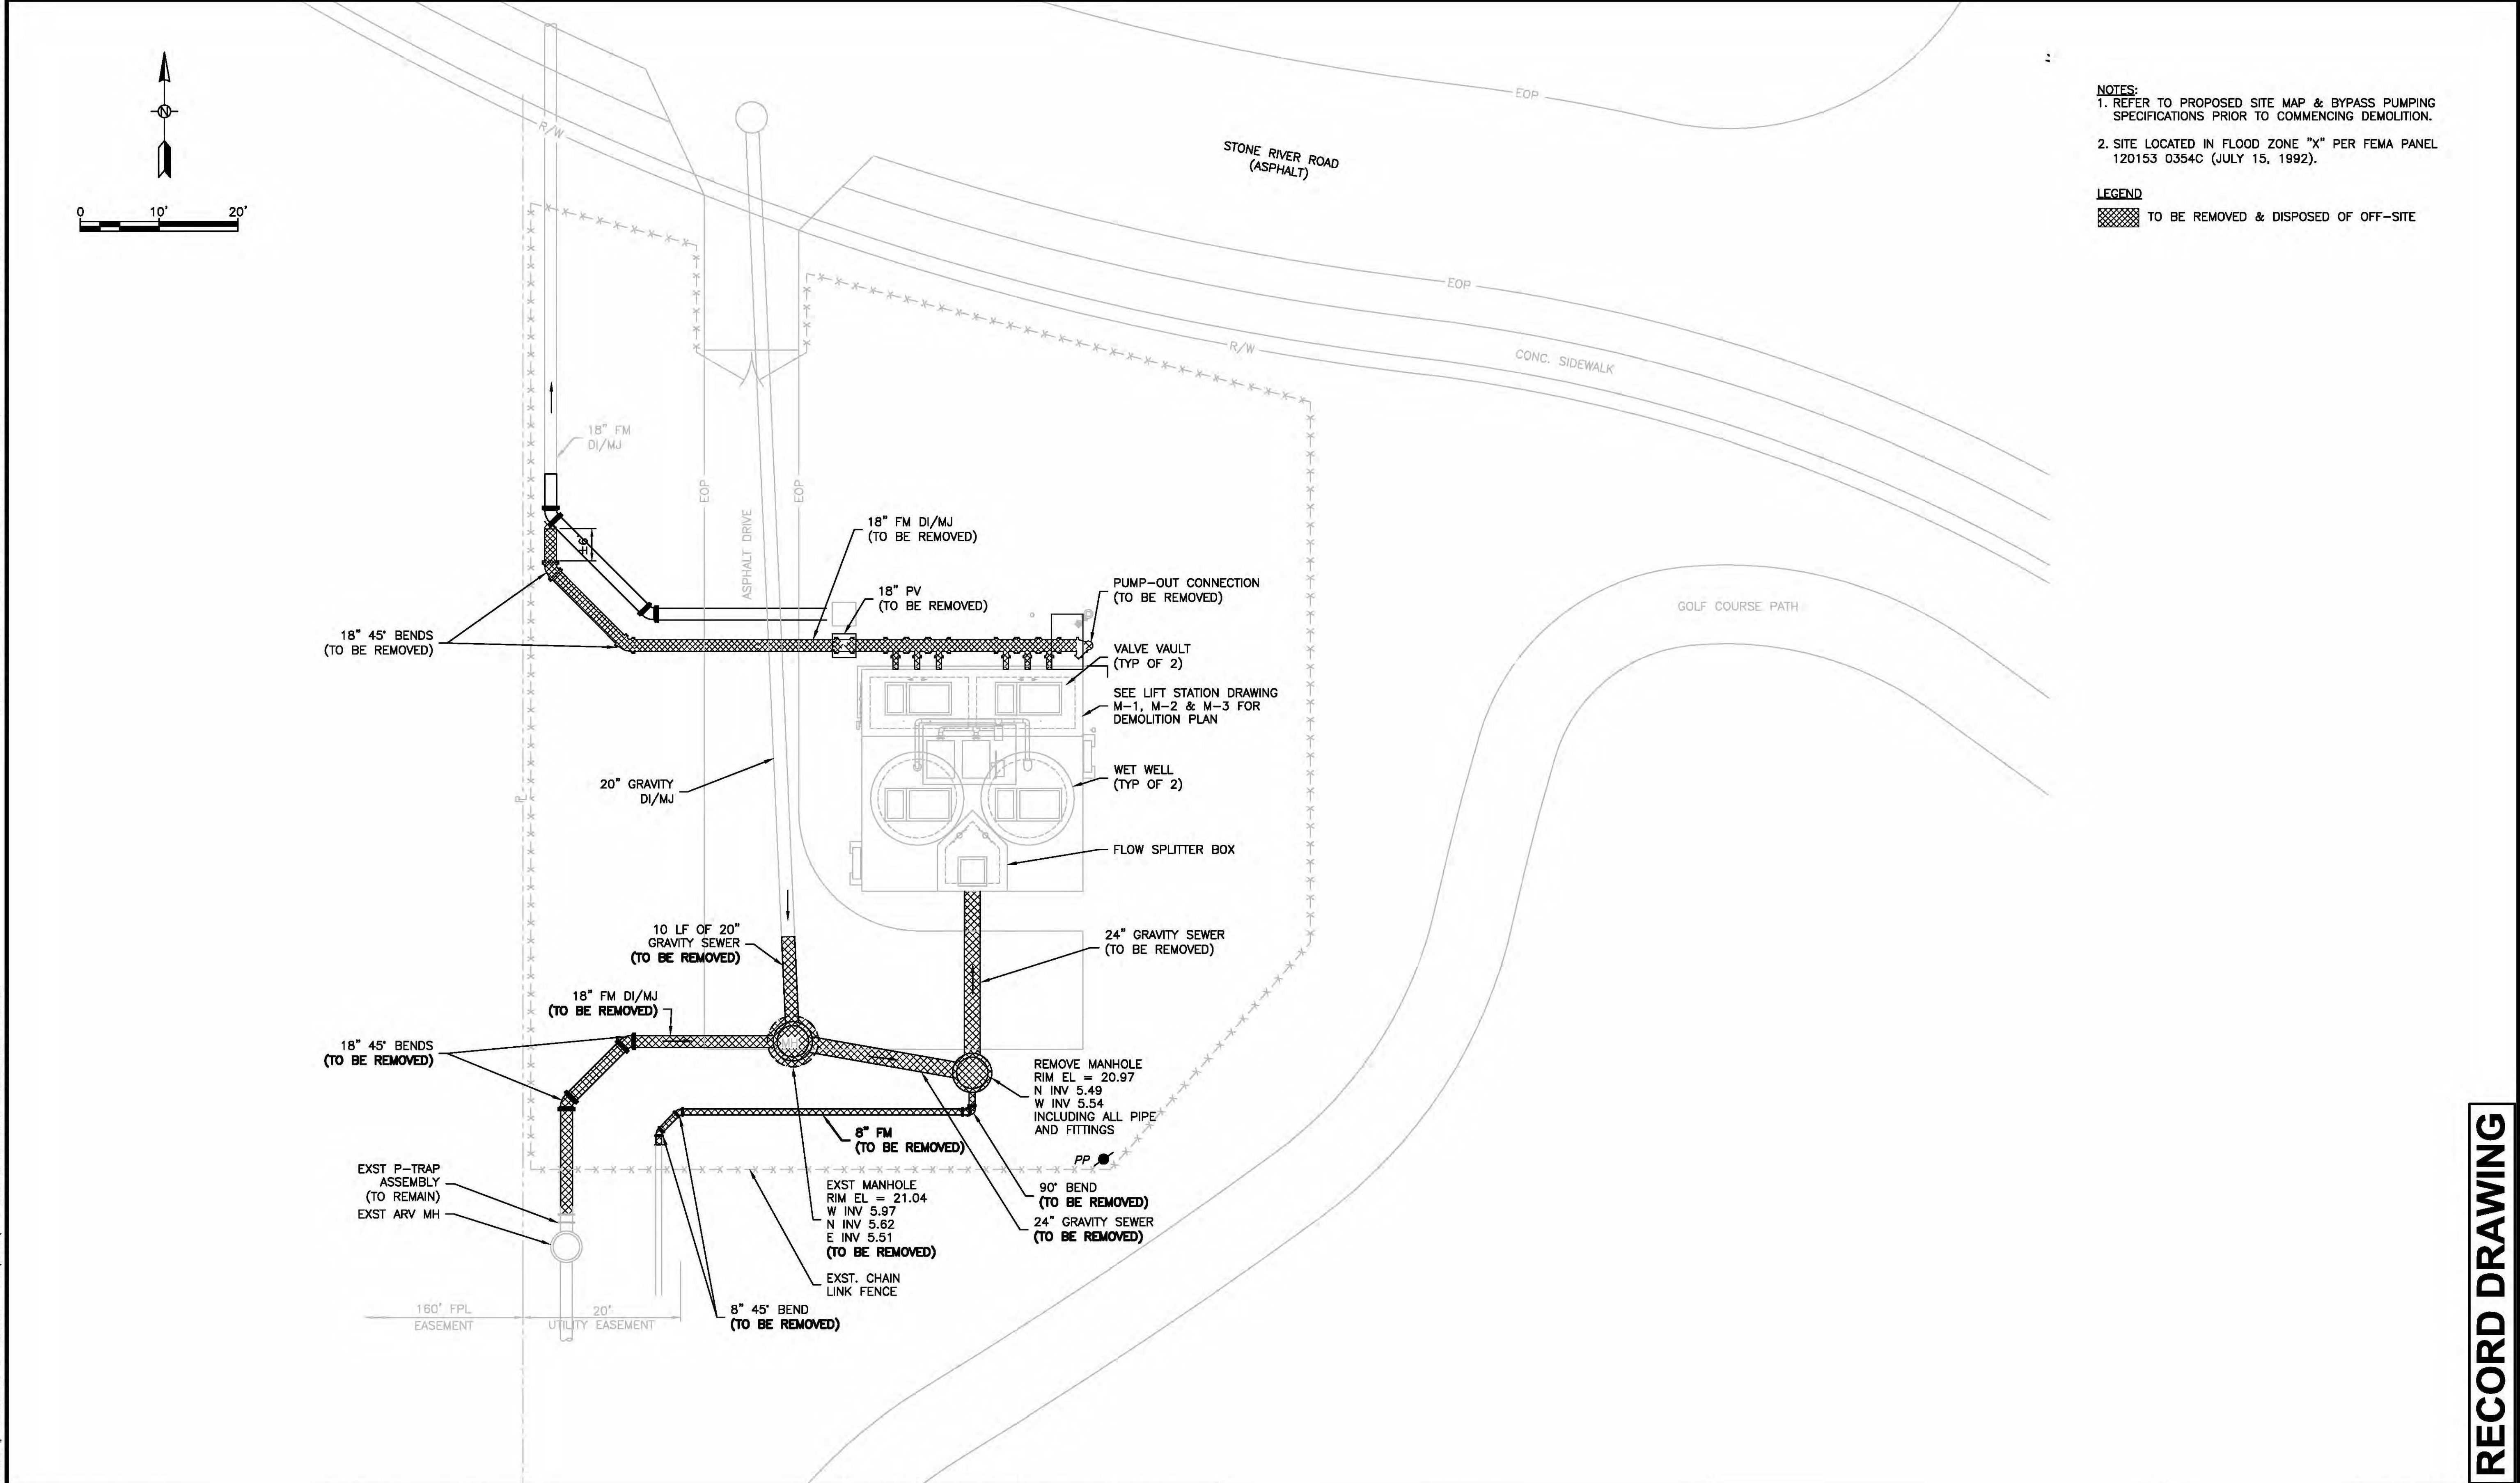

- NOTES:**
1. REFER TO PROPOSED SITE MAP & BYPASS PUMPING SPECIFICATIONS PRIOR TO COMMENCING DEMOLITION.
 2. SITE LOCATED IN FLOOD ZONE "X" PER FEMA PANEL 120153 0354C (JULY 15, 1992).
- LEGEND**
- TO BE REMOVED & DISPOSED OF OFF-SITE

 7650 West Courtney Campbell Causeway Suite 700 Tampa, Florida 33607 Ph: (813) 286-1711 Fax: (813) 286-6587 Florida Engineering Number: 000002			URS JOB NUMBER 12007391		IMPROVEMENTS AT TARA #20 MASTER LIFT STATION FOR MANATEE COUNTY GOVERNMENT MANATEE COUNTY, FLORIDA	EXISTING SITE PLAN & DEMOLITION PLAN	PROJECT STATUS RECORD DRAWINGS MAY 2010	C-1
	NO. BY DATE DESCRIPTION		PM: C. OSMANSKI ENG: C. OSMANSKI DRW: J. SCHEUERMAN FILE SAVE DATE: June 8, 2010					

RECORD DRAWING



CONSTRUCTION SEQUENCE

1. INSTALL 18" X 16" BYPASS CONNECTION ASSEMBLY ON THE EXISTING 18-INCH FORCEMAIN.
2. COORDINATE WITH THE COUNTY AND PLUG THE EXISTING 20-INCH GRAVITY SEWER UPSTREAM OF THE WORK AREA DURING LOW FLOW CONDITIONS. ALSO, PLUG THE DOWNSTREAM 20-INCH GRAVITY SEWER AS REQUIRED TO PREVENT FORMAN FLOW FROM ENTERING THE WORK AREA. THE GRAVITY SEWER CAN BE PLUGGED FOR FOUR (4) HOURS DURING LOW FLOW CONDITIONS.
3. INSTALL NEW 6 FOOT DIAMETER MANHOLE NO. 1 (NEW BYPASS MANHOLE) JUST NORTH OF THE EXISTING MANHOLE (OLD BYPASS MANHOLE). THE MANHOLE SHALL BE PRECAST WITH PIPE BOOTS TO ACCEPT THE 20-INCH GRAVITY SEWER (0 & 180 DEG.), 36-INCH DUCTILE IRON GRAVITY SEWER (90 DEG.), 24-INCH FORCEMAIN (270 DEG.) AND 8-INCH FORCEMAIN (180 DEG.) ABOVE THE EXISTING 20-INCH GRAVITY SEWER.
4. TEMPORARY PLUG THE 36-INCH, 24-INCH AND 8-INCH OPENINGS IN THE NEW MANHOLE AND REMOVE THE 20-INCH PIPE PLUG TO PUT THE 20-INCH GRAVITY SEWER BACK IN SERVICE.
5. INSTALL A SECTION OF THE NEW 36-INCH DUCTILE IRON GRAVITY SEWER FROM THE NEW BYPASS MANHOLE TO THE EAST TOWARDS THE EXISTING GRAVITY SEWER ENTERING THE FLOW SPLITTER BOX AND PLUG AT MANHOLE.
6. INSTALL THE NEW 8-INCH C900 PVC FORCEMAIN FROM THE NEW BYPASS MANHOLE TO A LOCATION NEAR THE EXISTING 8-INCH FORCEMAIN 45 DEGREE BEND.
7. INSTALL THE NEW 24-INCH C905 PVC FORCEMAIN FROM THE NEW BYPASS MANHOLE TO A LOCATION NEAR THE EXISTING 18-INCH FORCEMAIN 45 DEGREE BEND.
8. COORDINATE WITH THE COUNTY SUCH THAT THE COUNTY CAN SHUT DOWN THE PUMP STATION FEEDING THE 18-INCH FORCEMAIN FOR FOUR (4) HOURS DURING LOW FLOW CONDITIONS.
9. CUT IN A SECTION OF 24-INCH PVC FORCEMAIN WITH 24" X 18" REDUCER TO TIE THE NEW FORCEMAIN TO THE EXISTING FORCEMAIN JUST DOWNSTREAM OF THE EXISTING ARV MANHOLE AND P-TRAP. ALL JOINTS SHALL BE RESTRAINED. REMOVE SECTION OF THE 18-INCH FORCEMAIN AS REQUIRED TO INSTALL THE NEW 24-INCH FORCEMAIN.
10. COORDINATE WITH THE COUNTY SUCH THAT THE COUNTY CAN SHUT DOWN THE PUMP STATION FEEDING THE 8-INCH FORCEMAIN FOR FOUR (4) HOURS DURING LOW FLOW CONDITIONS.
11. CUT IN A SECTION OF 8-INCH PVC FORCEMAIN WITH 8-INCH 45 DEGREE BEND TO TIE THE NEW FORCEMAIN TO THE EXISTING. ALL JOINTS SHALL BE RESTRAINED. REMOVE SECTIONS OF THE EXISTING 18-INCH AND 8-INCH FORCEMAINS AS REQUIRED TO INSTALL THE NEW 8-INCH PVC FORCEMAIN.
12. SETUP, TEST AND START THE BYPASS SYSTEM FROM THE NEW BYPASS MANHOLE TO THE BYPASS CONNECTION ASSEMBLY LOCATED ON THE EXISTING 18-INCH FORCEMAIN.
13. ONCE THE BYPASS SYSTEM IS OPERATIONAL, PLUG THE EXISTING 20-INCH GRAVITY SEWER DOWNSTREAM OF THE NEW BYPASS MANHOLE.
14. REMOVE THE EXISTING 24-INCH GRAVITY SEWER FROM THE FLOW SPLITTER BOX TO THE FIRST UPSTREAM MANHOLE.
15. INSTALL A NEW 6 FOOT DIAMETER MANHOLE NO. 2 JUST SOUTH OF THE FLOW SPLITTER AND COMPLETE THE INSTALLATION OF THE NEW 36-INCH DUCTILE IRON GRAVITY SEWERS FROM THE FLOW SPLITTER BOX TO MANHOLE NO. 1 AND MANHOLE NO. 2.
16. PERMANENTLY BULKHEAD THE 20-INCH DOWNSTREAM OPENING IN THE NEW BYPASS MANHOLE AND INSTALL LINER OVER THE CONCRETE. REMOVE THE 20-INCH PLUG AND GO OFF BYPASS.
17. PUMP STATION IS NOW BACK TO NORMAL OPERATION.
18. REMOVE ALL REMAINING MANHOLES AND YARD PIPING NOT IN SERVICE. DISPOSE OF OFF-SITE.

SITE LOCATION:
IN FLOOD "ZONE X" PER FIRM PANEL 120153 0354C
(JULY 15, 1992)

VERIFY SCALES: BAR IS ONE INCH ON THIS SHEET, ADJUST SCALE ACCORDINGLY
PLOTTED June 8, 2010 9:10 AM PLOTTED BY: SCHEUERMAN, JAMES
X:\MANATEE PROJECTS\12007391 - TARA #20 MASTER LIFT STATION - WAK-CADD\3-CIVIL DETAILS.DWG

THRUST BLOCK DIMENSIONS B ft. x d inches												
PIPE SIZE (IN.)	90° BEND		45° BEND		22.5° BEND		11.25° BEND		DEAD END & TEE		45° WYE	
	B	d	B	d	B	d	B	d	B	d	B	d
4	1.5	3 1/2	1.1	3 1/2	0.8	3 1/2	0.6	3 1/2	1.3	3 1/2	1.1	3 1/2
6	2.2	5 1/4	1.6	3 3/4	1.2	3 1/2	0.8	3 1/2	1.9	4 1/2	1.6	3 3/4
8	2.9	7	2.1	5	1.5	3 1/2	1.1	3 1/2	2.4	5 3/4	2.0	4 3/4
10	3.5	8 1/2	2.6	6 1/4	1.9	4 1/2	1.3	3 1/2	3.0	7 1/4	2.5	6
12	4.2	10	3.1	7 1/2	2.2	5 1/4	1.6	3 3/4	3.5	8 1/2	3.0	7 1/4
14	4.9	11 1/4	3.6	8 3/4	2.6	6 1/4	1.8	4 1/4	4.1	9 3/4	3.4	8 1/4
16	5.5	13 1/4	4.1	9 3/4	2.9	7	2.1	5	4.7	11 1/4	3.9	9 1/4
18	6.2	15	4.6	11	3.3	8	2.3	5 1/2	5.2	12 1/2	4.4	10 1/2
20	6.9	16 1/2	5.0	12	3.6	8 3/4	2.6	6 1/4	5.8	14	4.9	11 1/4
24	8.2	19 1/4	6.0	14 1/2	4.3	10 1/4	3.1	7 1/2	6.9	16 1/2	5.8	14
30	10.1	24 1/4	7.5	18	5.3	12 3/4	3.8	9	8.5	20 1/2	7.2	17 1/4
36	12.1	29	8.9	21 1/4	6.4	15 1/4	4.5	10 1/4	10.2	24 1/2	8.6	20 3/4

REINFORCEMENT MAT SCHEDULE

FOR DIM."B" BETWEEN 5.75' & 11.5' USE #4 @ 8" EACH WAY

FOR DIM."B" LESS THAN 5.75' USE #3 @ 8" EACH WAY

NOTES:

1. ALL THRUST BLOCKS SHALL BE CAST IN PLACE.

2. THIS TABLE IS BASED ON WATER PRESSURE=180 PSI WITH AN ALLOWABLE SOIL BEARING PRESSURE=2000 PSF, CONCRETE STRENGTH f_c =3000 PSI, REINFORCEMENT f_y =60,000 KSI THRUST BLOCK SHALL BE CAST AGAINST FIRM UNDISTURBED SOIL.

3. FOR LARGER "B" DIMENSIONS IT IS NECESSARY TO CHECK THAT PIPE IS SUFFICIENTLY DEEP TO ALLOW 15" MIN. SOIL COVER OVER TOP EDGE OF THRUST BLOCK.


90° BEND

45°, 22.5° OR 11.25° BEND


TEE OR DEAD END

45° WYE


MANATEE COUNTY PUBLIC WORKS DEPARTMENT		CONCRETE THRUST BLOCKS		UG-7	
REV. BY CLB/KE	DATE 2/05	DATE OF APPROVAL APRIL 25, 2006			

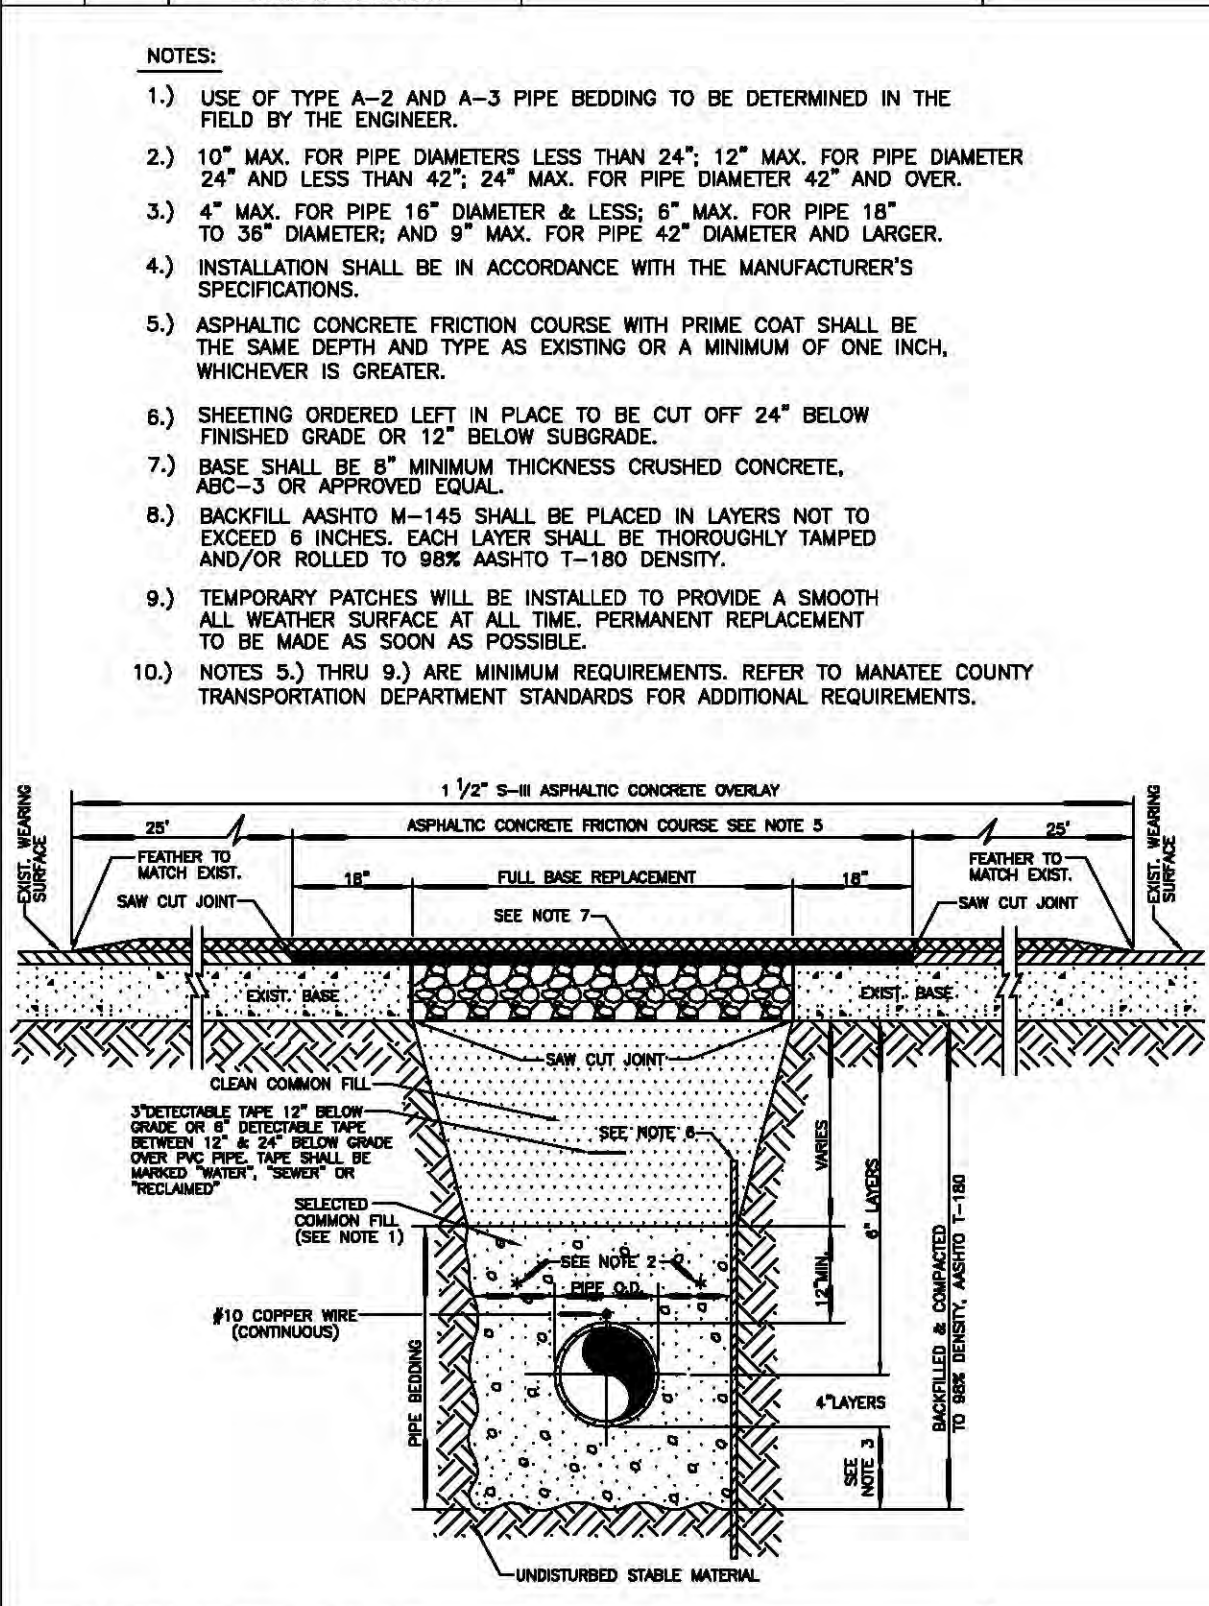

MANATEE COUNTY PUBLIC WORKS DEPARTMENT		TRENCH WITH ASPHALT PAVEMENT SURFACE TYPE A-1 PIPE BEDDING		UG-12	
REV. BY CLB/KE	DATE 2/05	DATE OF APPROVAL APRIL 25, 2006			

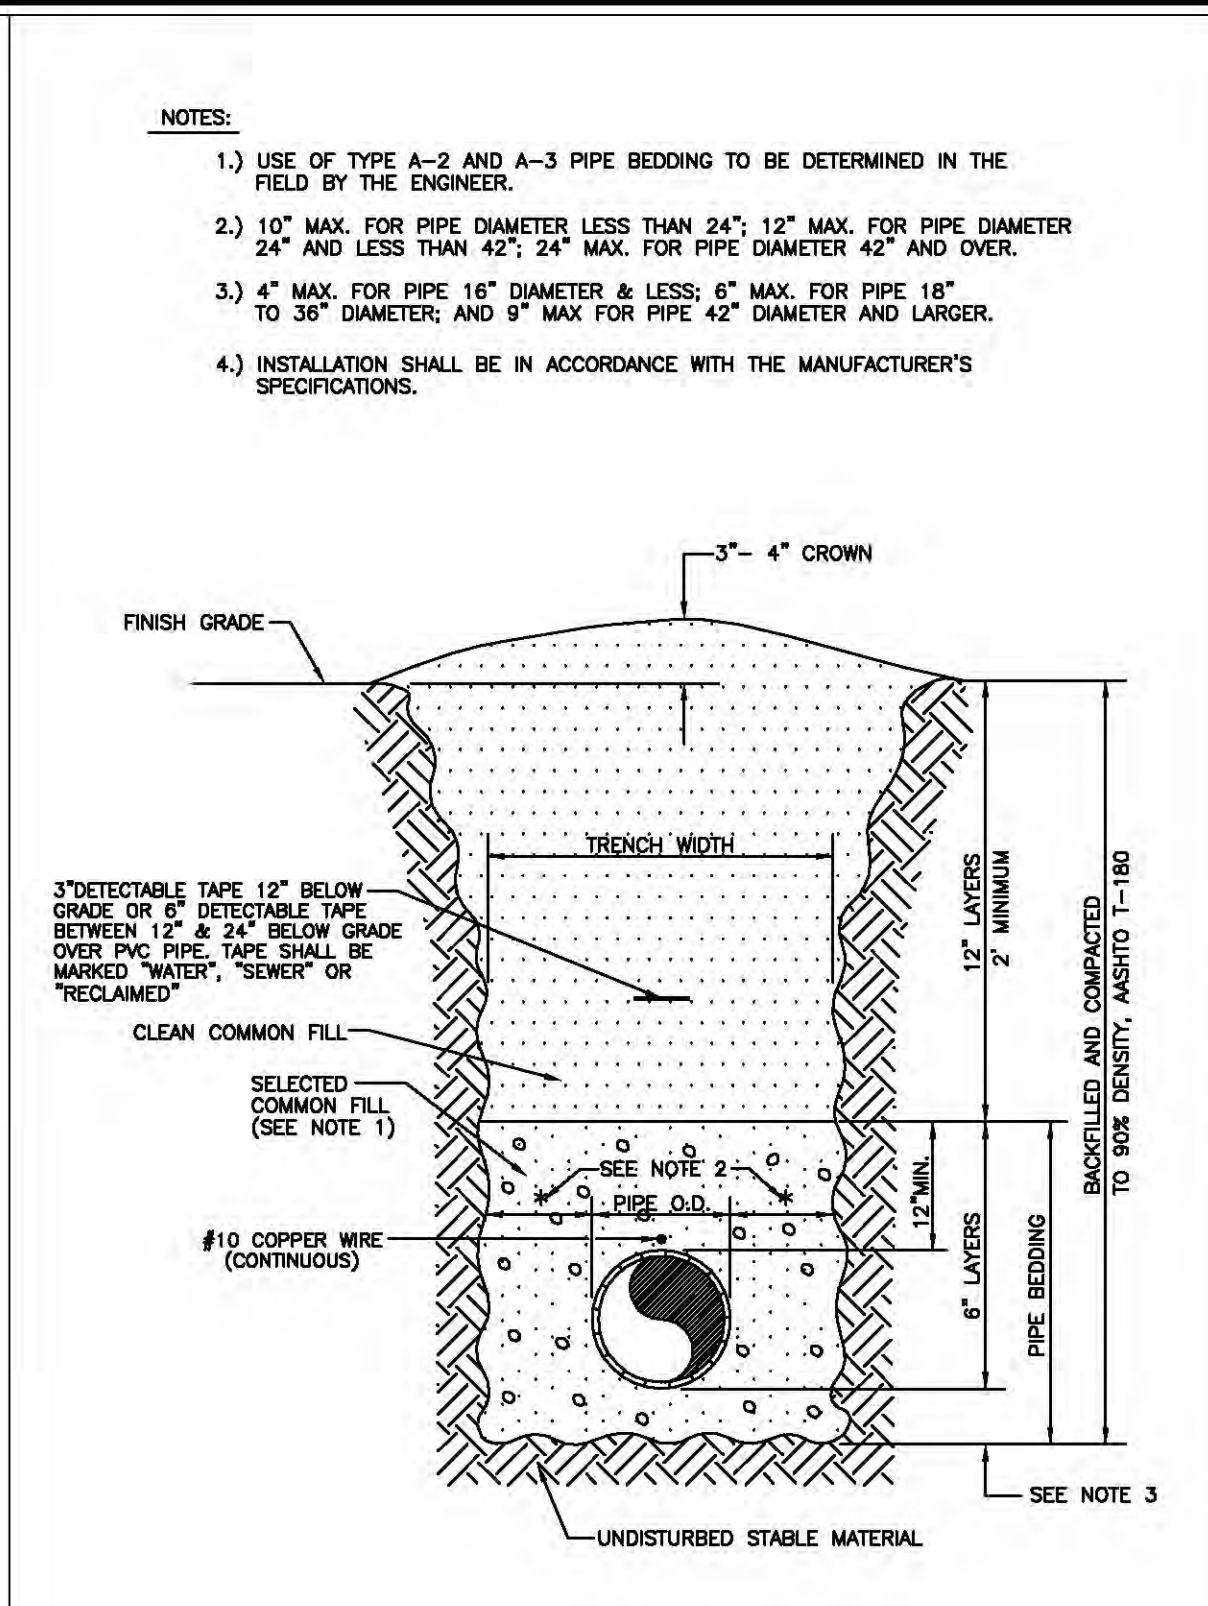

MANATEE COUNTY PUBLIC WORKS DEPARTMENT		TRENCH WITH UNIMPROVED SURFACE TYPE A-1 PIPE BEDDING		UG-11	
REV. BY CLB/KE	DATE 2/05	DATE OF APPROVAL APRIL 25, 2006			

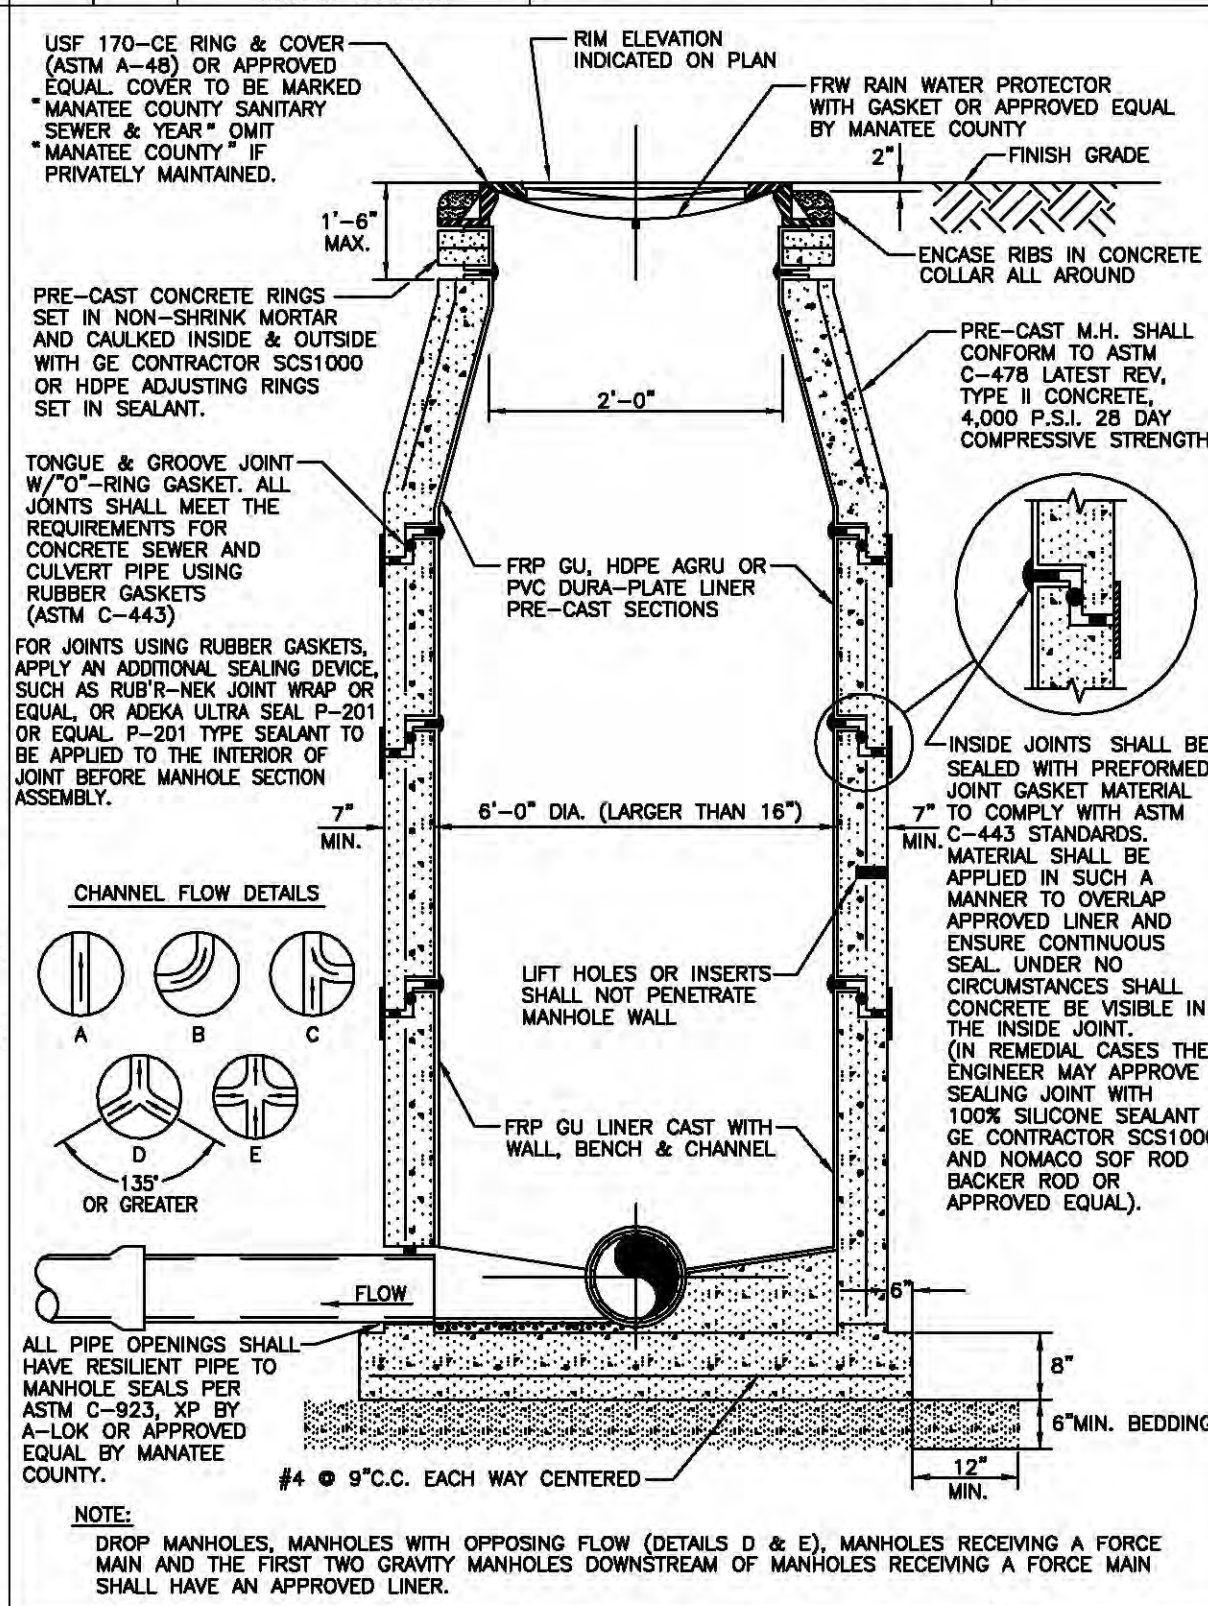

MANATEE COUNTY PUBLIC WORKS DEPARTMENT		STANDARD PRE-CAST SANITARY SEWER MANHOLE FOR TURBULENT FLOW		US-3	
REV. BY CLB/KE	DATE 8/05	DATE OF APPROVAL APRIL 25, 2006			


MANATEE COUNTY PUBLIC WORKS DEPARTMENT		TAPPING SLEEVE AND VALVE		UW-4	
REV. BY CLB/KE	DATE 8/05	DATE OF APPROVAL APRIL 25, 2006			

REQUIRED LENGTH OF RESTRAINED JOINT PIPE FOR DIP (POLY-WRAPPED)												
MAIN PIPE SIZE	HORIZ. BENDS			TEES			REDUCERS			PLUGS		
	90°	45°	22.5°	SIZE	LENGTH	SIZE	LENGTH	SIZE	LENGTH	SIZE	LENGTH	PLUGS
36	142	59	28	K30	K30	K24	K24	K20	K16	K16	K16	453
30	124	51	25	K24	K24	K18	K18	K14	K10	K10	K10	391
24	106	44	21	K18	K18	K12	K12	K9	K6	K6	K6	327
20	92	38	18	K12	K12	K8	K8	K6	K4	K4	K4	280
16	77	32	15	K8	K8	K6	K6	K4	K3	K3	K3	231
12	61	25	12	K6	K6	K4	K4	K3	K2	K2	K2	181
10	52	22	10	K4	K4	K3	K3	K2	K1	K1	K1	153
8	44	18	9	K3	K3	K2	K2	K1	K1	K1	K1	128
6	34	14	7	K2	K2	K1	K1	K1	K1	K1	K1	98
4	24	10	5	K1	K1	K1	K1	K1	K1	K1	K1	69


REQUIRED LENGTH OF RESTRAINED JOINT PIPE FOR DIP (NON-WRAPPED)												
MAIN PIPE SIZE	HORIZ. BENDS			TEES			REDUCERS			PLUGS		
	90°	45°	22.5°	SIZE	LENGTH	SIZE	LENGTH	SIZE	LENGTH	SIZE	LENGTH	PLUGS
36	100	42	20	K30	K30	K24	K24	K20	K16	K16	K16	188
30	88	37	18	K24	K24	K18	K18	K14	K10	K10	K10	162
24	75	31	15	K18	K18	K12	K12	K9	K6	K6	K6	135
20	65	27	13	K12	K12	K8	K8	K6	K4	K4	K4	116
16	54	22	11	K8	K8	K6	K6	K4	K3	K3	K3	96
12	43	18	8	K6	K6	K4	K4	K3	K2	K2	K2	75
10	37	15	7	K4	K4	K3	K3	K2	K1	K1	K1	63
8	30	13	6	K3	K3	K2	K2	K1	K1	K1	K1	53
6	24	10	5	K2	K2	K1	K1	K1	K1	K1	K1	41
4	17	7	3	K1	K1	K1	K1	K1	K1	K1	K1	29

NOTE:
SEE "RESTRAINED LENGTHS FOR PVC PIPE" DETAIL FOR NOTES 1 THROUGH 7.


MANATEE COUNTY PUBLIC WORKS DEPARTMENT		RESTRAINED LENGTHS FOR DIP		UG-9	
REV. BY CLB/KE	DATE 8/05	DATE OF APPROVAL APRIL 25, 2006			

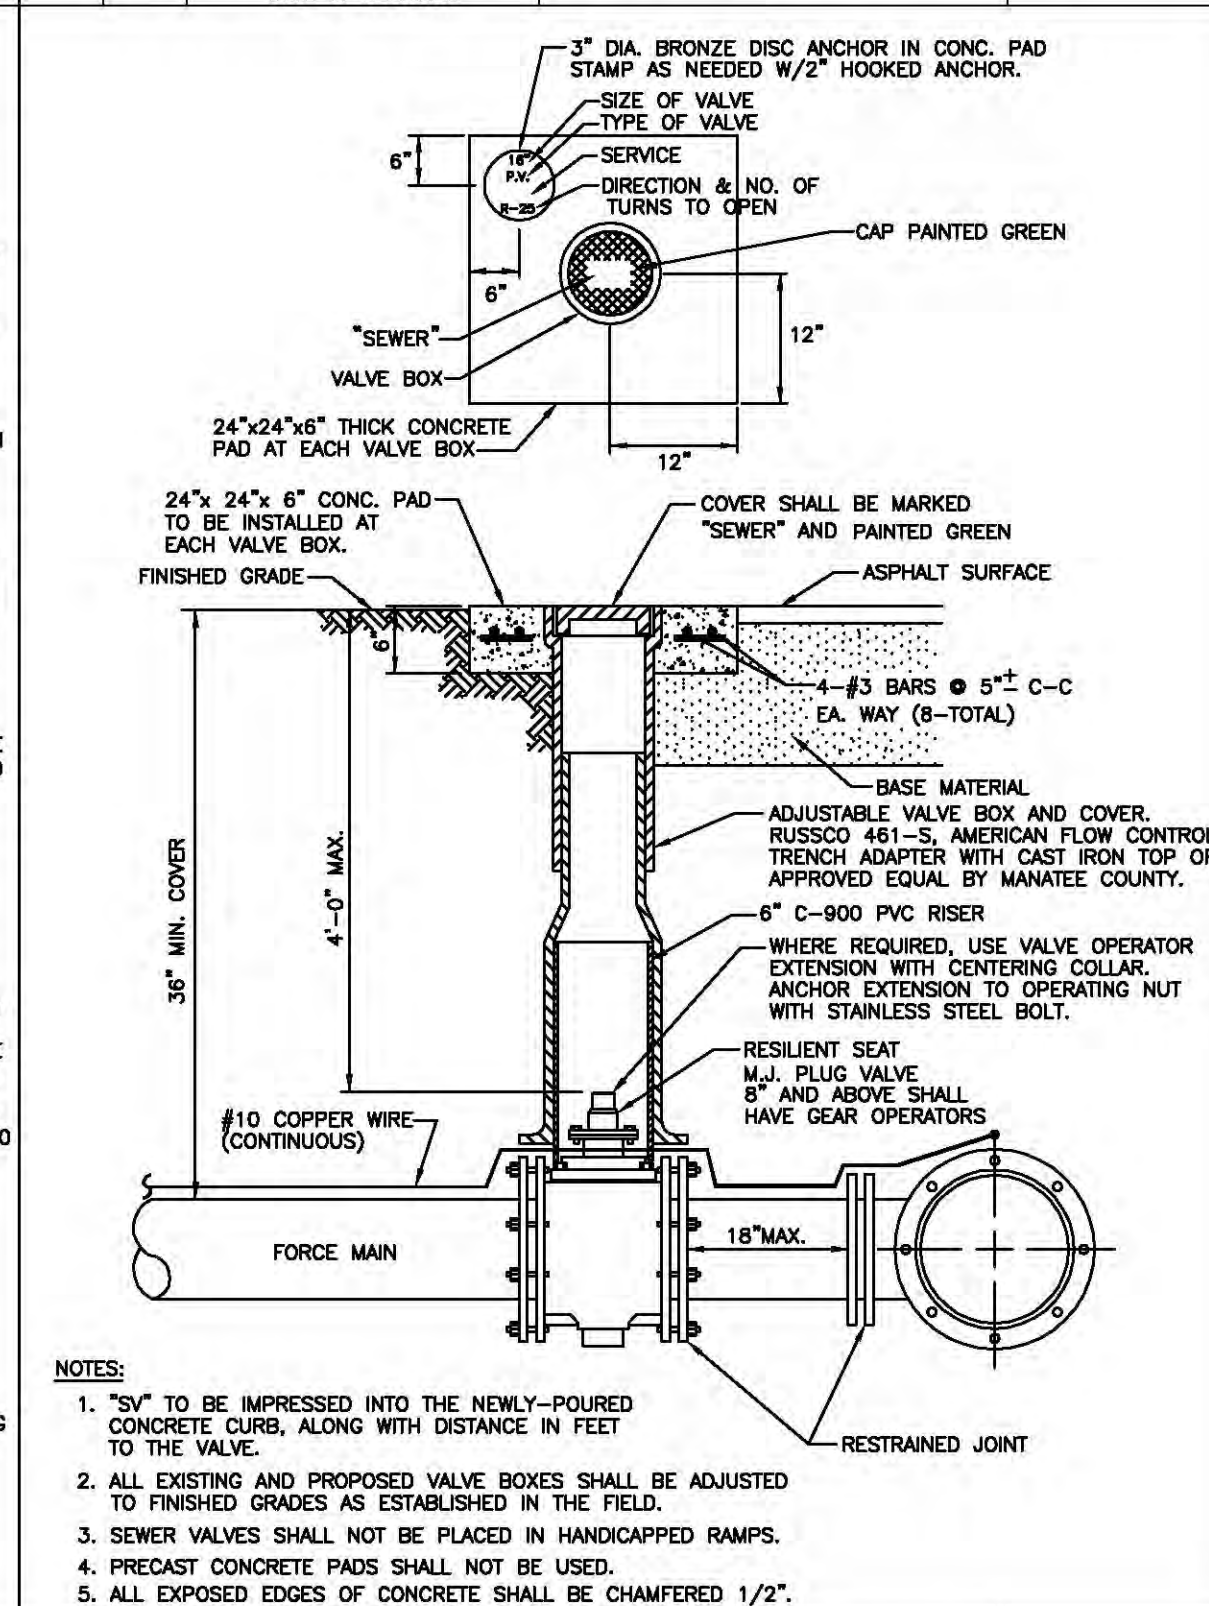

MANATEE COUNTY PUBLIC WORKS DEPARTMENT		PLUG VALVE, BOX, COVER AND TAG		US-12	
REV. BY CLB/KE	DATE 8/05	DATE OF APPROVAL APRIL 25, 2006			

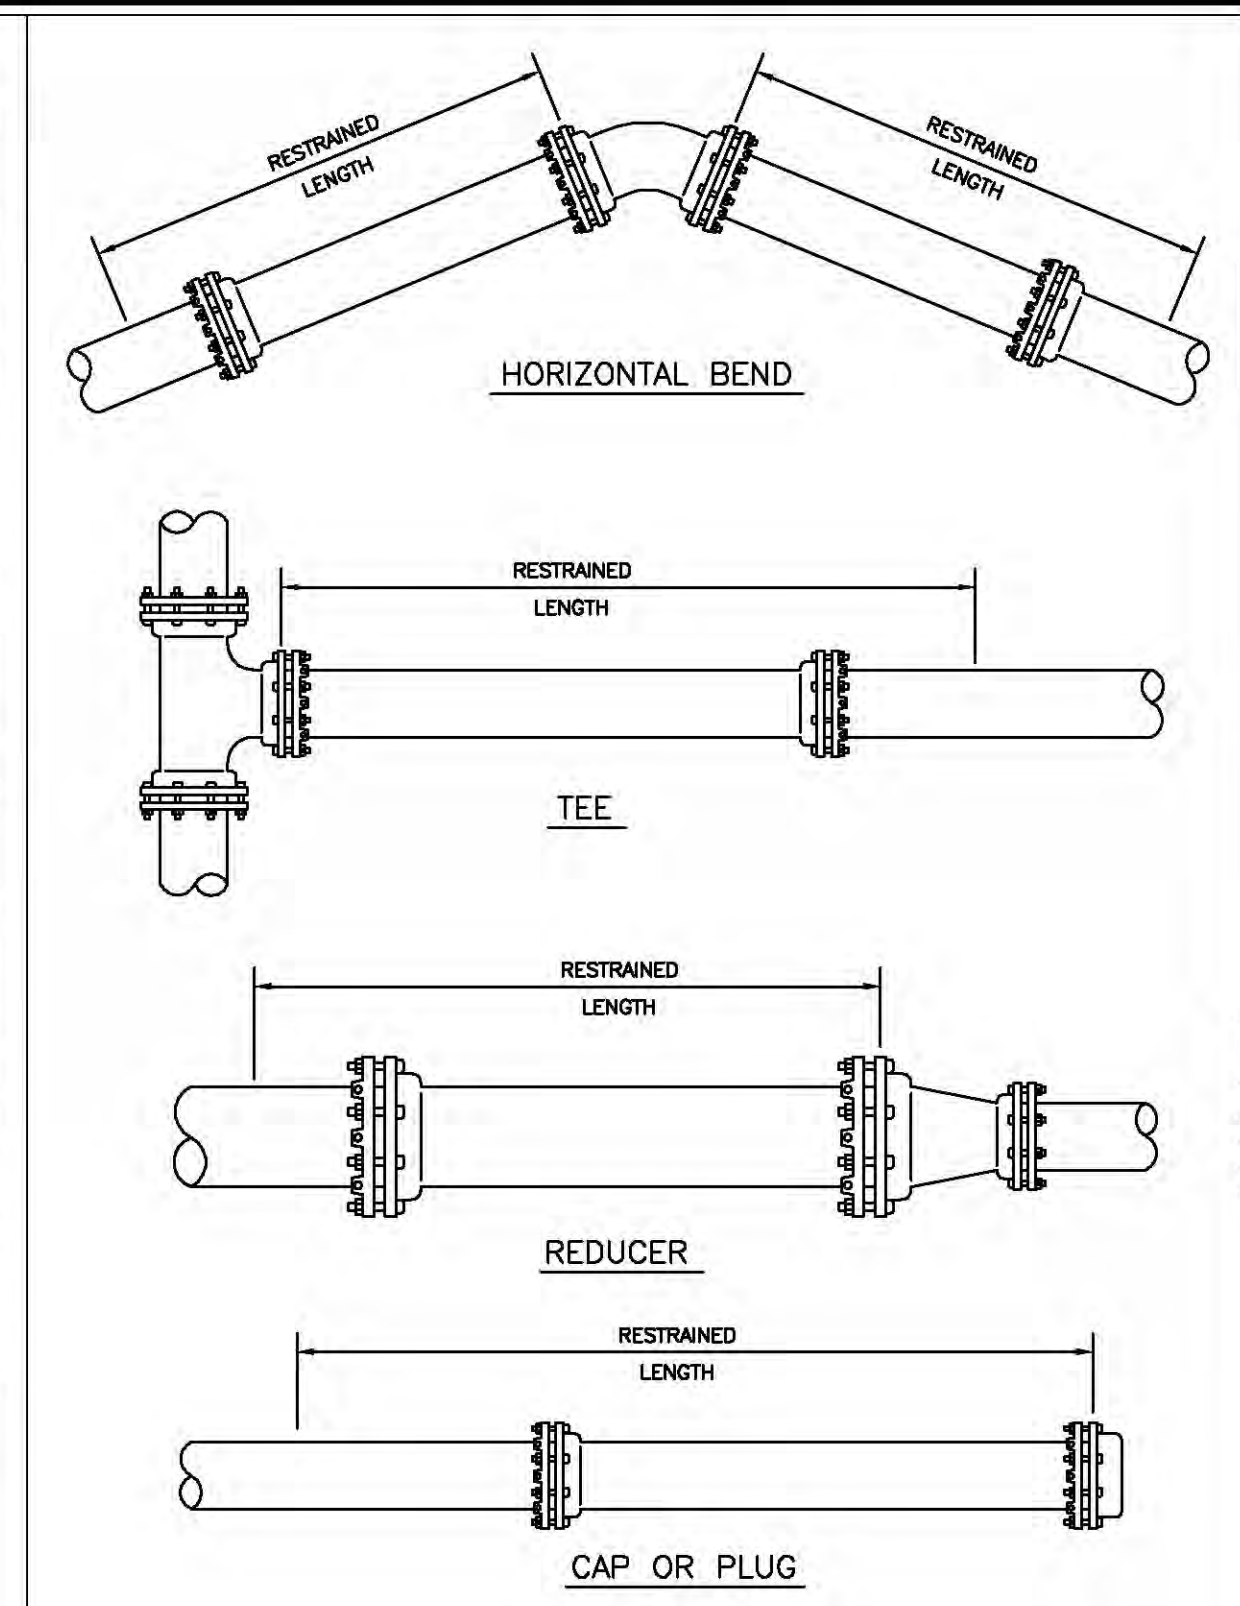

MANATEE COUNTY PUBLIC WORKS DEPARTMENT		RESTRAINED LENGTHS FOR PIPE		UG-10	
REV. BY CLB/KE	DATE 8/05	DATE OF APPROVAL APRIL 25, 2006			

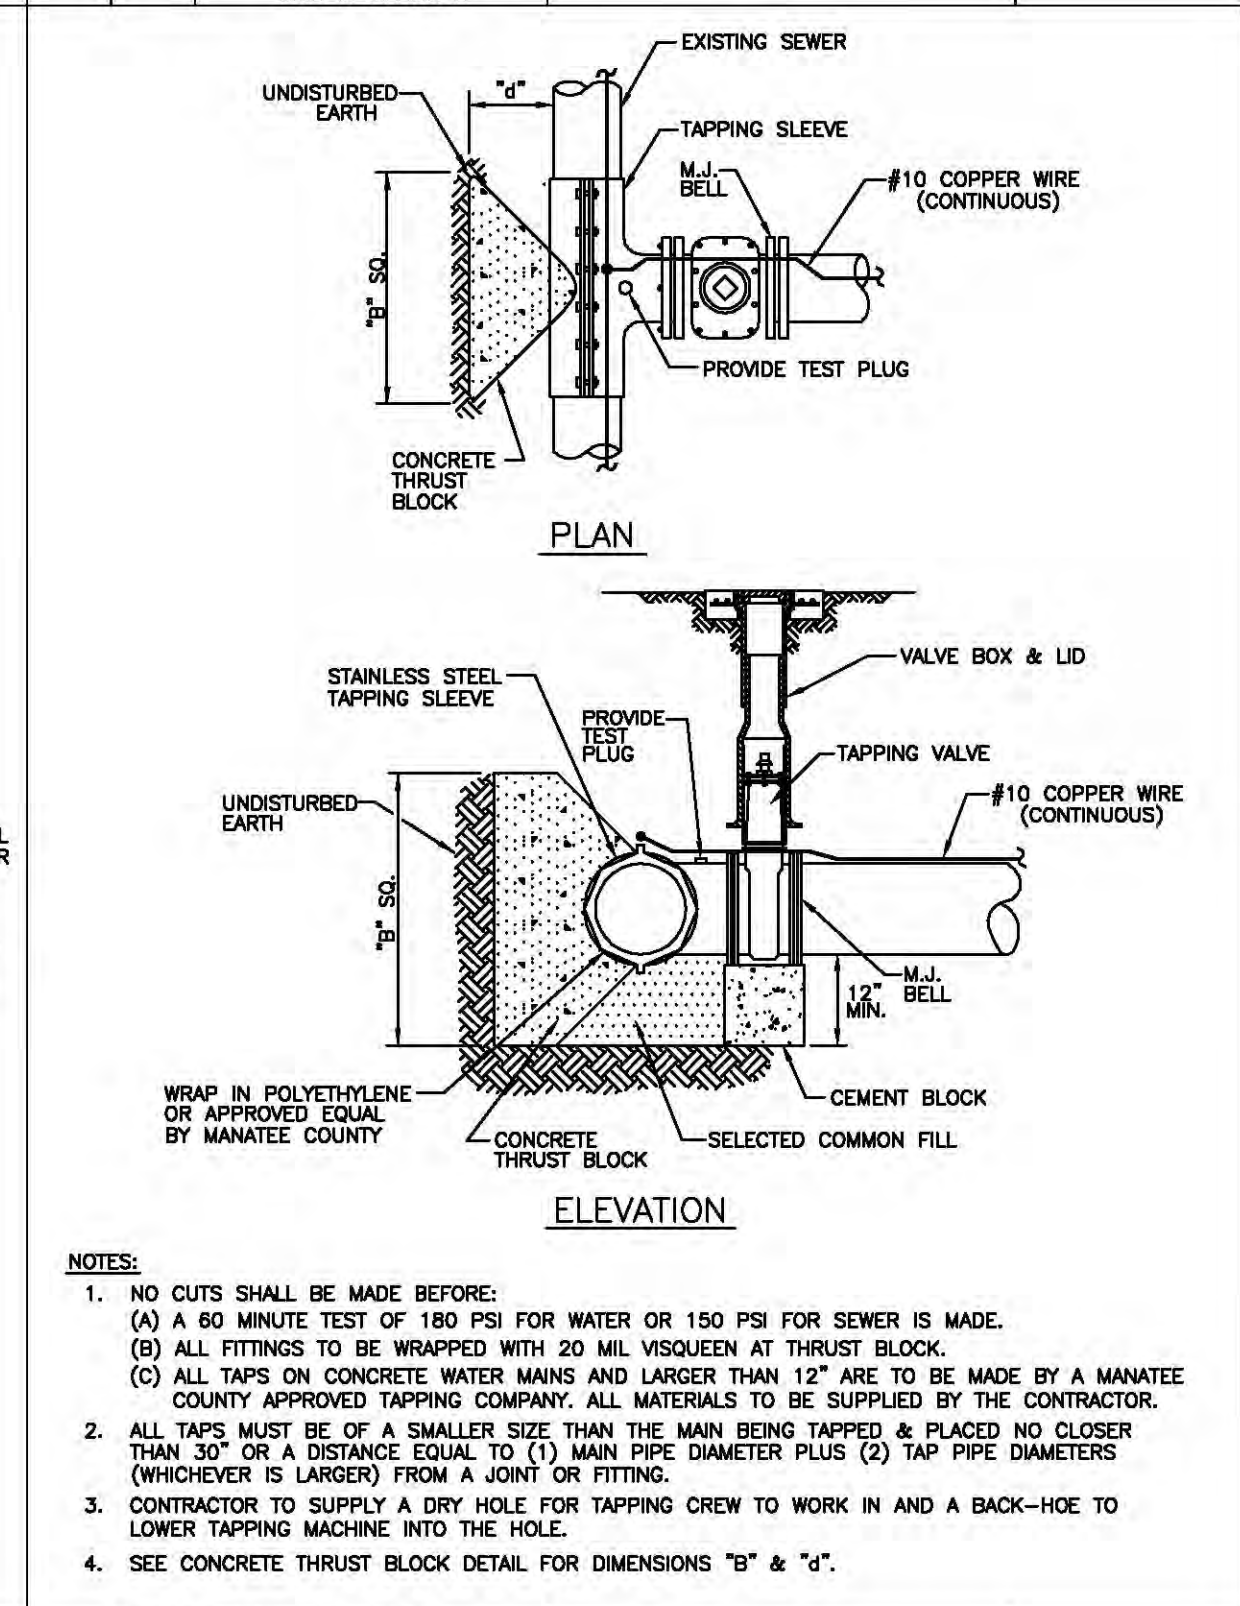

MANATEE COUNTY PUBLIC WORKS DEPARTMENT		TAPPING SLEEVE AND VALVE		UW-4	
REV. BY CLB/KE	DATE 8/05	DATE OF APPROVAL APRIL 25, 2006			

REQUIRED LENGTH OF RESTRAINED JOINT PIPE FOR DR-18 PVC PIPE												
MAIN PIPE SIZE	HORIZ. BENDS			TEES			REDUCERS			PLUGS		
	90°	45°	22.5°	SIZE	LENGTH	SIZE	LENGTH	SIZE	LENGTH	SIZE	LENGTH	PLUGS
24	90	38	18	K24	K24	K18	K18	K14	K10	K10	K10	214
20	78	32	16	K18	K18	K12	K12	K9	K6	K6	K6	184
16	66	27	13	K12	K12	K8	K8	K6	K4	K4	K4	151
12	52	22	10	K8	K8	K6	K6	K4	K3	K3	K3	118
10	44	18	9	K6	K6	K4	K4	K3	K2	K2	K2	100
8	37	15	7	K4	K4	K3	K3	K2	K1	K1	K1	83
6	29	12	6	K3	K3	K2	K2	K1	K1	K1	K1	63
4	21	8	4	K2	K2	K1	K1	K1	K1	K1	K1	45

NOTES:

1.) RESTRAIN 11.25° BENDS 50% OF LENGTH FOR 22.5° BENDS.

2.) ALL VALVES AND FITTINGS SHALL BE RESTRAINED TO THE CONNECTING SECTIONS OF PIPE.

3.) ALL VALVES MUST BE PROPERLY ANCHORED OR RESTRAINED TO RESIST A 180 PSI TEST PRESSURE IN EITHER DIRECTION.


4.) PIPE SIZES ARE GIVEN IN INCHES.

5.) RESTRAINED PIPE LENGTHS ARE GIVEN IN FEET.

6.) LENGTHS SHOWN ARE FOR A TEST PRESSURE OF 180 PSI.

7.) THE RESTRAINED LENGTHS SHOWN IN THESE TABLES ARE BASED ON SOIL CLASSIFICATION SP WITH AWWA TYPE 3 TRENCH CONDITIONS, 180 PSI TEST PRESSURE, 3 FEET OF COVER AND 1.5 FACTOR OF SAFETY. ACTUAL BURY CONDITIONS MUST BE DETERMINED BY THE ENGINEER OF RECORD AND THE RESTRAINED LENGTHS MODIFIED ACCORDINGLY.

MANATEE COUNTY PUBLIC WORKS DEPARTMENT		RESTRAINED LENGTHS FOR PVC PIPE		UG-8	
REV. BY CLB/KE	DATE 2/05	DATE OF APPROVAL APRIL 25, 2006			

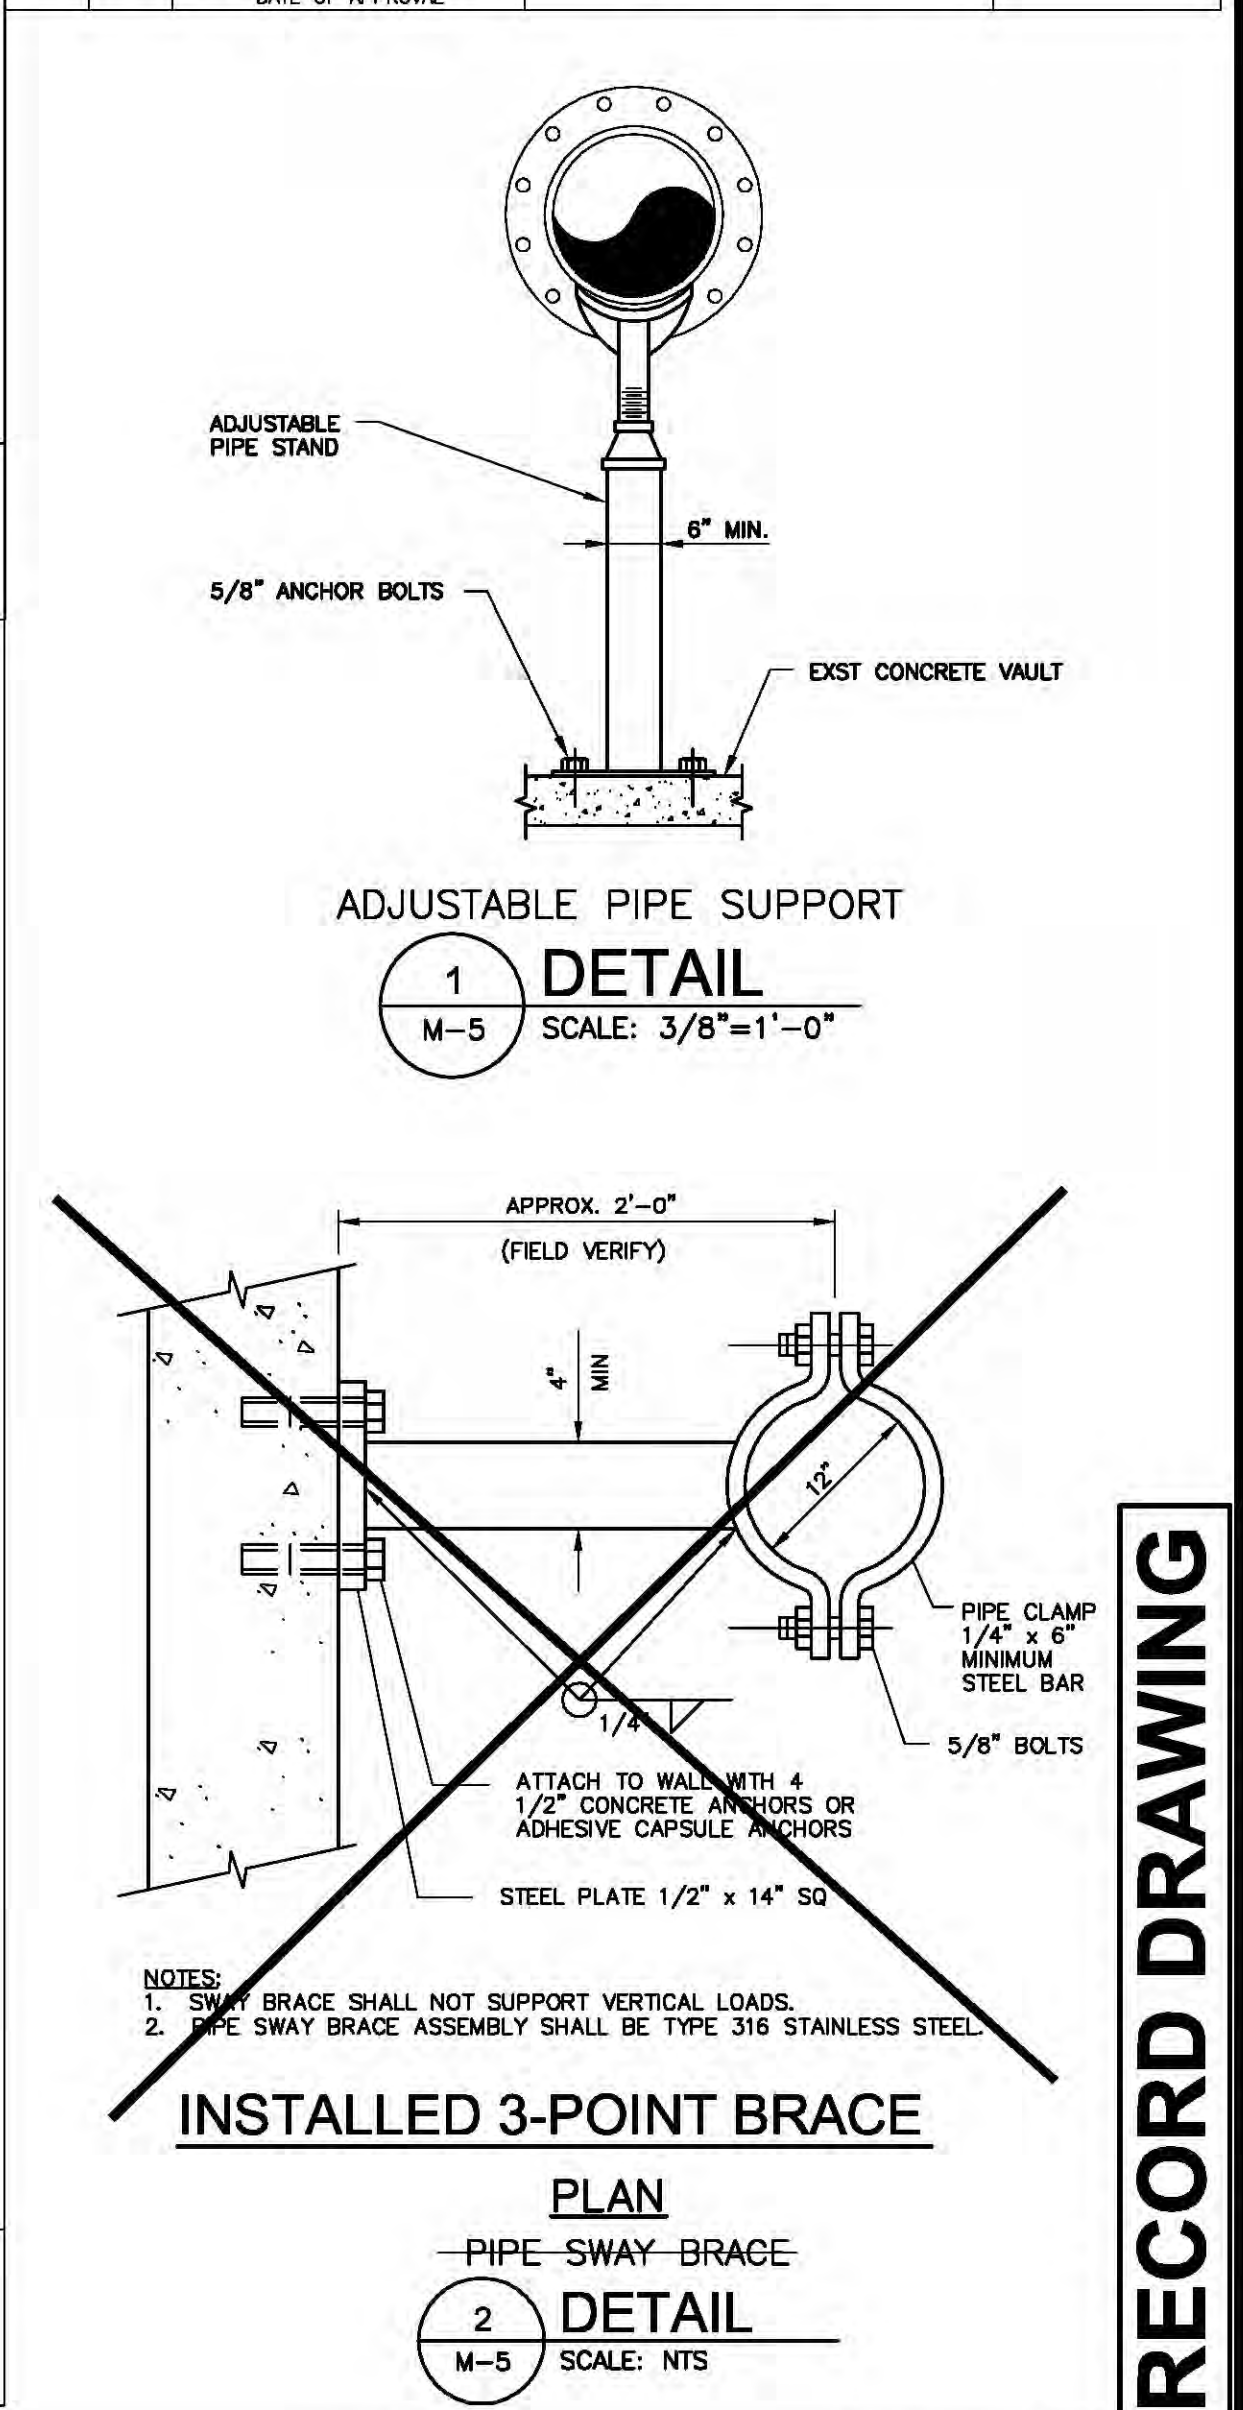

MANATEE COUNTY PUBLIC WORKS DEPARTMENT		TAPPING SLEEVE AND VALVE		UW-4	
REV. BY CLB/KE	DATE 8/05	DATE OF APPROVAL APRIL 25, 2006			

URS

7650 West Courtney Campbell Causeway
Suite 700
Tampa, Florida 33607
Ph: (813) 286-1711 Fax: (813) 286-6587
Florida Engineering Number: 000002

NO.	BY	DATE	DESCRIPTION
			REVISIONS

URS JOB NUMBER 12007391	
PM: C. OSMANSKI	
ENG: C. OSMANSKI	
DRW: J. SCHEUERMAN	
FILE SAVE DATE: May 14, 2010	



IMPROVEMENTS AT
TARA #20 MASTER LIFT STATION
FOR
MANATEE COUNTY GOVERNMENT
MANATEE COUNTY, FLORIDA



CIVIL DETAILS

PROJECT STATUS RECORD DRAWINGS MAY 2010	
CRAIG P. OSMANSKI FLORIDA P.E. NO. 46961	
C-3	

RECORD DRAWING

VERIFY SCALES: BAR IS ONE INCH ON ORIGINAL DRAWING 0 1 IF NOT ONE INCH ON THIS SHEET, ADJUST SCALE ACCORDINGLY

PLOTTED June 15, 2006 3:51 PM PLOTTED BY: SCHEUERMANN, JAMES
X:\MANATEE PROJECTS\12007391 TARA # 20 MASTER LIFT STATION - W44\CADD\M-2 PUMP STATION DEMO LOWER PLAN.DWG

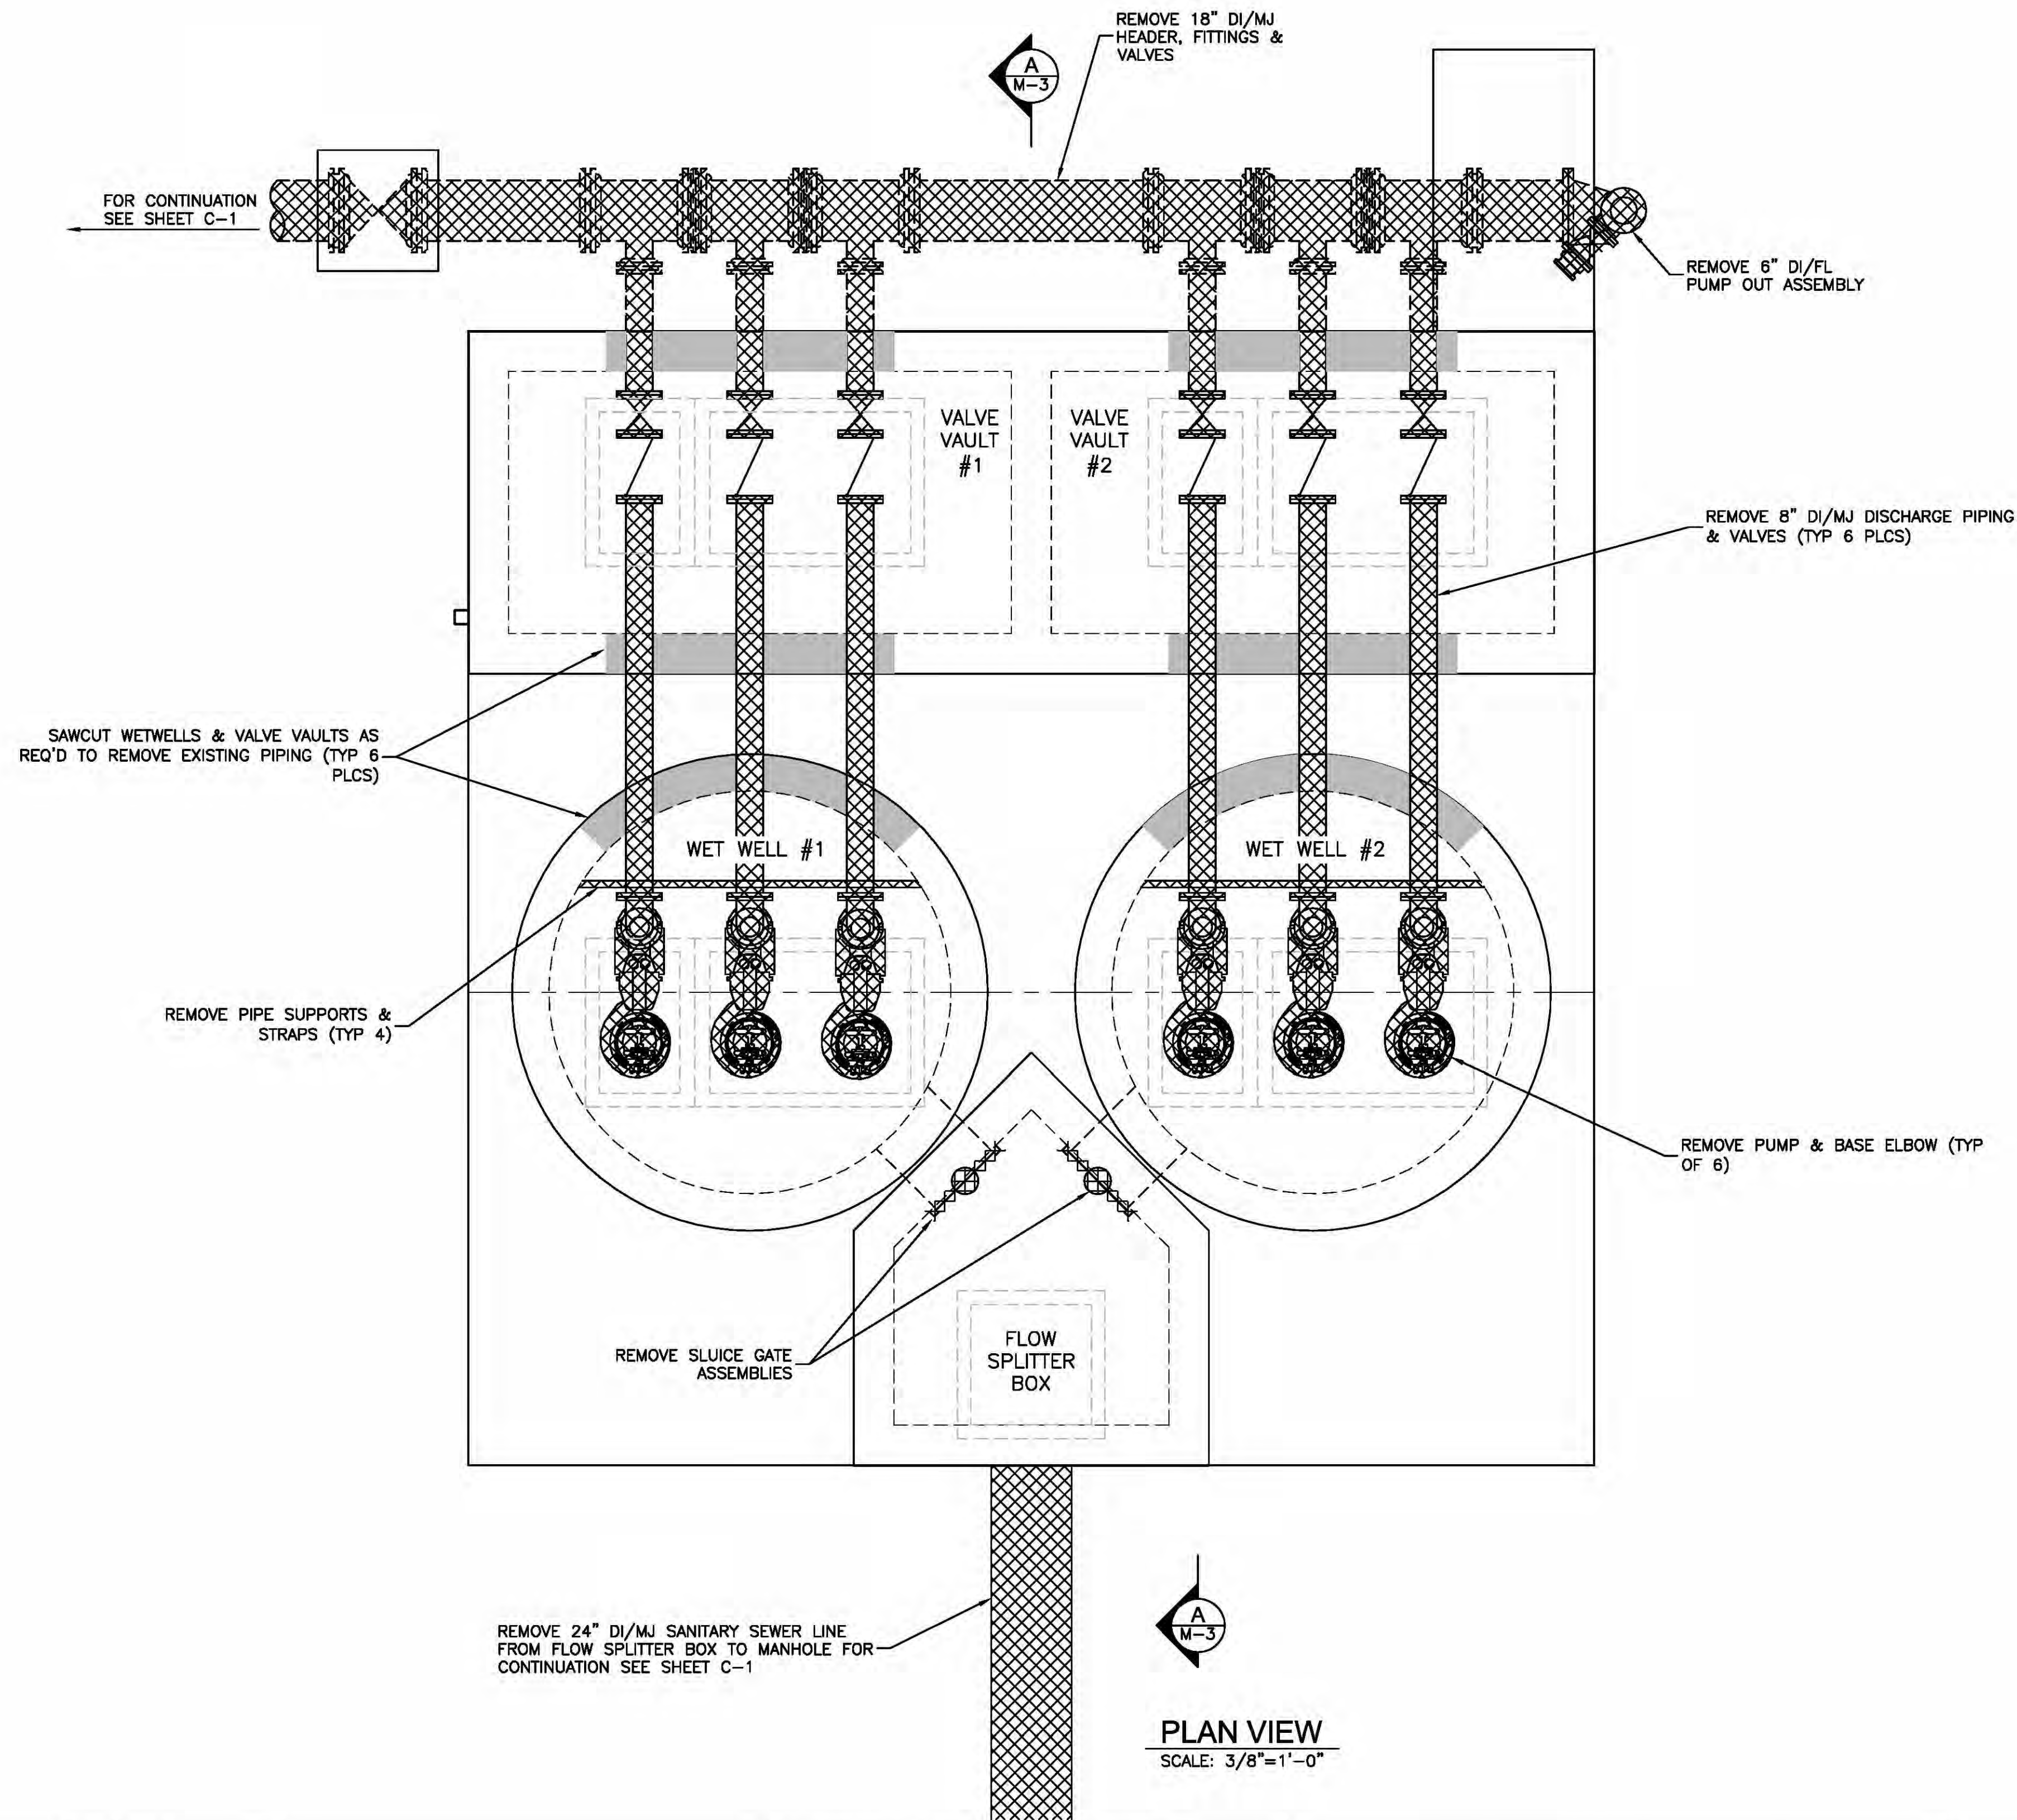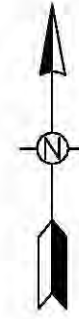

LEGEND

TO BE REMOVED

NOTE:
1. CONTRACTOR SHALL USE EXTREME CAUTION WHEN SAWCUTTING WETWELLS TO PREVENT DAMAGE TO THE FIBERGLASS LINER.

PLAN VIEW
SCALE: 3/8"=1'-0"

RECORD DRAWING

URS

7650 West Courtney Campbell Causeway
Suite 700
Tampa, Florida 33607
Ph: (813) 286-1711 Fax: (813) 286-6587
Florida Engineering Number: 000002

NO.	BY	DATE	DESCRIPTION
REVISIONS			

URS JOB NUMBER
12007391
PM: C. OSMANSKI
ENG: C. OSMANSKI
DRW: J. SCHEUERMANN
FILE SAVE DATE:
June 8, 2010



IMPROVEMENTS AT
TARA #20 MASTER LIFT STATION
FOR
MANATEE COUNTY GOVERNMENT
MANATEE COUNTY, FLORIDA

PUMP STATION DEMO LOWER PLAN


CRAIG P. OSMANSKI
FLORIDA P.E. NO. 48961

PROJECT STATUS
RECORD DRAWINGS
MAY 2010

M-2

VERIFY SCALES: BAR IS ONE INCH ON ORIGINAL DRAWING 0 1 IF NOT ONE INCH ON THIS SHEET, ADJUST SCALE ACCORDINGLY

PLOTTED June 15, 2006 3:51 PM PLOTTED BY: SCHEUERMANN, JAMES
X:\MANATEE PROJECTS\12007391 TARA # 20 MASTER LIFT STATION - W44\CADD\1-3 PUMP STATION DEMO SECTION.DWG

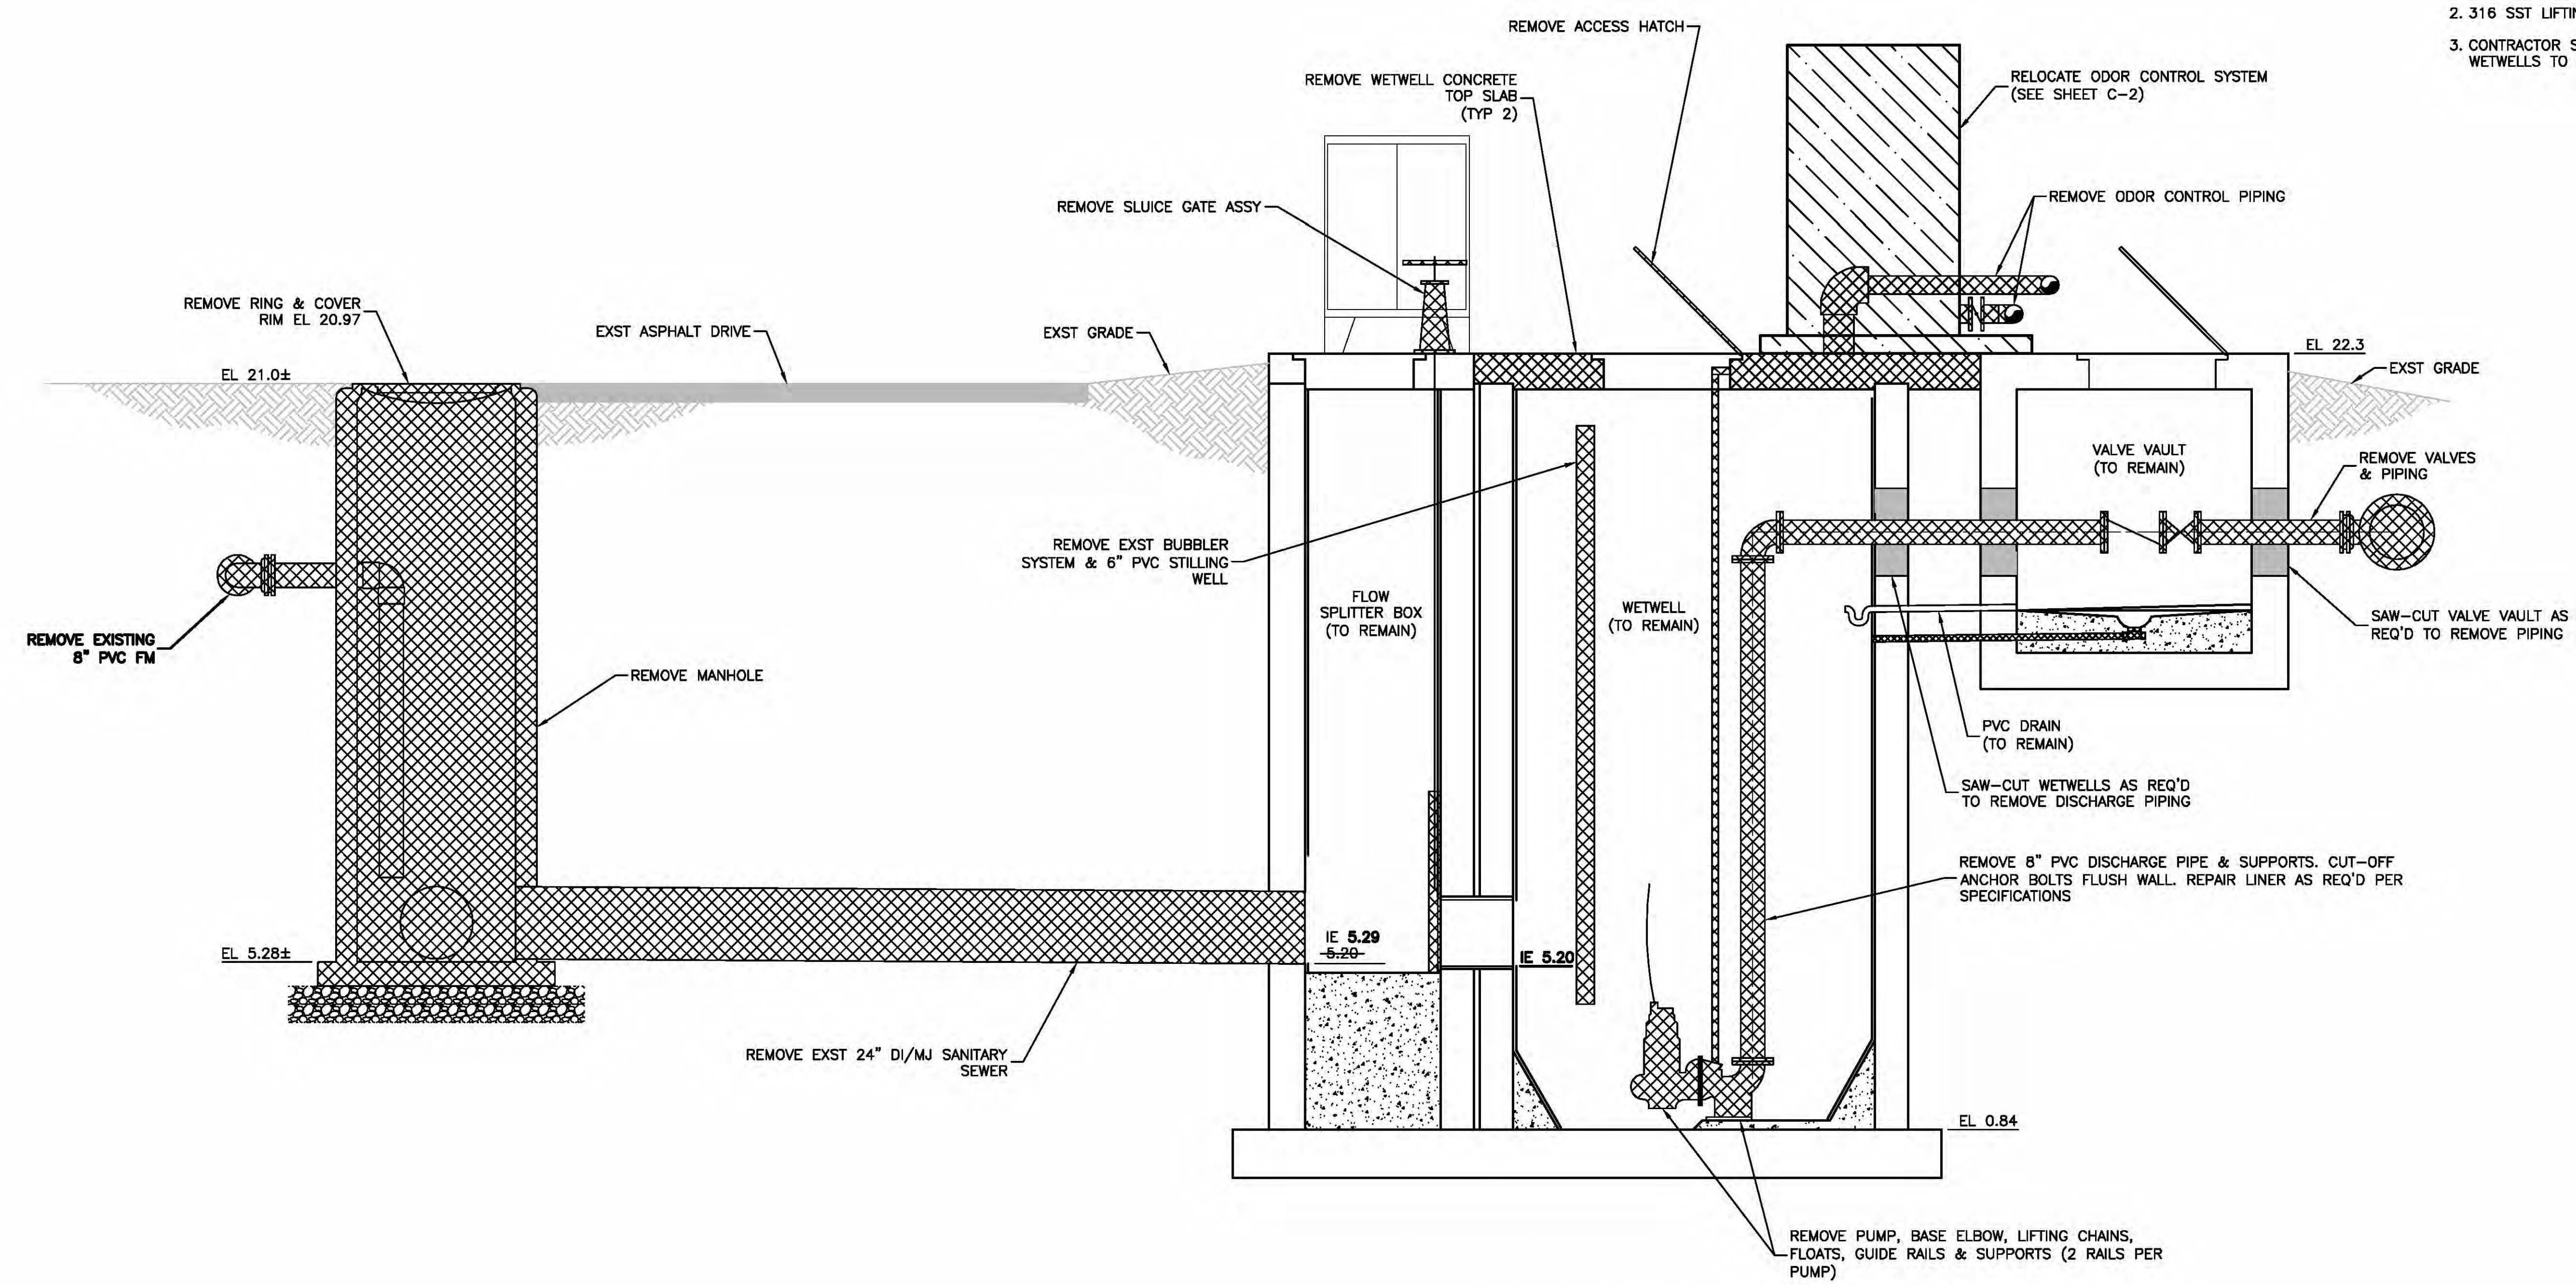

LEGEND


TO BE REMOVED

- NOTES:
1. SAWCUT ANCHOR BOLTS FOR SLUICE GATES, PIPE SUPPORTS & PUMP BASE ELBOWS FLUSH WITH SURFACE. ANCHOR BOLTS FOR SLUICE GATES & VERTICAL PIPE SUPPORTS SHALL BE DRILLED OUT 1-INCH DEEP & THE HOLES PATCHED WITH NON-SHRINK GROUT. PATCH LINER TO MATCH EXISTING LINER. (REFER TO SPECIFICATIONS)
 2. 316 SST LIFTING CHAINS TO BE RETURNED TO MANATEE COUNTY.
 3. CONTRACTOR SHALL USE EXTREME CAUTION WHEN SAWCUTTING WETWELLS TO PREVENT DAMAGE TO THE FIBERGLASS LINER.

A SECTION
M-1/2 SCALE: 3/8"=1'-0"

RECORD DRAWING

 7650 West Courtney Campbell Causeway Suite 700 Tampa, Florida 33607 Ph: (813) 286-1711 Fax: (813) 286-6587 Florida Engineering Number: 000002			URS JOB NUMBER 12007391		IMPROVEMENTS AT TARA #20 MASTER LIFT STATION FOR MANATEE COUNTY GOVERNMENT MANATEE COUNTY, FLORIDA	PUMP STATION DEMO SECTION	CRAIG P. OSMANSKI FLORIDA P.E. NO. 48961	PROJECT STATUS RECORD DRAWINGS MAY 2010
			PM: C. OSMANSKI					M-3
			ENG: C. OSMANSKI					
			DRW: J. SCHEUERMANN					
NO. BY DATE DESCRIPTION		FILE SAVE DATE: June 7, 2010						
REVISIONS								

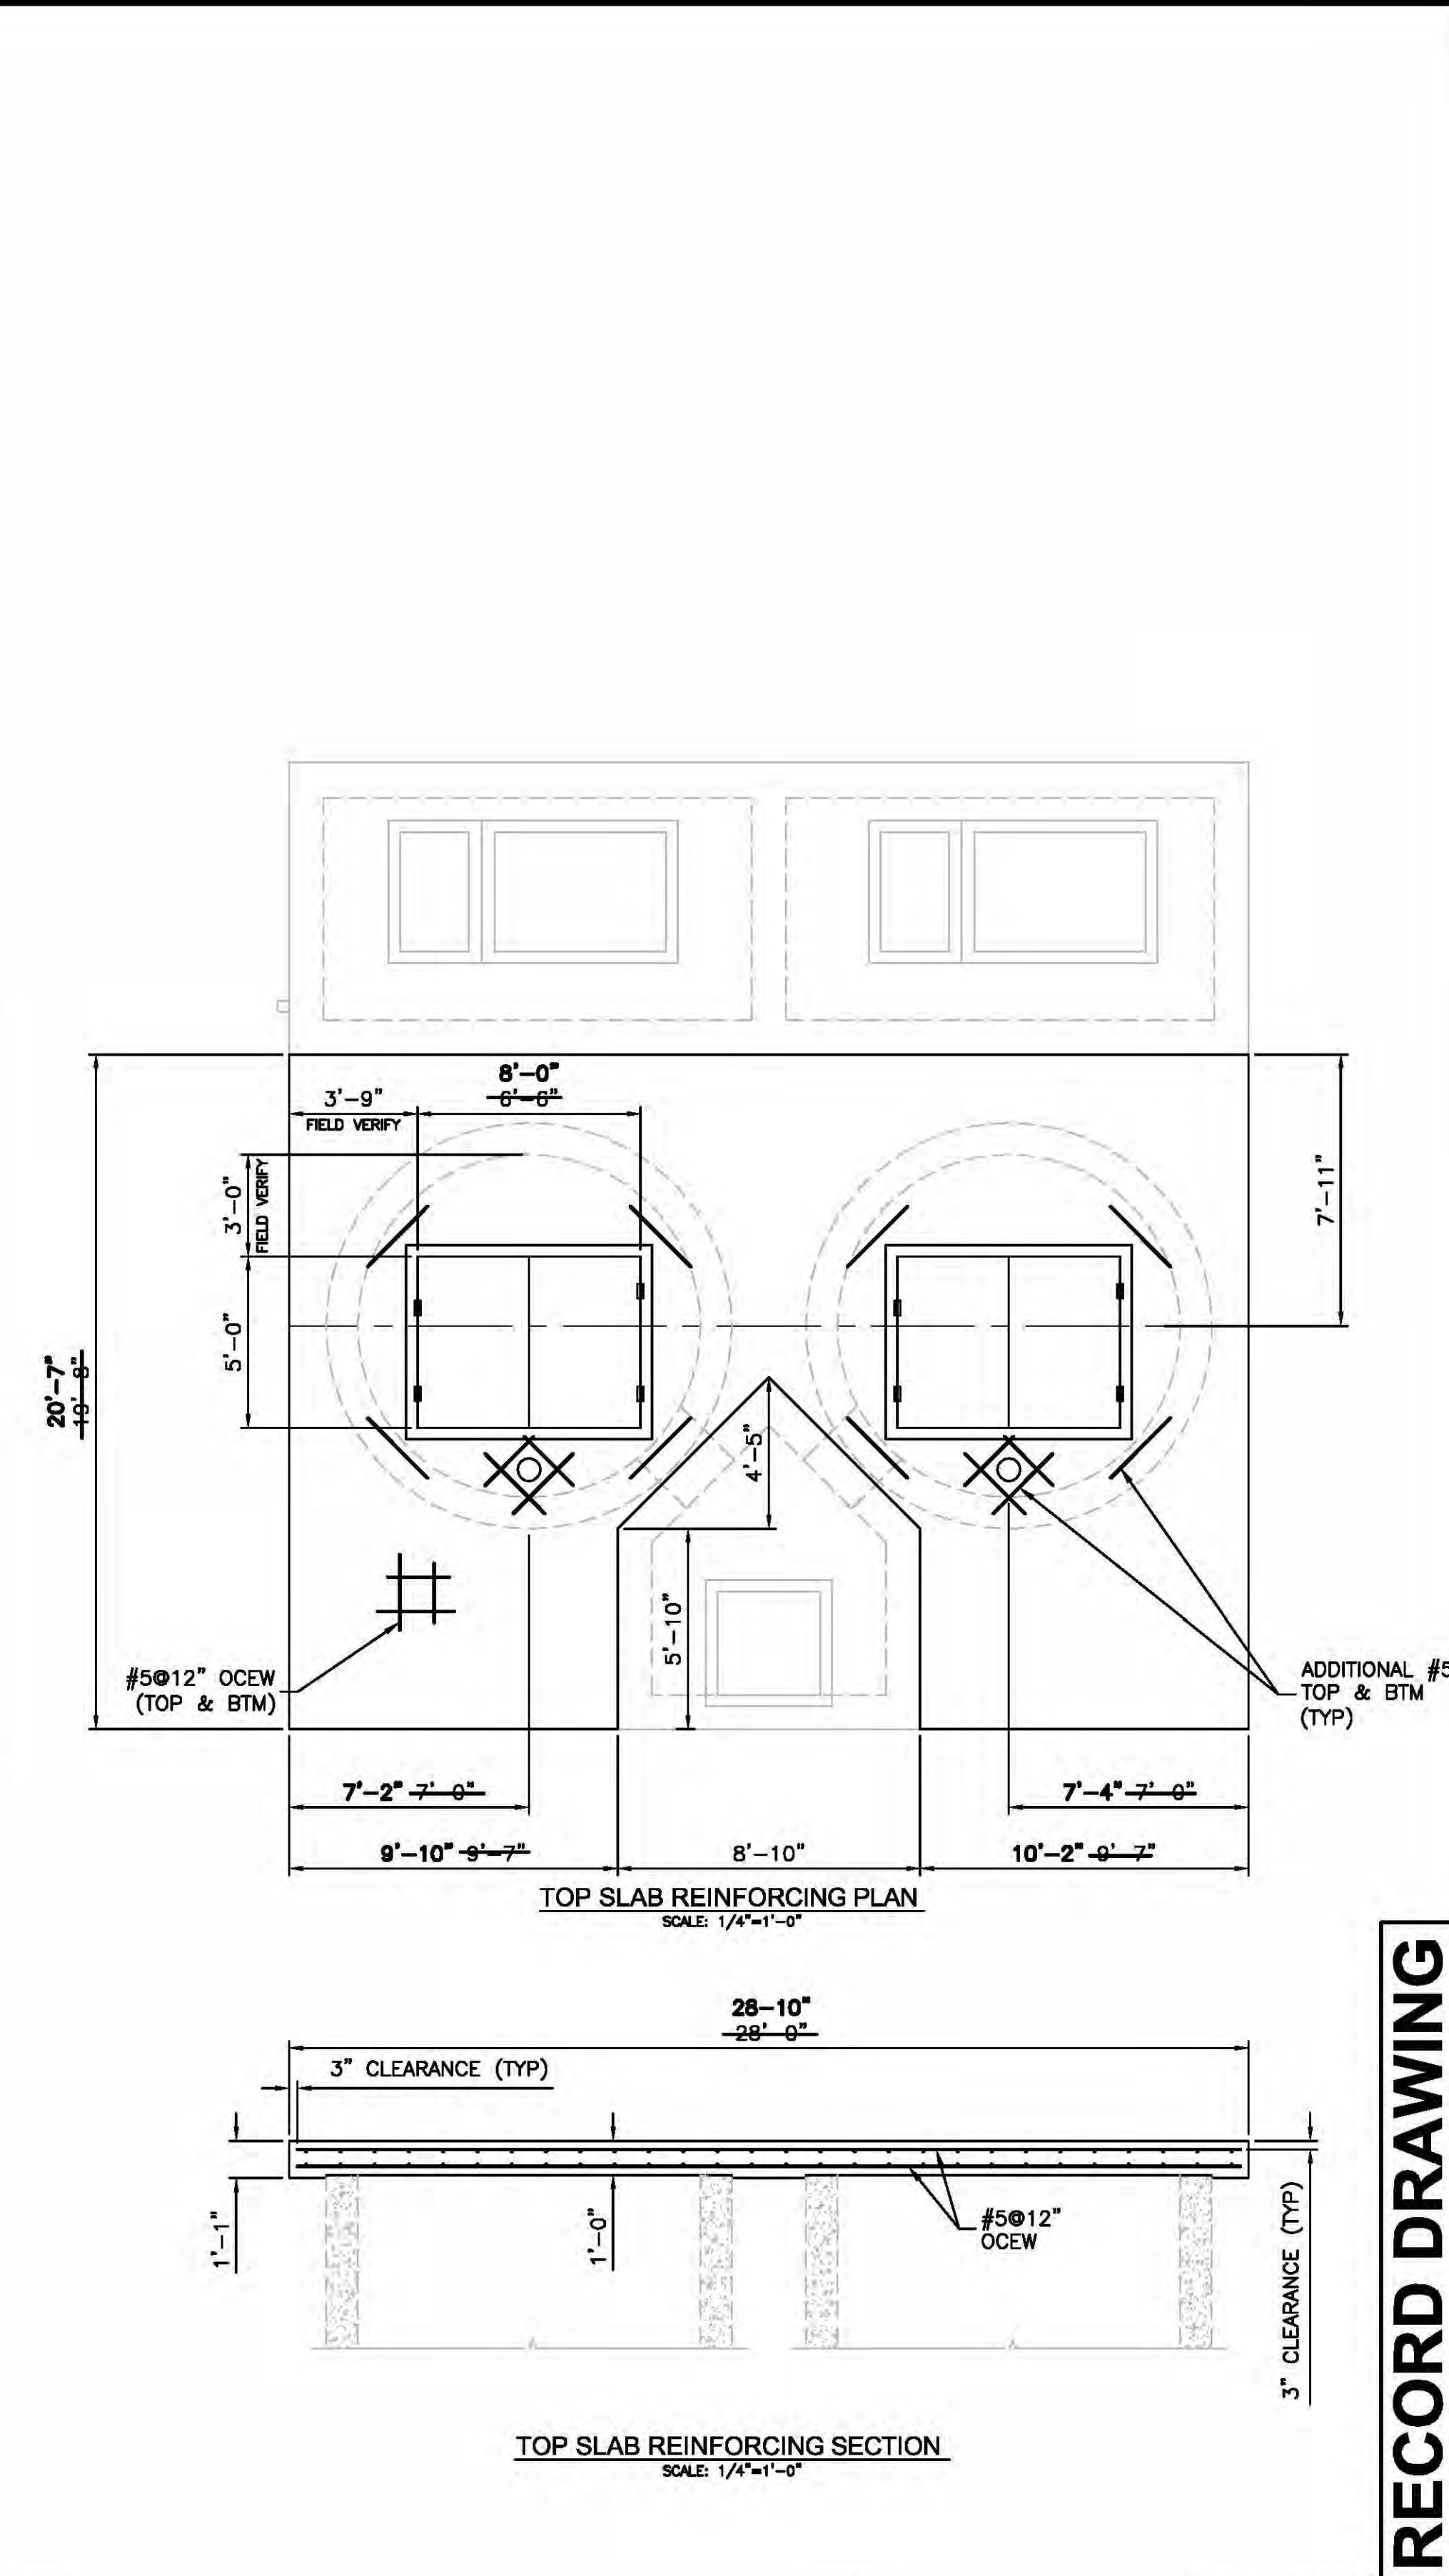

NO.	BY	DATE	DESCRIPTION
REVISIONS			

URS JOB NUMBER
12007391
M: C. OSMANSKI
NG: C. OSMANSKI
RW: J. SCHEUERMAN
LE SAVE DATE:
June 8, 2010



IMPROVEMENTS AT
TARA #20 MASTER LIFT STATION
FOR
MANATEE COUNTY GOVERNMENT
MANATEE COUNTY, FLORIDA

PUMP STATION PROPOSED PLAN

CRAIG P. OSMANSKI
FLORIDA P.E. NO. 48961


PROJECT STATUS
RECORD DRAWINGS
MAY 2010

M-4



FLOAT SWITCH TABLE		
ITEM	ELEVATION	DESCRIPTION
C	9.00	HIGH WATER LEVEL ALARM
B	4.00	PUMPS OFF
A	3.60	LWL ALARM

RECORD DRAWING

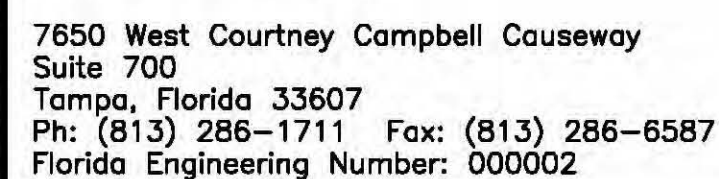[illegible]

URS JOB NUMBER
12007391
NAME: C. OSMANSKI
FNAME: C. OSMANSKI
LNAME: J. SCHEUERMAN
FILE SAVE DATE:
June 8, 2010




IMPROVEMENTS AT
TARA #20 MASTER LIFT STATION
FOR
MANATEE COUNTY GOVERNMENT
MANATEE COUNTY, FLORIDA

PUMP STATION PROPOSED SECTION

CRAIG P. OSMANSKI
FLORIDA P.E. NO. 48961

PROJECT STATUS
RECORD DRAWINGS
MAY 2010

M-5

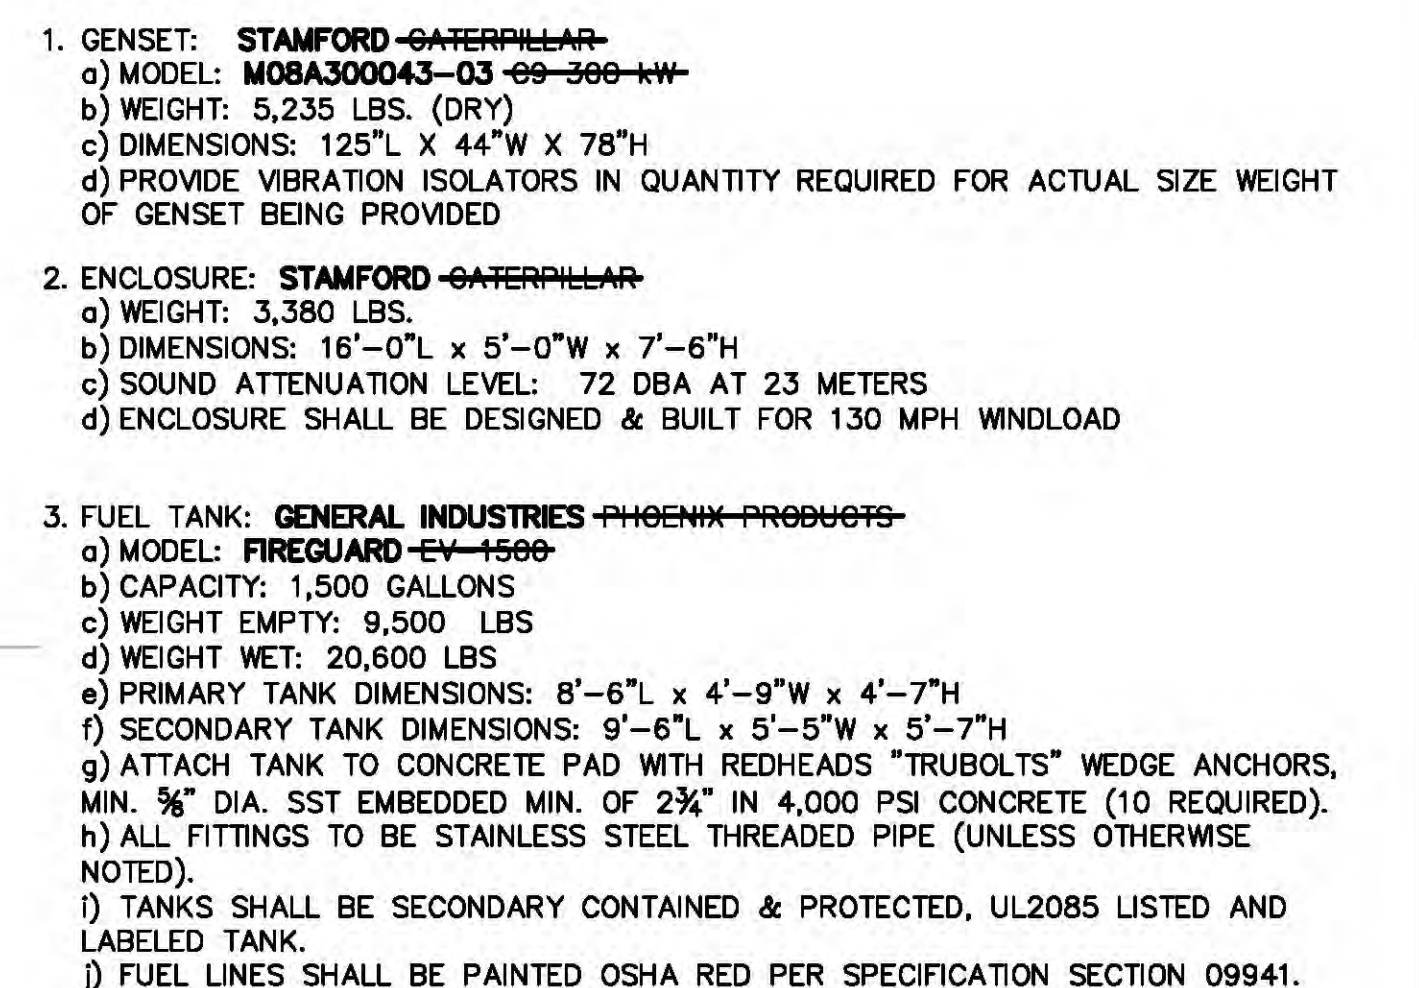

SECTION A

SCALE: 1/2"=1'-0"

Labels and Callouts:

- SOUND ATTENUATED ENCLOSURE
- GENERATOR
- CONTROL PANEL
- EXHAUST
- 1/2" BLACK STEEL FUEL SUPPLY & RETURN LINES
- SECONDARY TANK
- 6" EMERG. VENT
- GRADE FILL BOX W/ LOCKABLE LID, INTEGRAL SPILL CONTAINMENT, 3" FILL CONNECTION & FILL LIMITER
- PRIMARY TANK
- 4" CONCRETE SIDEWALK
- EQUIPMENT PAD
- 4" SIDEWALK
- EL. 21.30 ~~21.00~~ (FIELD VERIFY) MATCH EXST DRIVEWAY
- PROVIDE SST UNISTRUCT PIPING SUPPORT FOR FUEL PIPING (TYP)

Dimensions:

- 5'-3"
- 1'-10 1/2"
- 5'-0"

References:

- 7 C-4
- 6 C-4

RECORD DRAWING

[illegible]

URS JOB NUMBER
12007391
NAME: C. OSMANSKI
FIRM: C. OSMANSKI
PREPARED BY: J. SCHEUERMAN
DATE: June 8, 2010




IMPROVEMENTS AT
TARA #20 MASTER LIFT STATION
FOR
MANATEE COUNTY GOVERNMENT
MANATEE COUNTY, FLORIDA

GENERATOR ENCLOSURE & FUEL TANK

CRAIG P. OSMANSKI
FLORIDA P.E. NO. 48961


PROJECT STATUS
RECORD DRAWINGS
MAY 2010

M-6

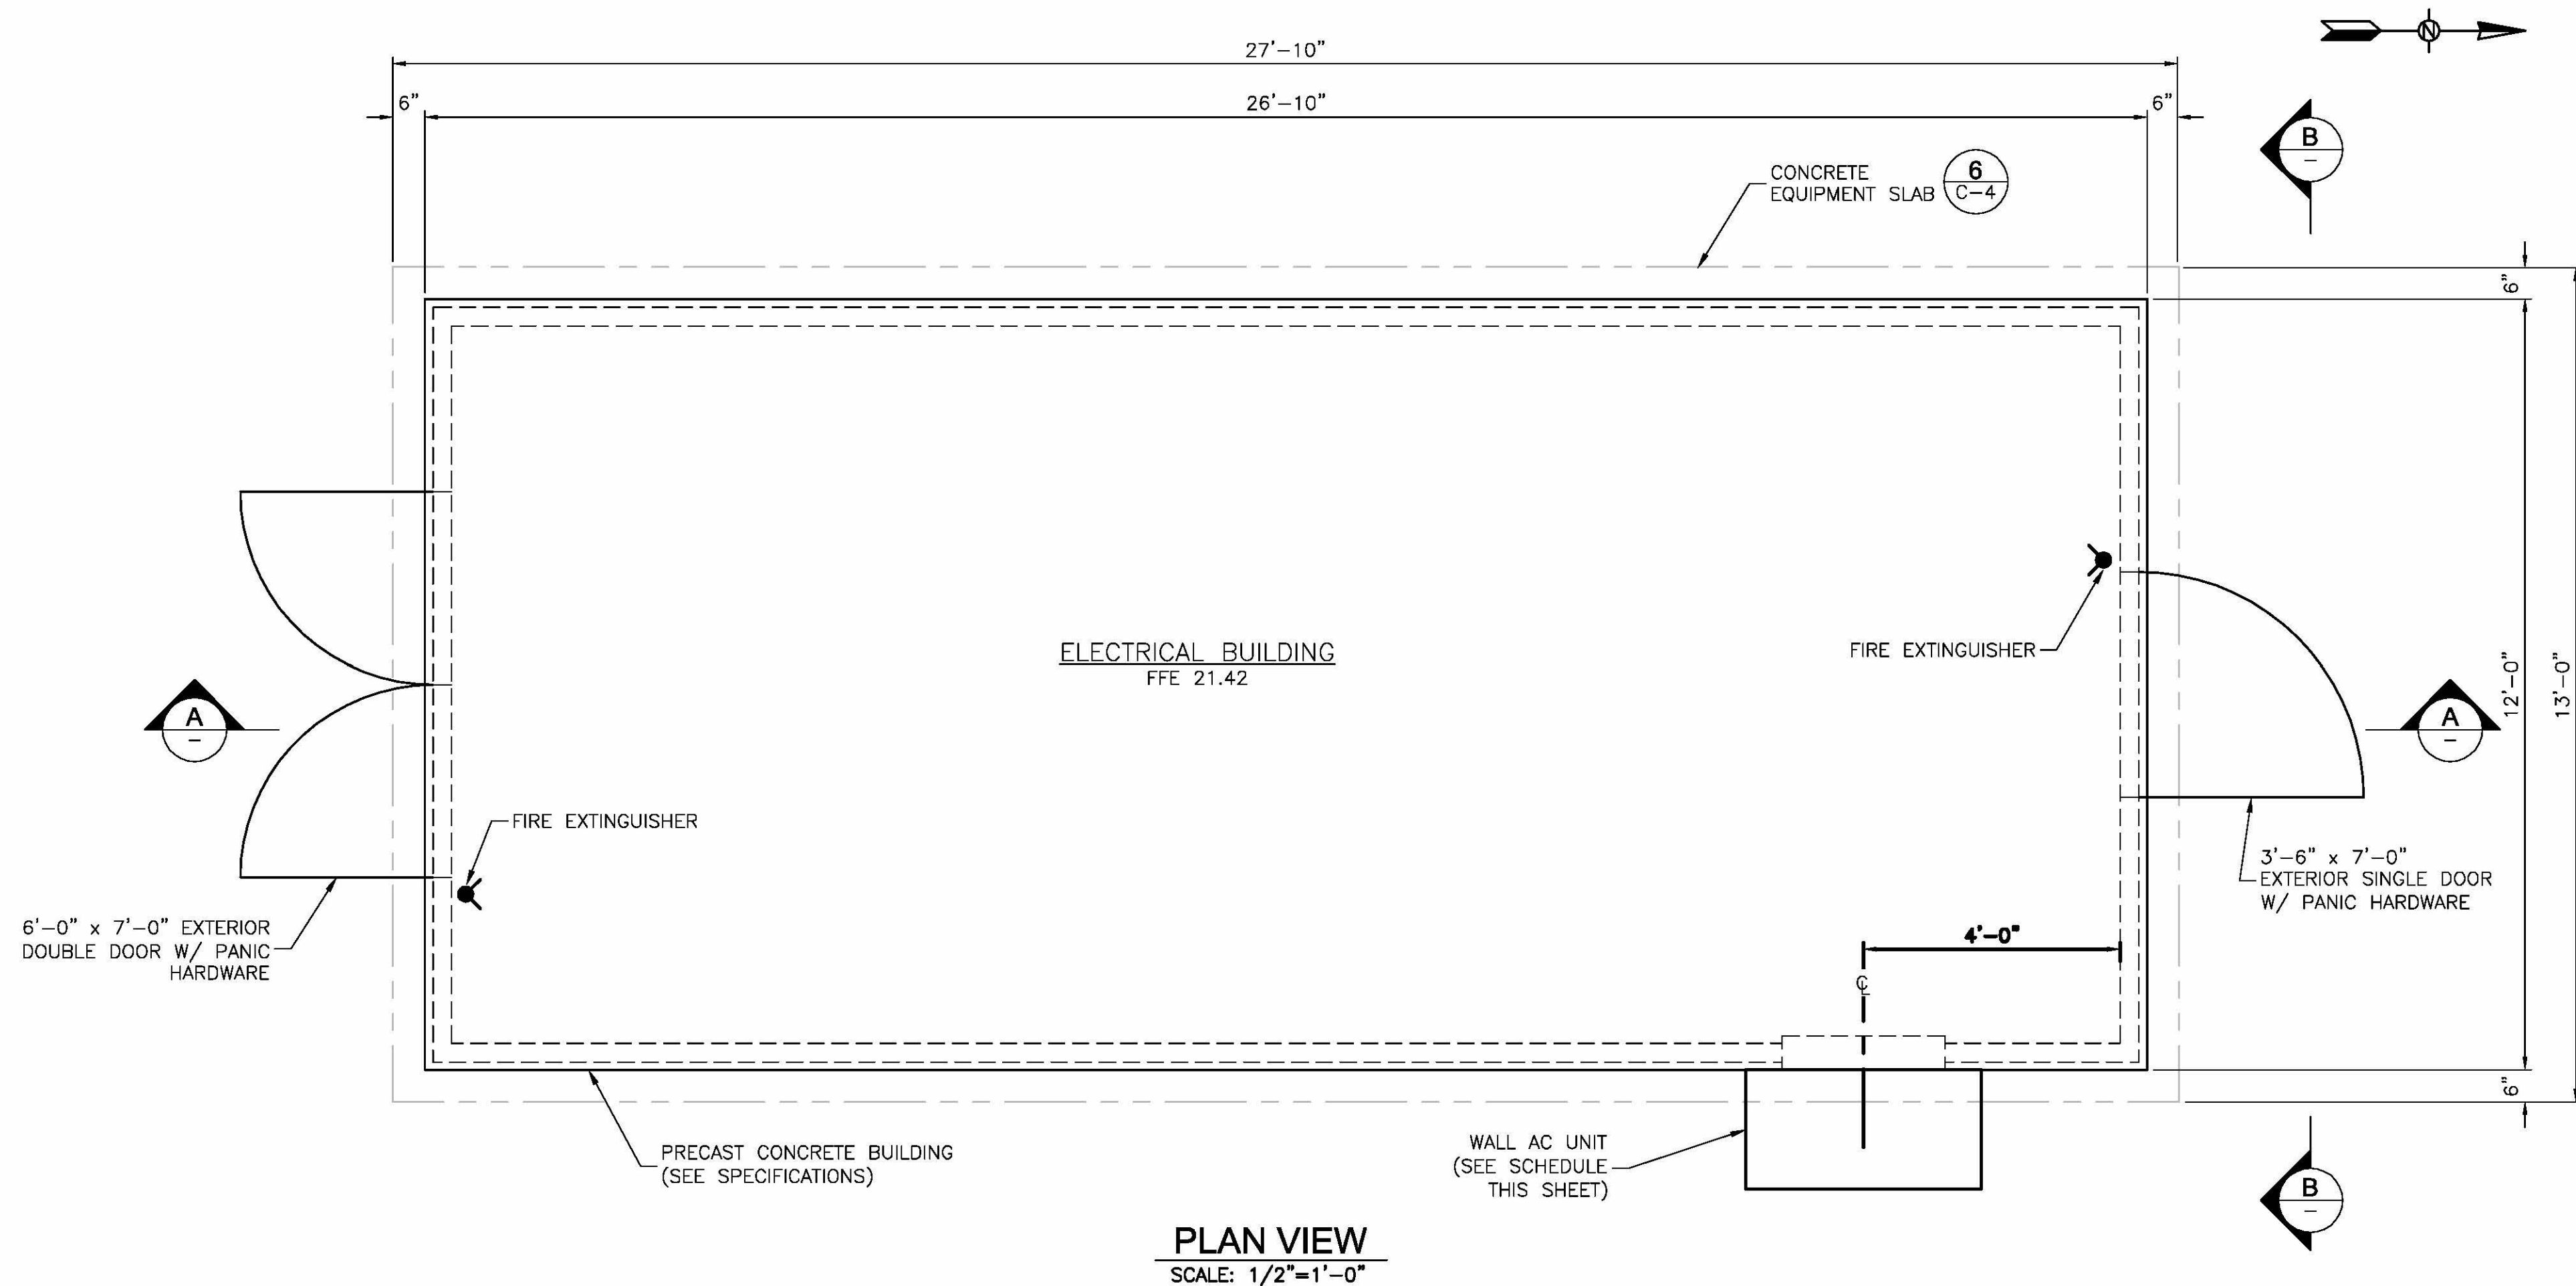



PACKAGED AIR CONDITIONING UNIT SCHEDULE		
EQUIPMENT TAG		PTAC-1
TOTAL CAPACITY (BTU/HR)		47,500
SENSIBLE CAPACITY (BTU/HR)		37,400
MINIMUM SYSTEM SEER		11.0
TOTAL SUPPLY AIR FLOW (CFM)		1,550
OUTSIDE AIR FLOW (CFM)		0
AIR TEMP. (F °) DB/WB	ENTERING	80/67
	LEAVING	55/54
FILTER TYPE		1" THROWAWAY
BLOWER HORSEPOWER		1/2
COMPRESSOR RATED LOAD AMPS		6.2
CONDENSER FAN MOTOR FLA		1.3
MINIMUM CIRCUIT AMPS/FUSE		13/15
RATED OUTDOOR TEMP. (F °)		95°
ELEC. SERVICE (VOLTS/PHASE/HERTZ)		460/3/60
WEIGHT (LBS)		500
REFERENCE MANUFACTURER		BARD
REFERENCE MODEL NO.		WA484-C
NOTES		1, 2, 3, 4, 5, 6

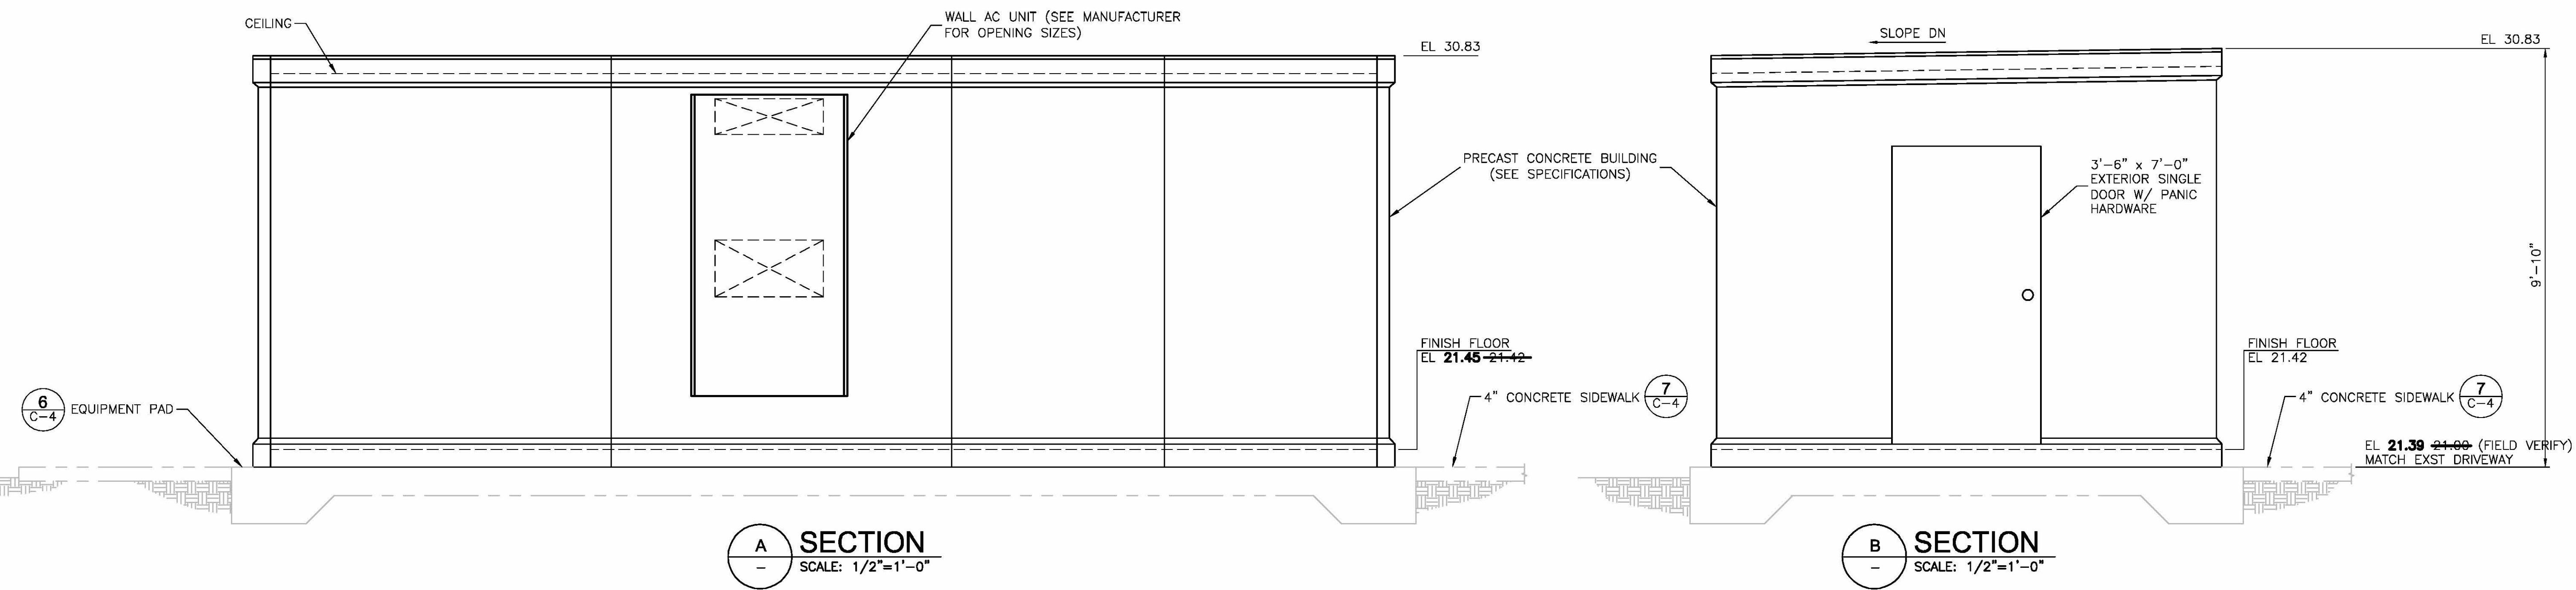- NOTES:**
1. CAPACITY RATINGS AS TESTED IN ACCORDANCE WITH ARI STANDARD 210/240.
 2. PROVIDE WITH FACTORY NON-PROGRAMMABLE SINGLE STAGE THERMOSTAT.
 3. PROVIDE WITH FACTORY COMPRESSOR CONTROL MODULE AND LOW AMBIENT CONTROL.
 4. PROVIDE WITH FACTORY SUPPLY AIR GRILLE AND RETURN AIR GRILLE WITH FILTER.
 5. PROVIDE WITH SINGLE POINT POWER CONNECTION.
 6. INSTALL PER MANUFACTURERS GUIDELINES AND RECOMMENDATIONS.



RECORD DRAWING

 <p>7650 West Courtney Campbell Causeway Suite 700 Tampa, Florida 33607 Ph: (813) 286-1711 Fax: (813) 286-6587 Florida Engineering Number: 000002</p>						URS JOB NUMBER 12007391		<p>IMPROVEMENTS AT TARA #20 MASTER LIFT STATION FOR MANATEE COUNTY GOVERNMENT MANATEE COUNTY, FLORIDA</p>	<p>ELECTRICAL BUILDING</p>	<p>CRAIG P. OSMANSKI FLORIDA P.E. NO. 48961</p>	PROJECT STATUS
						PM: C. OSMANSKI					RECORD DRAWINGS MAY 2010
						ENG: C. OSMANSKI					<p>M-7</p>
						DRW: J. SCHEUERMANN					
						FILE SAVE DATE: June 8, 2010					
	NO.	BY	DATE	DESCRIPTION	REVISIONS						

VERIFY SCALES: BAR IS ONE INCH ON ORIGINAL DRAWING 0 1 IF NOT ONE INCH ON THIS SHEET, ADJUST SCALE ACCORDINGLY
X:\MANATEE PROJECTS\12007391 TARA # 20 MASTER LIFT STATION - WMA4\CADD\E-1 ELECTRICAL ABBREVIATIONS SYMBOLS LEGEND & NOTES.DWG
PLOTTED: 8/26/2010 5:50:58 PM AUTOCAD: TTB: BSC-HOBAS\MANATEE\BES
X:\MANATEE PROJECTS\12007391 TARA # 20 MASTER LIFT STATION - WMA4\CADD\E-1 ELECTRICAL ABBREVIATIONS SYMBOLS LEGEND & NOTES.DWG

ABBREVIATIONS:

A	AMPS, AMPERE
AC	ALTERNATING CURRENT
AF	AMP FRAME, AMP FUSE
AFF	ABOVE FINISHED FLOOR
AL	ALUMINUM
ALT.	ALTERNATE
AM	AMMETER
AMPS	AMPERES
APPROX.	APPROXIMATE
ASPH.	ASPHALT
AST	ABOVEGROUND STORAGE TANK
ASTM	AMERICAN SOCIETY OF TESTING AND MATERIALS
AT	AMP TRIP
ATS	AUTOMATIC TRANSFER SWITCH
AUX.	AUXILIARY
AUTO.	AUTOMATIC
AVG.	AVERAGE
AWG	AMERICAN WIRE GAUGE
&	AND
⊗	AT
BATT.	BATTERY
BC	BARE COPPER, BOLT CIRCLE
BET.	BETWEEN
BIS	BITS PER SECOND
BIL	BASIC IMPULSE LEVEL
BLDG	BUILDING
BKR	BREAKER
BNC	BAYONET-NIELL-CONCELMAN
BOT.	BOTTOM
C	CONDUIT, CONDUCTOR
CAB.	CABINET
CAT.	CATALOG
CATV	CABLE TELEVISION
CB	CIRCUIT BREAKER, CATCH BASIN
CEM.	CEMENT
CF	CUBIC FOOT
CI	CAST-IN-PLACE
CKT	CIRCUIT
CLR	CLEAR
CL	CLASS, CENTERLINE, CURRENT LIMITING
CLG	CEILING
COL.	COLUMN
CMH	COMMUNICATIONS MANHOLE
COMM.	COMMUNICATION(S)
CONC.	CONCRETE
COND.	CONDUIT
CONN.	CONNECTION
CONST.	CONSTRUCTION
CONT.	CONTINUED
CONTR	CONTRACTOR
COORD.	COORDINATE
CPT	CONTROL POWER TRANSFORMER
CR	CONTROL RELAY
CRS	PVC COATED RIGID STEEL CONDUIT
CS	CONTROL STATION
CT	CURRENT TRANSFORMER
CTR	CENTER
CTRL	CONTROL
CU	COPPER
DB	DIRECT BURIED
dB	DECIBELS
DC	DIRECT CURRENT
DED.	DEDICATED
DEG.	DEGREES
DET.	DETAIL
DIA.	DIAMETER
DIV.	DIVISION
DIFF.	DIFFERENTIAL
DIM.	DIMENSIONS
DWG.	DRAWING
EA.	EACH
ELEC.	ELECTRIC, ELECTRICAL
EL.	ELEVATION
EMBT	EMBEDMENT
EMT	ELECTRICAL METALLIC TUBING
ENCL.	ENCLOSURE, ENCLOSED
ENGR	ENGINEER
EPO	EMERGENCY POWER OFF
EPR	ETHYLENE PROPYLENE RUBBER
EQ.	EQUAL
EQUIP.	EQUIPMENT
EQUIV.	EQUIVALENT
EXIST.	EXISTING
EXP.	EXPOSED

ABBREVIATIONS:

EXT.	EXTERIOR
F	FUSE
FA	FIRE ALARM
FAA	FUTURE FORCED AIR
FACP	FIRE ALARM CONTROL PANEL
FACS	FIRE ALARM CONTROL SYSTEM
FC	FOOT-CANDLE
FND	FOUNDATION
FDR	FEEDER
FHP	FRACTIONAL HORSEPOWER
FIN.	FINISHED
FIN. FL.	FINISHED FLOOR
FIXT.	FIXTURE
FLEX.	FLEXIBLE
FLR	FLOOR
FLUOR.	FLUORESCENT
FO	FIBER OPTIC
FT	FOOT, FEET
FTG	FOOTING
FU	FUSE
FUT.	FUTURE
FV	FULL VOLTAGE
FVR	FULL VOLTAGE REVERSING
FVNR	FULL VOLTAGE NON-REVERSING
GA	GAUGE
GALV.	GALVANIZED
GEN.	GENERATOR
GFI	GROUND FAULT INTERRUPTER
GFCI	GROUND FAULT CIRCUIT INTERRUPTER
GND	GROUND
GRS	GALVANIZED RIGID STEEL
H	HEIGHT
HD	HEAVY DUTY
HDPE	HIGH DENSITY POLYETHYLENE
HH	HANDHOLE
HID	HIGH INTENSITY DISCHARGE
HOA	HAND-OFF-AUTOMATIC
HORIZ.	HORIZONTAL
HP	HORSEPOWER
HPS	HIGH PRESSURE SODIUM
HR	HOOR
HZ	HERTZ
I.D.	INSIDE DIMENSION
IE	INVERT ELEVATION
IEEE	INSTITUTE OF ELECTRICAL & ELECTRONIC ENGINEERS
IES	ILLUMINATING ENGINEERING SOCIETY
IN.	INCH(ES)
INCL.	INCLUDING
INST.	INSTANTANEOUS
INSTR.	INSTRUMENT, INSTRUMENTATION
IMH	INSTRUMENTATION MANHOLE
INV.	INVERT
J, JB	JUNCTION BOX
JCT	JUNCTION
JT	JOINT
K	KIRK KEY INTERLOCK
KA	KILO AMPERES
KAIC	KILO AMPS INTERRUPTING CAPACITY
KCMIL	ONE THOUSAND CIRCULAR MILS
KV	KILOVOLTS
KVA	KILOVOLT AMPERES
KVAR	KILOVOLT AMPERES REACTIVE
KW	KILOWATTS
KWH	KILOWATT HOURS
KWHD	KILOWATT HOURS DEMAND
L	LENGTH
LB	POUND
LBS	POUNDS
LC	LOAD CENTER
LED	LIGHT EMITTING DIODE
LF	LINEAR FEET
LFMC	LIQUID-TIGHT FLEXIBLE METAL CONDUIT
LIN.	LINEAR
LOC	LOCATIONS
LPS	LIGHTNING PROTECTION SYSTEM
LS	LIMIT SWITCH
LT	LIGHT
LTG	LIGHTING
LTS	LIGHTS
LV	LOW VOLTAGE
LVMH	LOW VOLTAGE MANHOLE
L-G	LINE-TO-GROUND
L-L	LINE-TO-LINE

ABBREVIATIONS:

M	MOTOR
MAX.	MAXIMUM
MCM	ONE THOUSAND CIRCULAR MILS
MCOV	MAXIMUM CIRCUIT OPERATING VOLTAGE
MECH.	MECHANICAL
MEMB.	MEMBRANE
MFR	MANUFACTURER
MH	MANHOLE
MIN.	MINIMUM
MISC.	MISCELLANEOUS
MOV	METAL OXIDE VARISTOR
MLO	MAIN LUGS ONLY
MTD	MOUNTED
MTR	MOTOR
MV	MEDIUM VOLTAGE
MVA	MEGAVOLT AMPERES
N	NEUTRAL
NC	NORMALLY CLOSED
NE	NORTH EAST
NEC	NATIONAL ELECTRICAL CODE
NEMA	NATIONAL ELECTRICAL MANUFACTURES ASSOCIATION
NEUT.	NEUTRAL
NIC	NOT IN CONTRACT
NO	NORMALLY OPEN
NO.	NUMBER
NFPA	NATIONAL FIRE PROTECTION ASSOCIATION
NPT	NOMINAL PIPE THREAD
NTS	NOT TO SCALE
O.C.	ON CENTER(S)
O.D.	OUTSIDE DIAMETER
OH	OVERHEAD
OL	OVERLOADS
OPP.	OPPOSITE
OPER.	OPERATOR
OWS	OIL WATER SEPARATOR
P	POLE
PB	PULL BOX, PUSH BUTTON
PE	PHOTOELECTRIC DEVICE
PF	POWER FACTOR
PH OR ⌀	PHASE
PLC	PROGRAMMABLE LOGIC CONTROLLER
PLCS	PLACES
PM	POWER METER
PMH	PRIMARY MANHOLE
PNL	PANEL
PNLBD	PANEL BOARD
PAIR	PAIR
PRI.	PRIMARY
PROJ.	PROJECT
PS	PRESSURE SENSOR, POWER SUPPLY
PSI	POUNDS PER SQUARE INCH
PT	POTENTIAL TRANSFORMER, PRESSURE TRANSMITTER
PVC	POLYVINYL CHLORIDE
PWR	POWER
%	PERCENT
QTY	QUANTITY
RECP.	RECEPTACLE
REF.	REFERENCE
REINF.	REINFORCEMENT
REQD	REQUIRED
REV.	REVISION, REVISED
RF	RATING FACTOR
RGS	RIGID GALVANIZED STEEL
RMS	ROOT-MEAN-SQUARE
RVAT	REDUCED VOLTAGE AUTO TRANSFORMER
RVNR	REDUCED VOLTAGE NON-REVERSING
R/W	RIGHT-OF-WAY
SA	SURGE ARRESTER
SCH.	SCHEDULE
SEC.	SECONDARY, SECOND(S)
SECT.	SECTION
SF	SQUARE FOOT, SQUARE FEET
SHLD	SHIELDED
SHT	SHEET
SI	SQUARE INCH, SQUARE INCHES
SIM.	SIMILAR
SMH	SECONDARY MANHOLE
SPDT	SINGLE POLE DOUBLE THROW
SPEC	SPECIFICATION(S)
SQ.	SQUARE
SS	STAINLESS STEEL
ST.	STREET

ABBREVIATIONS:


STA.	STATION
STD	STANDARD
STL	STEEL
STR	STRANDED
SW.	SWITCH
SWBD	SWITCHBOARD
SYM.	SYMMETRICAL
SYNC.	SYNCHRONOUS
SY	SQUARE YARD, SQUARE YARDS
SYS.	SYSTEM
TB	TERMINAL BLOCK
TBD	TO BE DETERMINED
TD	TIME DELAY
TELE.	TELEPHONE
TEMP.	TEMPORARY, TEMPERATURE
TERM.	TERMINAL
THHN	HEAT RESISTANT THERMOPLASTIC INSULATION
THK	THICK
THWN	HEAT AND MOISTURE RESISTANT THERMOPLASTIC INSULATION
THRU	THROUGH
T.O.S.	TOP OF STEEL, TOP OF SLAB
TYP.	TYPICAL
TSP	TWISTED SHIELDED PAIR
UBC	UNIFORM BUILDING CODE
UG	UNDERGROUND
UL	UNDERWRITERS LABORATORY
UNO	UNLESS NOTED OTHERWISE
UPS	UNINTERRUPTABLE POWER SUPPLY
UTP	UNSHIELDED TWISTED PAIR
UVIR	ULTRAVIOLET INFRARED
V	VOLTS, VOLTAGE
VAR	VOLT AMPERES REACTIVE
VERT.	VERTICAL
VFD	VARIABLE FREQUENCY DRIVE
VM	VOLT METER
VOL.	VOLUME
VT	VOLTAGE TRANSFORMER
W	WATT, WIDE, WIDTH, WIRE
WF	WASTE FUEL
WH	WATT-HOUR
WM	WATT-HOUR METER
W/O	WITHOUT
WP	WEATHERPROOF
WT	WEIGHT
WWF	WELDED WIRE FABRIC
W/	WITH
X	REACTANCE
XFMR	TRANSFORMER
XHHW	HEAT AND MOISTURE RESISTANT CROSS LINKED SYNTHETIC POLYMER
XP	EXPLOSION PROOF
Z	IMPEDANCE

GENERAL NOTES:

1. REFER TO MECHANICAL DRAWINGS FOR PROJECT LOCATION, TANK LOCATIONS AND LOCATIONS OF BUILDINGS ON SITE PLAN.

LEGEND:

	REFERENCE NOTE TAG
	DEMOLITION NOTE TAG
	FEEDER NOTE TAG
	DRIVEN GROUNDING ROD ELECTRODE
	CONNECTION POINT
	CONDUIT.
	CONDUIT UNDERGROUND.
	2 X 32W FLUORESCENT LAMP PENDANT MOUNTED LIGHT FIXTURE, REFER TO LIGHTING FIXTURE SCHEDULE ON E-6.
	HPS WALL MOUNT LIGHT FIXTURE, REFER TO LIGHTING FIXTURE SCHEDULE ON E-6.
	LIGHT SWITCH, "H" INDICATES NUMBER OF WAYS FOR SWITCH, "T" INDICATES SWITCH INCLUDES TIME DELAYED AUTOMATIC SHUTOFF.
	DUPLEX RECEPTACLE, NEMA 5-20R, INDUSTRIAL SPECIFICATION GRADE. "GFCI" INDICATES THAT RECEPTACLE INCLUDES GROUND FAULT CIRCUIT INTERRUPTER. "WP" INDICATES RECEPTACLE IS WEATHERPROOF RATED.
	HPS POLE MOUNT LIGHT FIXTURE, REFER TO LIGHTING FIXTURE SCHEDULE ON E-6 AND DETAIL ON E-2.
	CIRCUITING SYMBOLLOGY FEEDER. REFER TO SINGLE-LINE DIAGRAM FOR CONDUIT AND WIRE SPECIFICATION.
	HOMERUNS TO PANEL. PANEL & CIRCUIT DESIGNATIONS AS INDICATED. NO TICK MARKS INDICATE THREE (3) CONDUCTORS, TICK MARKS INDICATE NUMBER OF CONDUCTORS IF THERE IS MORE THAN THREE (3) CONDUCTORS; (1) INDICATES PHASE CONDUCTOR, (N) INDICATES NEUTRAL CONDUCTOR, (G) INDICATES GROUND CONDUCTOR
	PHOTO CELL
	JUNCTION BOX

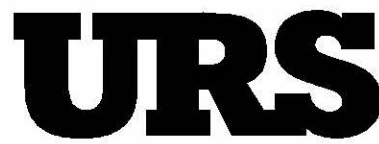

7650 West Courtney Campbell Causeway
Suite 700
Tampa, Florida 33607
Ph: (813) 286-1711 Fax: (813) 286-6587
Florida Engineering Number: 000002

NO.	BY	DATE	DESCRIPTION
REVISIONS			

URS JOB NUMBER
12007391
PM: C. OSMANSKI
ENG: G. DAVIS
DRW: G. DAVIS
FILE SAVE DATE:
November 20, 2008



IMPROVEMENTS AT
TARA #20 MASTER LIFT STATION
FOR
MANATEE COUNTY GOVERNMENT
MANATEE COUNTY, FLORIDA

ELECTRICAL ABBREVIATIONS,
SYMBOLS, LEGEND & NOTES

GLENN H. DAVIS
FLORIDA P.E. NO. 66443

PROJECT STATUS
RECORD DRAWINGS
MAY 2010

E-1

RECORD DRAWING

VERIFY SCALES: BAR IS ONE INCH ON ORIGINAL DRAWING 1 IF NOT ONE INCH ON THIS SHEET, ADJUST SCALE ACCORDINGLY

PLOTTED June 15, 2006 3:51 PM PLOTTED BY: SCHEJERMAN, JAMES
X:\MANATEE PROJECTS\12007391 TARA # 20 MASTER LIFT STATION - WMA CAD\E-2 ELECTRICAL SITE PLANDWG

GENERAL NOTES:

- 1. REFER TO SINGLE LINE DIAGRAM FOR CONDUCTOR SIZES AND ADDITIONAL REQUIREMENTS.
- 2. ALL PVC UNDERGROUND CONDUITS SHALL TRANSITION TO RGS CONDUIT PRIOR TO CONDUIT TRANSITION FROM HORIZONTAL TO VERTICAL. ALL EXTERIOR VERTICAL CONDUITS ARE RGS.

REFERENCE NOTES:


- 1. COORDINATE WITH UTILITY FOR TERMINATION IN UTILITY HANDHOLE.
- 2. PROVIDE THREE (3) 4 IN. SCHEDULE 80 PVC CONDUITS BETWEEN UTILITY HANDHOLE AND 'MCB' IN ELECTRICAL BUILDING.
- 3. PROVIDE THE FOLLOWING IN SCHEDULE 80 PVC CONDUIT UG BETWEEN WETWELL TERMINATION CABINETS AND ELECTRICAL BUILDING:
 - TWO (2) 3 IN. FOR PUMP MOTOR POWER CONDUCTORS.
 - ONE (1) 2 IN. FOR FLOAT CONTROL CABLES.
 - ONE (1) 2 IN. FOR LEVEL TRANSMITTER CONTROL CABLE.
 - TWO (2) 2 IN. FOR PUMP MANUFACTURER'S MONITORING AND STATUS (MAS) CONTROL WIRING.

REFERENCE NOTES CONTINUED:


- 4. PROVIDE TWO (2) 1 IN. ~~CONCRETE ENCASED~~ PVC CONDUIT UG BETWEEN GENERATOR FUEL TANK AND ELECTRICAL BUILDING.
- 5. PROVIDE ONE (1) 2 IN. ~~CONCRETE ENCASED~~ PVC CONDUIT UG BETWEEN GENERATOR CONTROL PANEL IN GENERATOR ENCLOSURE AND CONTROL CABINET IN ELECTRICAL BUILDING. **ADD ONE (1) 1-INCH SPARE TO ATS IN BUILDING**
- 6. PROVIDE THE FOLLOWING ~~CONCRETE ENCASED~~ PVC CONDUIT UG BETWEEN GENERATOR ENCLOSURE AND ELECTRICAL BUILDING:
 - TWO (2) 3 IN. FOR GENERATOR POWER CONDUCTORS.
 - ONE (1) 1-INCH FROM GENERATOR TO ATS (REMOVE START CONTROL WIRING)**
 - ONE (1) 1-1/4 IN. FOR PANEL 'FPG' IN GENERATOR ENCLOSURE POWER CONDUCTORS.
- 7. PROVIDE ONE 1 IN. ~~CONCRETE ENCASED~~ SCHEDULE ~~80~~ **40** PVC CONDUIT UG BETWEEN PUMP CONTROL CABINET AND JUNCTION BOX IN DOGHOUSE MANHOLE FOR FLOW METER AND PRESSURE TRANSDUCER/TRANSMITTER CONTROL WIRING.
- 8. PROVIDE GROUND RODS ON MAXIMUM 100 FT. CENTERS BETWEEN DUCTBACK TERMINATIONS AT MANHOLES/HANDHOLES AND BUILDINGS. BOND COUNTERPOISE GROUNDING CONDUCTOR TO GROUND ROD VIA EXOTHERMIC WELDING PROCESS.

REFERENCE NOTES CONTINUED:


- 9. "FINAL GRADE" SHALL BE UNDERSTOOD TO REFER TO THE "FINAL EARTHEN GRADE" OR "TOP OF PAVEMENT SURFACE", WHICHEVER ORIGINAL CONDITION IN ACCORDANCE WITH THE REQUIREMENTS OF THE CONTRACT GOVERNING SURFACE RESTORATION.
- 10. PROVIDE ONE (1) 2 IN. CONCRETE ENCASED PVC CONDUIT UG BETWEEN GENERATOR CONTROL PANEL IN GENERATOR ENCLOSURE AND CONTROL CABINET REINFORCING STEEL SHALL BE DEFORMED BARS OF NEW BILLET STEEL MEETING THE REQUIREMENTS OF ASTM A 615, GRADE 60, UNCOATED.
- 11. CONCRETE SHALL DEVELOP A MINIMUM COMPRESSIVE STRENGTH OF 3000 PSI IN 28 DAYS AS DETERMINED BY TEST CYLINDERS MADE IN ACCORDANCE WITH ASTM C 31 AND TESTED IN ACCORDANCE WITH ASTM C 39. CONCRETE SHALL CONTAIN NOT LESS THAN 470 LBS OF CEMENT PER CUBIC YARD. CONCRETE SHALL CONTAIN 5 PERCENT OF ENTRAINED AIR, PLUS OR MINUS 1 PERCENT, AS DETERMINED BY ASTM C 231 AND SHALL HAVE A SLUMP OF NOT MORE THAN 4" AS DETERMINED BY ASTM C 143.
- 12. PROVIDE ONE 3/4 IN. DIRECT BURIED SCHEDULE 80 PVC CONDUIT UG BETWEEN 'MDP' AND LOCAL DISCONNECT FOR HOIST/TROLLEY POWER CONDUCTORS.
- 13. PROVIDE HEAVY DUTY 30A NONFUSED DISCONNECT SWITCH MOUNTED TO HOIST/TROLLEY COLUMN IN A NEMA TYPE 4X SS ENCLOSURE.
- 14. PROVIDE ONE 3/4 IN. RIGID ALUMINUM CONDUIT ROUTED EXPOSED ON HOIST/TROLLEY BEAM BETWEEN LOCAL DISCONNECT AND JUNCTION BOX.
- 15. PROVIDE MINIMUM 12" SQ. BY 6" DEEP JUNCTION BOX FOR TERMINATION OF HOIST/TROLLEY FESTOON CABLING.

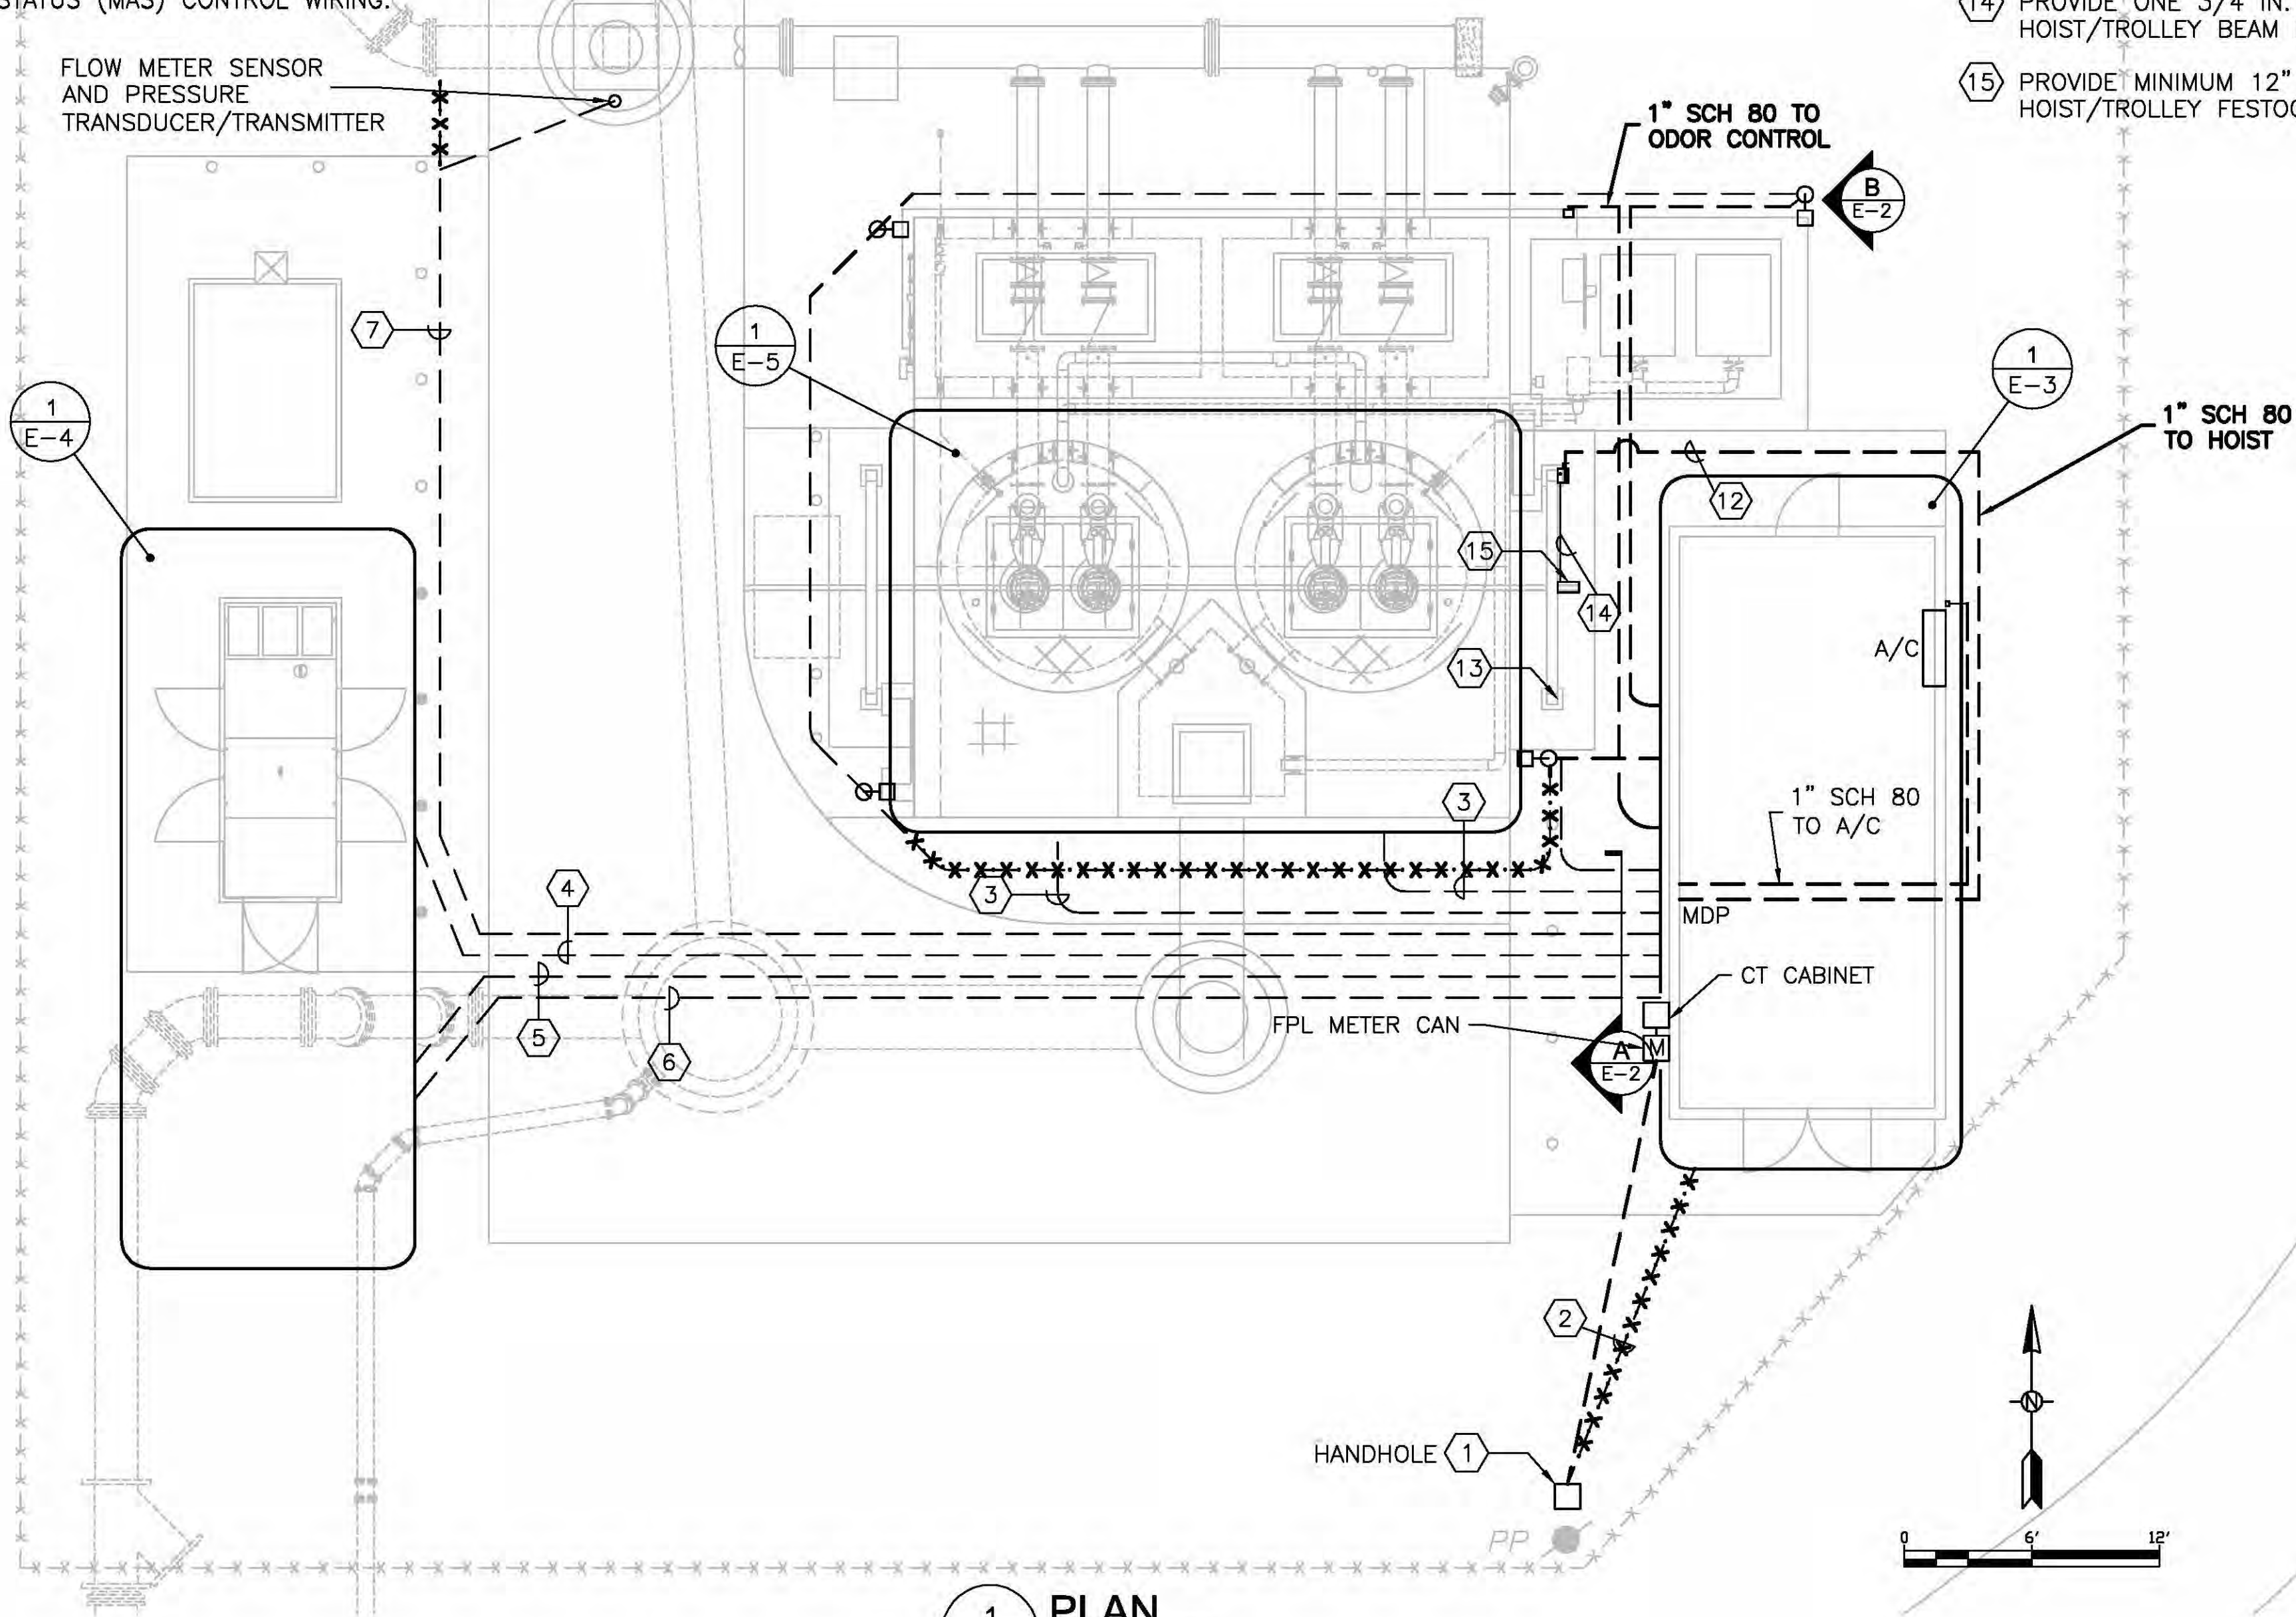

1 PLAN
E-3 ELECTRICAL SITE
SCALE: 1"=6'

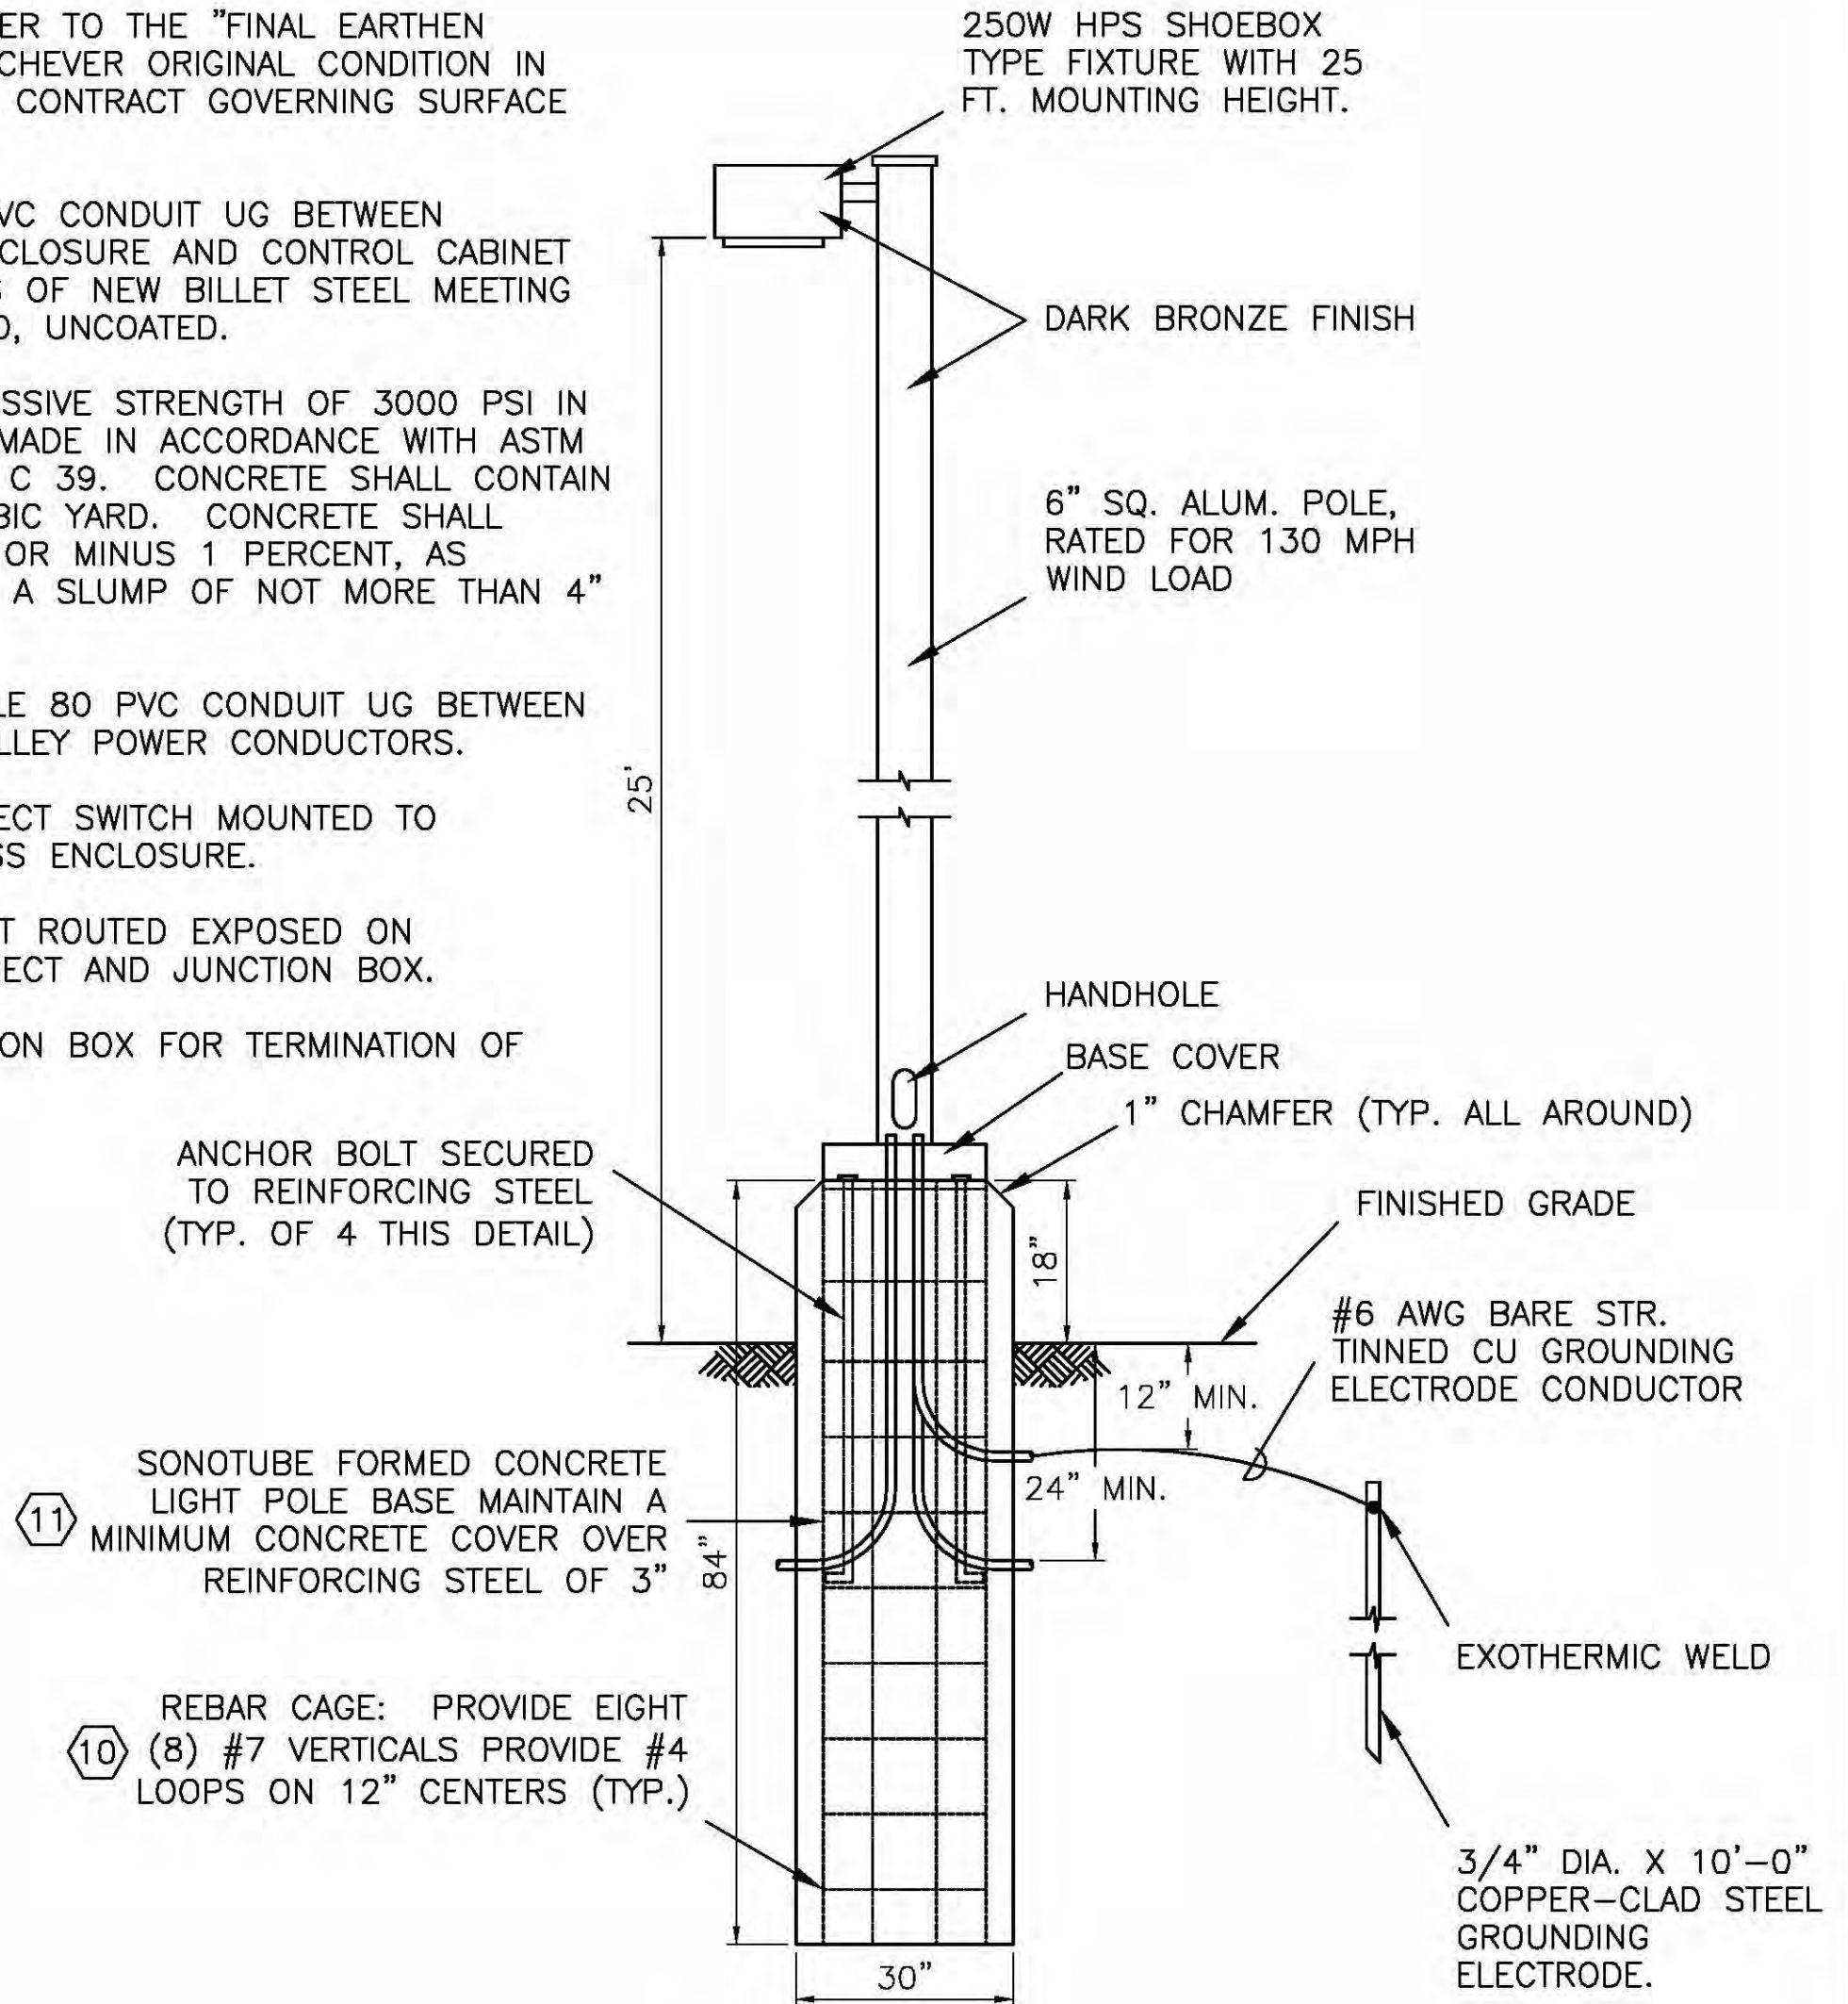

B DETAIL
E-2 POLE MOUNTED AREA LUMINAIRE
SCALE: NTS

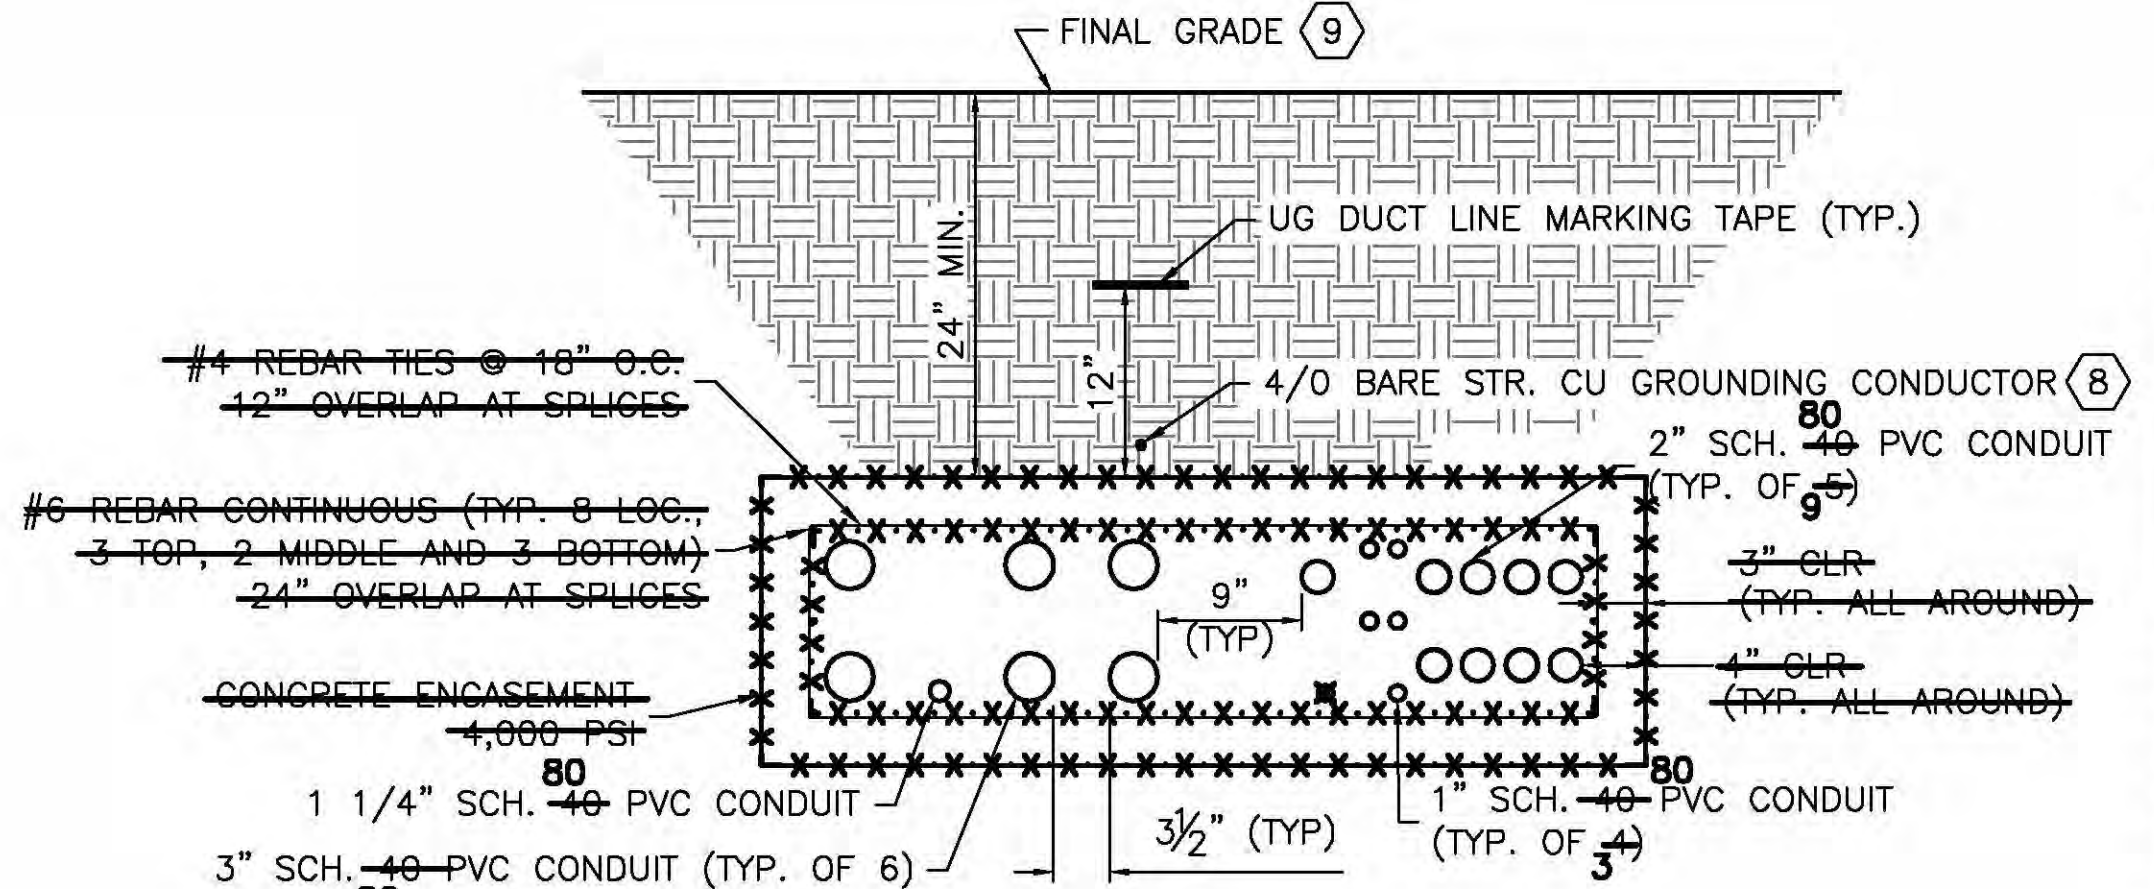

A SECTION
E-3 DUCT BANK
SCALE: NTS

7650 West Courtney Campbell Causeway
Suite 700
Tampa, Florida 33607
Ph: (813) 286-1711 Fax: (813) 286-6587
Florida Engineering Number: 000002

NO.	BY	DATE	DESCRIPTION
1	GHD	9/26/09	HOIST/TROLLEY, ELECTRICAL

REVISIONS

URS JOB NUMBER	12007391
PM:	C. OSMANSKI
ENG:	G. DAVIS
DRW:	G. DAVIS
FILE SAVE DATE:	June 8, 2010


IMPROVEMENTS AT
TARA #20 MASTER LIFT STATION
FOR
MANATEE COUNTY GOVERNMENT
MANATEE COUNTY, FLORIDA

ELECTRICAL SITE PLAN


PROJECT STATUS	RECORD DRAWINGS MAY 2010
GLENN H. DAVIS FLORIDA P.E. NO. 66443	

E-2

RECORD DRAWING

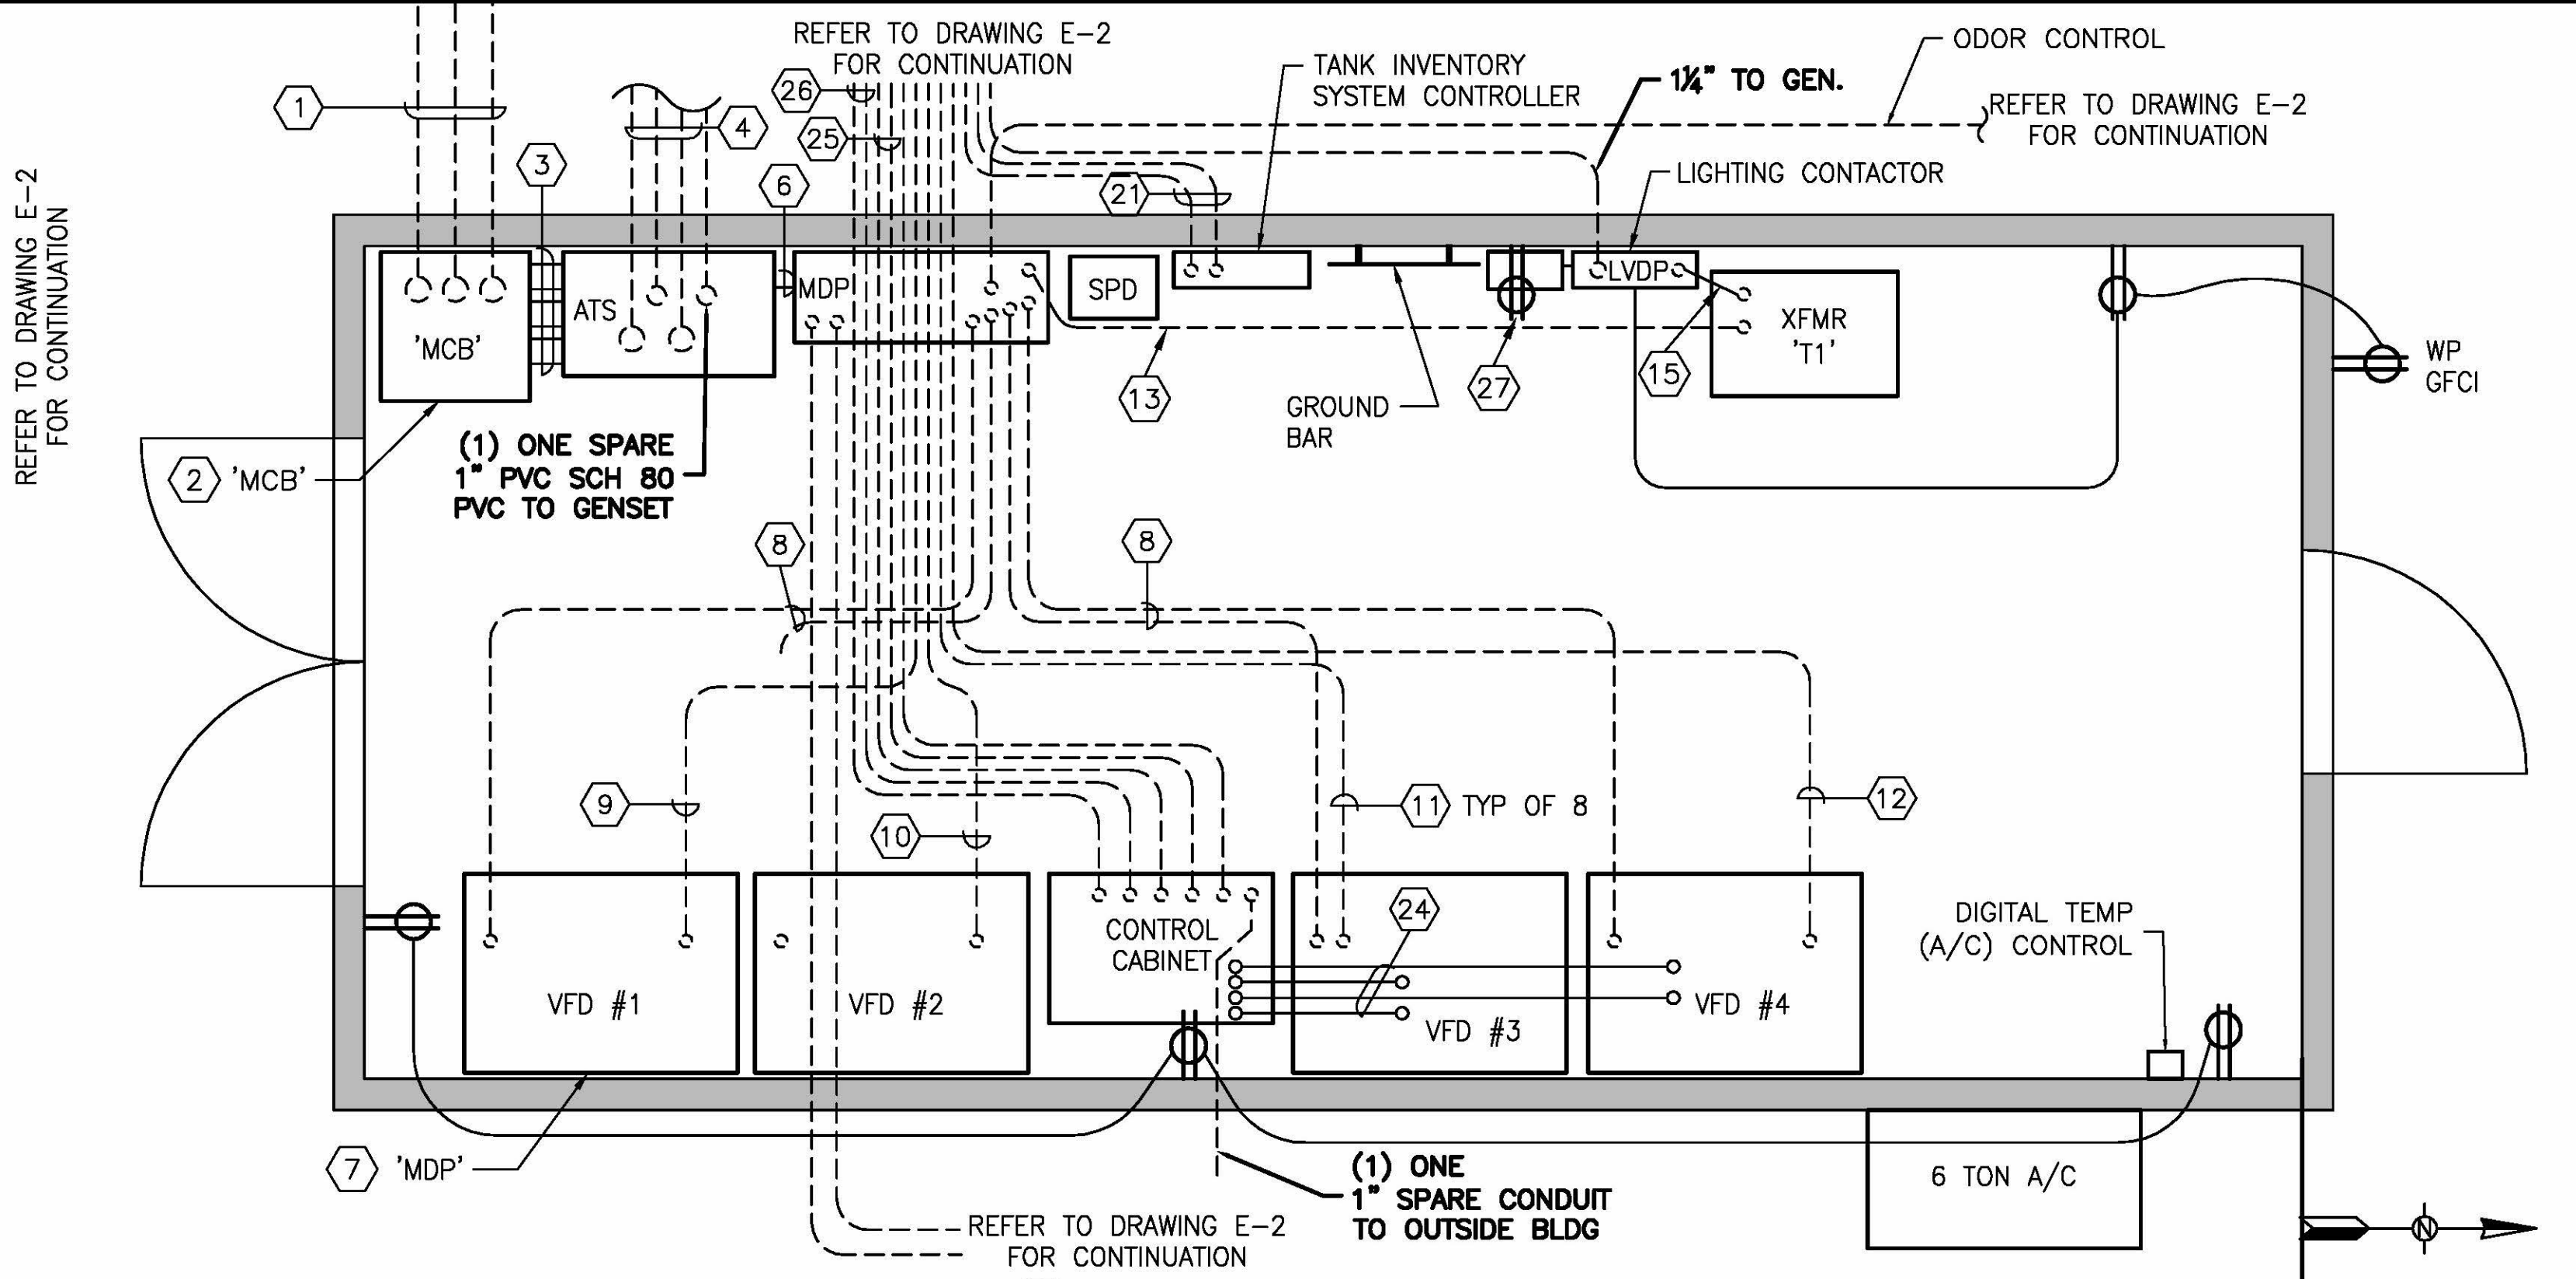

1 PLAN
E-3 ELECTRICAL BLDG. - POWER DISTRIBUTION, UG CONDUIT
SCALE: 1/2"=1'-0"

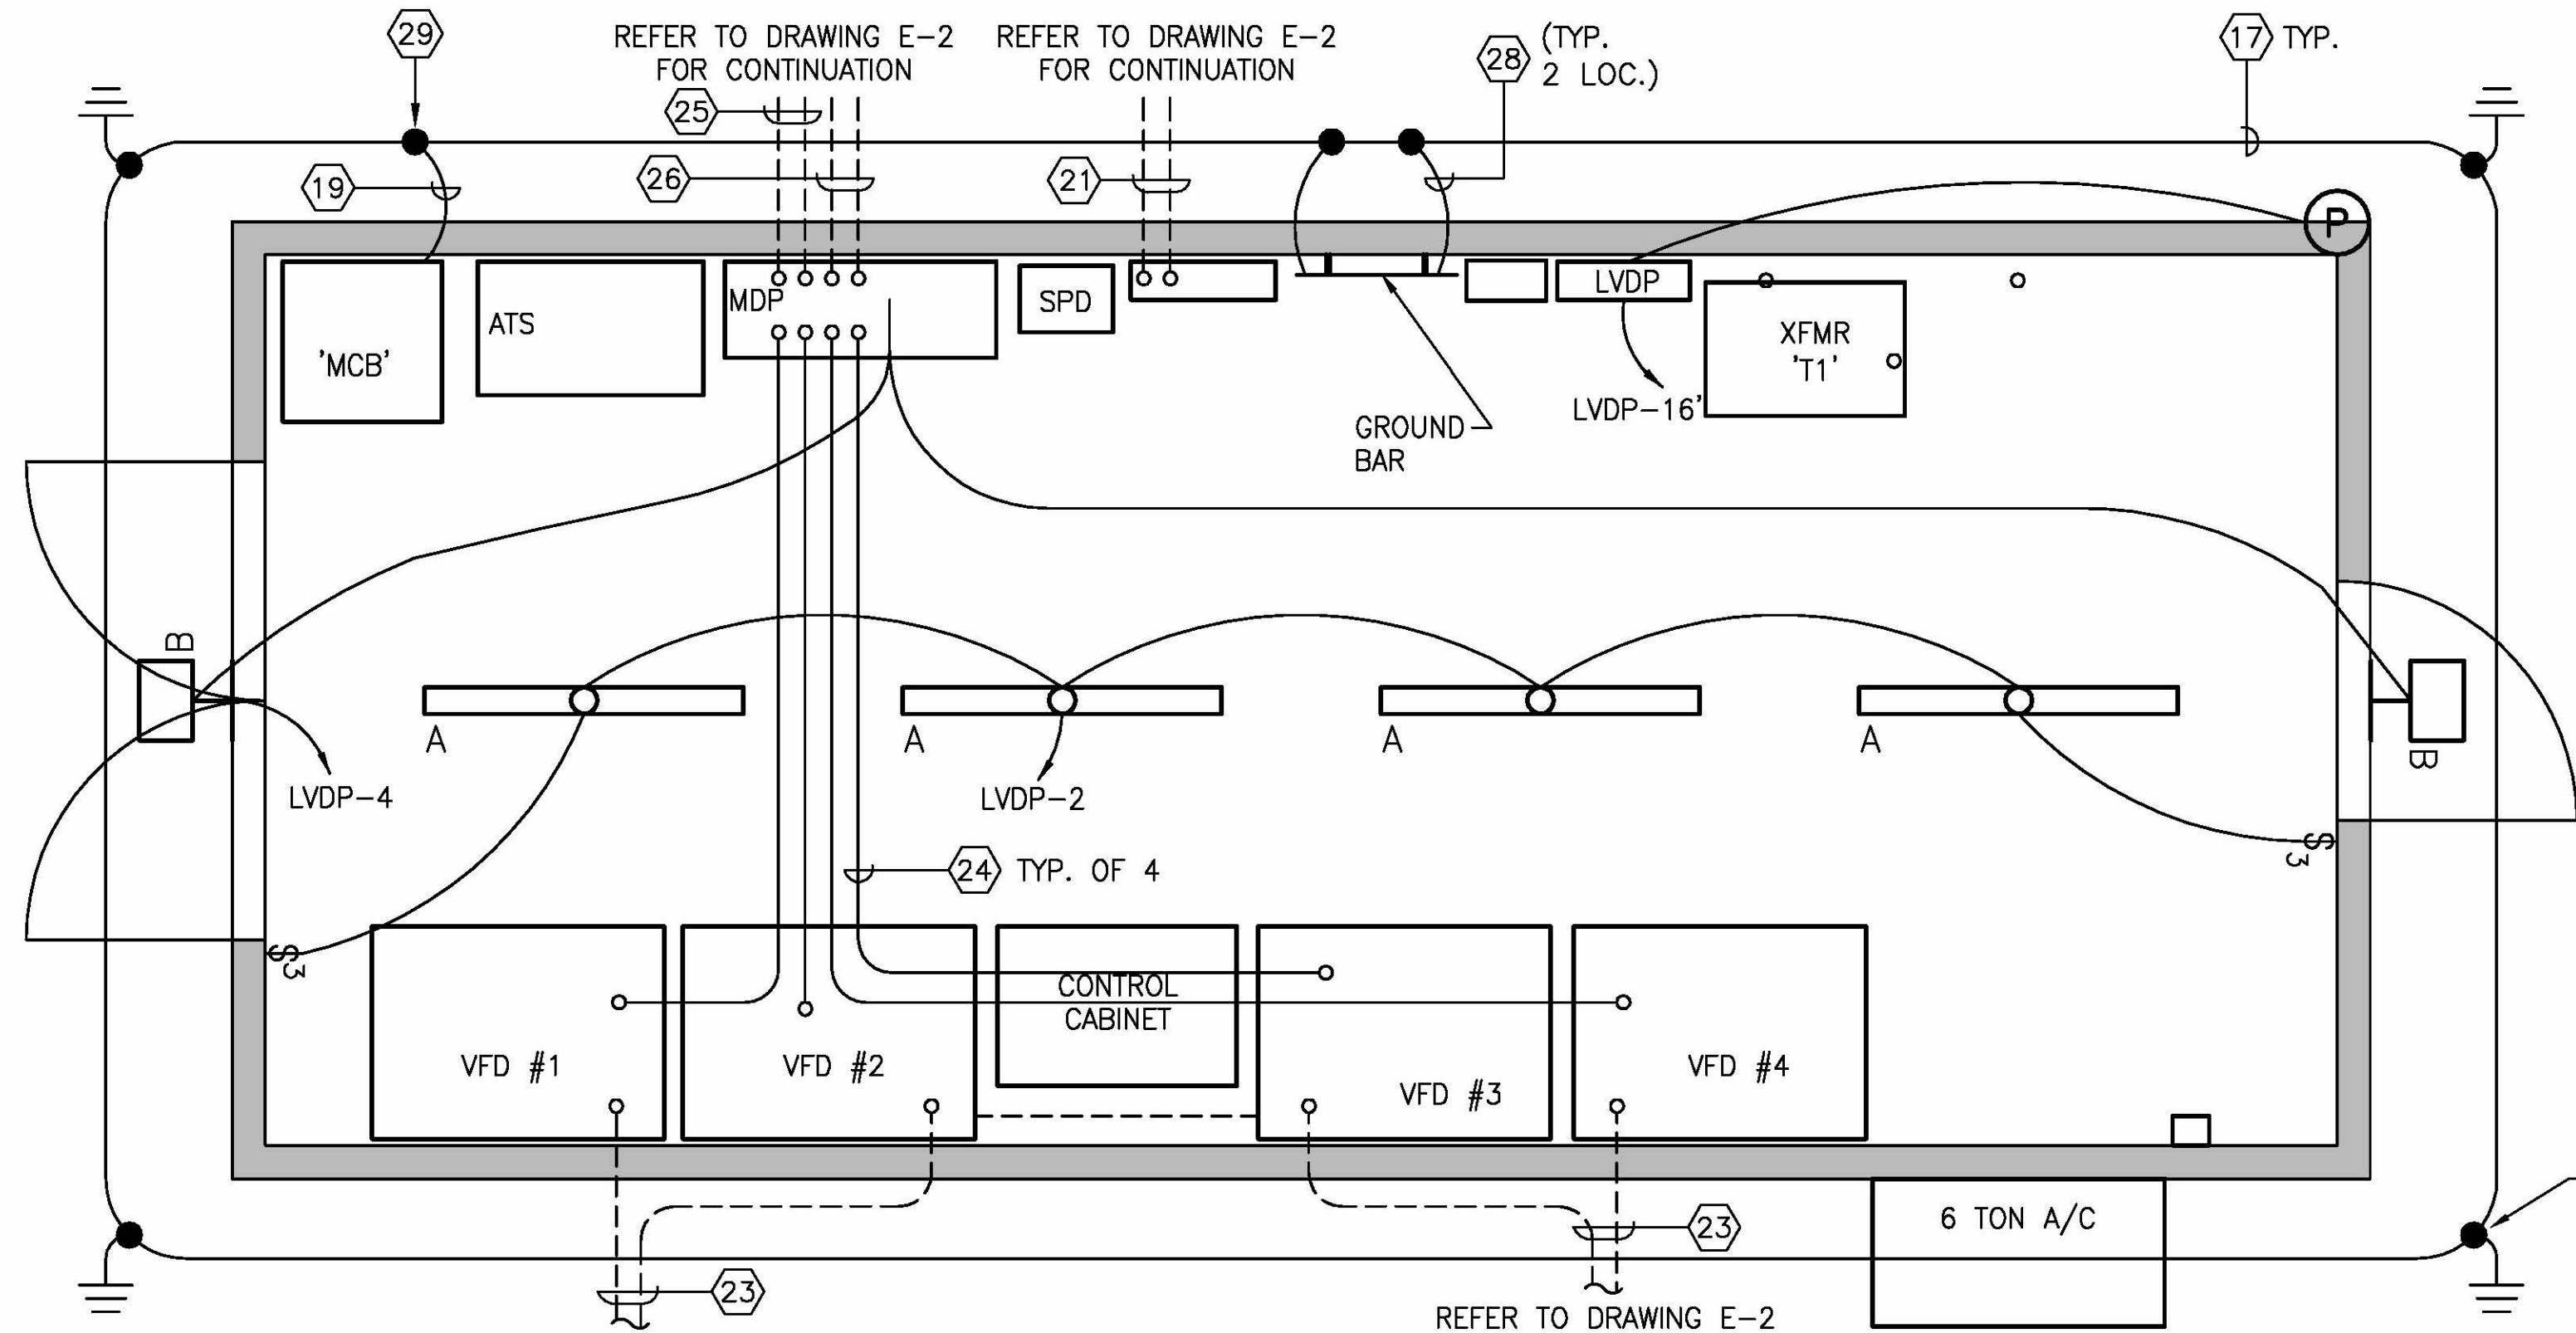

2 PLAN
E-3 ELECTRICAL BLDG. - GROUNDING, LIGHTING & CONTROLS CONDUITS
SCALE: 1/2"=1'-0"

GENERAL NOTES:

1. REFER TO SINGLE LINE DIAGRAM FOR CONDUCTOR SIZES AND ADDITIONAL REQUIREMENTS.
2. ALL PVC UNDERGROUND CONDUITS SHALL TRANSITION TO RGS CONDUIT PRIOR TO CONDUIT TRANSITION FROM HORIZONTAL TO VERTICAL. ALL EXTERIOR VERTICAL CONDUITS ARE RGS.

REFERENCE NOTES:

- 1 PROVIDE THREE (3) 4IN. SCHEDULE 80 PVC CONDUITS UG, 2 ACTIVE, 1 SPARE BETWEEN THE UTILITY HANDHOLE AND 'MCB'.
- 2 PROVIDE 1200A 'MCB' IN A FLOOR MOUNT NEMA TYPE 12 ENCLOSURE. PROVIDE PERMANENT PLAQUE MOUNTED TO ENCLOSURE WITH CONTRASTING COLORS AND MINIMUM OF 2IN. HIGH LETTERING THAT STATES "SERVICE 1 OF 2: SERVICE NO. 2 'GCB' IS LOCATED IN GENERATOR ENCLOSURE".
- 3 PROVIDE THREE (3) 4IN. RGS CONDUIT EXPOSED BETWEEN 'MCB' AND THE ATS.
- 4 PROVIDE TWO (2) 3IN. ~~CONCRETE ENCASED~~ SCHEDULE 80 ~~40~~ PVC CONDUITS UG BETWEEN 'GCB' IN GENERATOR ENCLOSURE AND ATS IN ELECTRICAL BUILDING. **PROVIDE (2) 1-INCH (ONE FOR REMOVE START CONTROL WIRING FROM GENERATOR TO ATS & ONE SPARE FROM GENERATOR TO ATS IN BUILDING.**
- 5 PROVIDE 1000A ATS ON 4IN. HOUSEKEEPING PAD IN A NEMA TYPE 12 ENCLOSURE.
- 6 PROVIDE THREE (3) 4IN. ~~CONCRETE ENCASED~~ SCHEDULE 80 ~~40~~ PVC CONDUITS UG, 2 ACTIVE, 1 SPARE BETWEEN THE ATS AND 'MDP'.
- 7 PROVIDE 1200A SURFACE MOUNTED PANELBOARD IN A NEMA TYPE 12 ENCLOSURE.
- 8 PROVIDE ONE 2IN. SCHEDULE 80 PVC CONDUIT UG BETWEEN PANEL 'MDP' AND VFD.
- 9 PROVIDE ONE 2IN. SCHEDULE 80 PVC CONDUIT UG BETWEEN 'VFD-1' AND TERMINATION CABINET 'TC-1' ADJACENT TO WET WELL #1.
- 10 PROVIDE ONE 2IN. SCHEDULE 80 PVC CONDUIT UG BETWEEN 'VFD-2' AND TERMINATION CABINET 'TC-1' ADJACENT TO WET WELL #1.
- 11 PROVIDE ONE 2IN. SCHEDULE 80 PVC CONDUIT UG BETWEEN 'VFD-3' AND TERMINATION CABINET 'TC-2' ADJACENT TO WET WELL #2.
- 12 PROVIDE ONE 2IN. SCHEDULE 80 PVC CONDUIT UG BETWEEN 'VFD-4' AND TERMINATION CABINET 'TC-2' ADJACENT TO WET WELL #2.
- 13 PROVIDE ONE 1-1/2IN. LPMC BETWEEN PANEL 'MDP' AND TRANSFORMER 'T1'.
- 14 PROVIDE 45KVA GENERAL PURPOSE FLOOR MOUNTED TRANSFORMER ON A 4IN. HOUSEKEEPING PAD.
- 15 PROVIDE ONE 2IN. LPMC BETWEEN TRANSFORMER 'T1' AND PANEL 'LVDP'.
- 16 PROVIDE 225A SURFACE MOUNTED PANELBOARD IN A NEMA TYPE 12 ENCLOSURE.
- 17 PROVIDE #4/0 AWG BARE STRANDED TINNED COPPER COUNTERPOISE GROUNDING ELECTRODE CONDUCTOR DIRECT BURIED A MINIMUM OF 30IN. BELOW FINISHED GRADE.
- 18 PROVIDE GROUND ROD. INSTALL GROUND ROD SO THAT TOP IS A MINIMUM OF 30IN. BELOW FINISHED GRADE. BOND GROUND ROD TO GROUNDING ELECTRODE CONDUCTOR VIA THE EXOTHERMIC WELDING PROCESS.
- 19 PROVIDE #4/0 AWG BARE STRANDED TINNED COPPER GROUNDING CONDUCTOR IN PVC CONDUIT BETWEEN 'MCB' AND COUNTERPOISE GROUNDING ELECTRODE CONDUCTOR. BOND GROUNDING CONDUCTOR TO 'MCB' GROUND BUS.
- 20 PROVIDE TANK INVENTORY SYSTEM CONTROLLER.
- 21 PROVIDE TWO (2) 1IN. ~~CONCRETE ENCASED~~ PVC CONDUIT, ONE BETWEEN TANK INVENTORY SYSTEM CONTROLLER AND INTERSTITIAL MONITOR, ONE BETWEEN TANK INVENTORY SYSTEM CONTROLLER AND TANK INVENTORY PROBE.
- 22 OWNER FURNISHED CONTROL CABINET.
- 23 PROVIDE FOUR (4) 2 IN. SCHEDULE 80 PVC CONDUIT UG BETWEEN CONTROL CABINET AND TERMINATION CABINETS (TC-1 & TC-2). PROVIDE 12 #4 AWG CONTROL WIRING AND 1 #12 GND IN EACH CONDUIT FOR PUMP MANUFACTURER'S MONITORING AND STATUS (MAS).
- 24 PROVIDE ONE 2IN. EMT ROUTED EXPOSED BETWEEN CONTROL CABINET AND VFD ENCLOSURE FOR CONTROL WIRING. **IN ADDITION, PROVIDE ONE 1 1/4" EMT FOR PUMP MAS CONTROL WIRING.**
- 25 PROVIDE TWO (2) 2IN. SCHEDULE 80 PVC CONDUIT BETWEEN CONTROL CABINET AND TERMINATION CABINETS (TC-1 & TC-2) FOR FLOAT CONTROL CABLES.
- 26 PROVIDE TWO (2) 2IN. SCHEDULE 80 PVC CONDUIT BETWEEN CONTROL CABINET AND TERMINATION CABINETS (TC-1 & TC-2) FOR LEVEL TRANSMITTER CONTROL CABLES.
- 27 PROVIDE UPS WITH RATED TO PROVIDE 20A AT 120V FOR A MINIMUM OF 20 MINUTES. INSTALL UPS BETWEEN DEDICATED RECEPTACLE AND CONTROL CABINET.
- 28 PROVIDE #4/0 AWG. BARE STRANDED TINNED COPPER GROUNDING CONDUCTOR IN PVC CONDUIT BETWEEN GROUND BAR AND COUNTERPOISE LOOP.
- 29 EXOTHERMICALLY WELD GROUND CONNECTIONS TO COUNTERPOISE LOOP.

RECORD DRAWING

URS
7650 West Courtney Campbell Causeway
Suite 700
Tampa, Florida 33607
Ph: (813) 286-1711 Fax: (813) 286-6587
Florida Engineering Number: 000002

NO.	BY	DATE	DESCRIPTION

URS JOB NUMBER 12007391
PM: C. OSMANSKI
ENG: G. DAVIS
DRW: G. DAVIS
FILE SAVE DATE: June 8, 2010



IMPROVEMENTS AT
TARA #20 MASTER LIFT STATION
FOR
MANATEE COUNTY GOVERNMENT
MANATEE COUNTY, FLORIDA


ELECTRICAL BUILDING PLAN

GLENN H. DAVIS
FLORIDA P.E. NO. 66443

PROJECT STATUS
RECORD DRAWINGS
MAY 2010
E-3



- # RECORD DRAWING

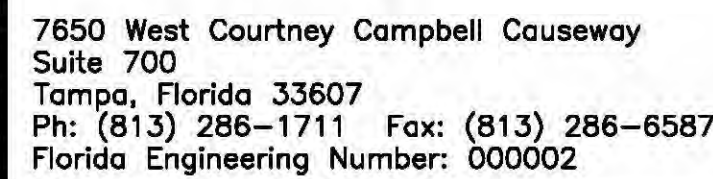[illegible]

URS JOB NUMBER	12007391
PM: C. OSMANSKI	
ENG: G. DAVIS	
DRW: G. DAVIS	
FILE SAVE DATE:	June 8, 2010




IMPROVEMENTS AT
TARA #20 MASTER LIFT STATION
FOR
MANATEE COUNTY GOVERNMENT
MANATEE COUNTY, FLORIDA

GENERATOR ENCLOSURE PLAN


GLENN H. DAVIS
FLORIDA P.E. NO. 66443

PROJECT STATUS
RECORD DRAWINGS
MAY 2010

E-4

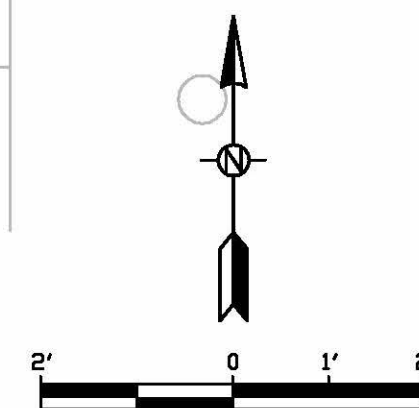

SCALE: 1/2"=1'-0"

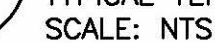

E-5


- ① PROVIDE ONE 3IN. SCHEDULE 80 PVC CONDUIT UG BETWEEN TERMINATION CABINET AND WET WELL PUMP FOR MANUFACTURER SUPPLIED MOTOR POWER CABLE.
- ② PROVIDE ONE 2IN. SCHEDULE 80 PVC CONDUIT UG BETWEEN TERMINATION CABINET AND WET WELL FOR PUMP MANUFACTURER SUPPLIED CONTROL WIRING CABLE.
- ③ PROVIDE CONDUIT/CABLE HANGER FOR MANUFACTURER SUPPLIED CABLES. PROVIDE KELLEMS STAINLESS STEEL STRAIN RELIEF DROP GRIP OR APPROVED EQUAL.
- ④ PROVIDE 12IN. SQ. BY 6IN. NEMA TYPE 4X 316L JUNCTION BOX FOR LEVEL TRANSMITTER AND FLOAT SWITCH CABLES. TERMINATE LEVEL TRANSMITTER CABLE AND FOUR(4) FLOAT CONTROL CABLES TO JUNCTION BOX USING APPROPRIATELY SIZED FLEXIBLE CABLE LIQUIDTIGHT STRAIN RELIEF CONNECTIONS WITH WIRE MESH GRIPS.
- ⑤ PROVIDE ONE 3IN. SCHEDULE 80 PVC CONDUIT UG BETWEEN TERMINATION CABINET AND VFD ENCLOSURES FOR PUMP MOTOR POWER CONDUCTORS.
- ⑥ PROVIDE ONE 2IN. SCHEDULE 80 PVC CONDUIT UG BETWEEN WET WELL JUNCTION BOX AND CONTROL CABINET FOR FLOAT CONTROL CABLES.
- ⑦ PROVIDE ONE 1IN. SCHEDULE 90 PVC CONDUIT UG BETWEEN WET WELL JUNCTION BOX AND CONTROL CABINET FOR LEVEL TRANSMITTER CONTROL CABLE.
- ⑧ PROVIDE TWO (2) 2IN. SCHEDULE 80 PVC CONDUIT UG BETWEEN TERMINATION CABINET AND CONTROL CABINET FOR PUMP MANUFACTURER'S MONITORING AND STATUS (MAS) CONTROL WIRING.
- ⑨ PROVIDE NEMA TYPE 4X 316SS NON-FUSED LOCAL SAFETY SWITCH.
- ⑩ PROVIDE CABINET WITH MINIMUM DIMENSIONS OF 24"H X 24"W X 12"D. PROVIDE TERMINATION BLOCK FOR CONDUCTORS WITH MINIMUM OF 25% SPARE CAPACITY.
- ⑪ PROVIDE EXPLOSIONPROOF SEAL FITTING(S) LISTED BY THE MANUFACTURER AS SUITABLE FOR USE IN CL.1, DIV. 1 & 2, GROUPS ABCDE CLASSIFIED HAZARDOUS ENVIRONMENTS. LOCATE AT 18" ABOVE GRADE WHERE CONDUITS EMERGE FROM GRADE.

RECORD DRAWING



7650 West Courtney Campbell Causeway
Suite 700
Tampa, Florida 33607
Ph: (813) 286-1711 Fax: (813) 286-6587
Florida Engineering Number: 000002

VERIFY SCALES: BAR IS ONE INCH ON ORIGINAL DRAWING 1 IF NOT ONE INCH ON THIS SHEET, ADJUST SCALE ACCORDINGLY
PLOTTED: 6/16/2010 10:50:10 AM ANNOTATED: 6/16/2010 10:50:10 AM
X:\MANATEE PROJECTS\12007391_TARA # 20 MASTER LIFT STATION - W44\CADD\E-6 SINGLE LINE DIAGRAM.DWG

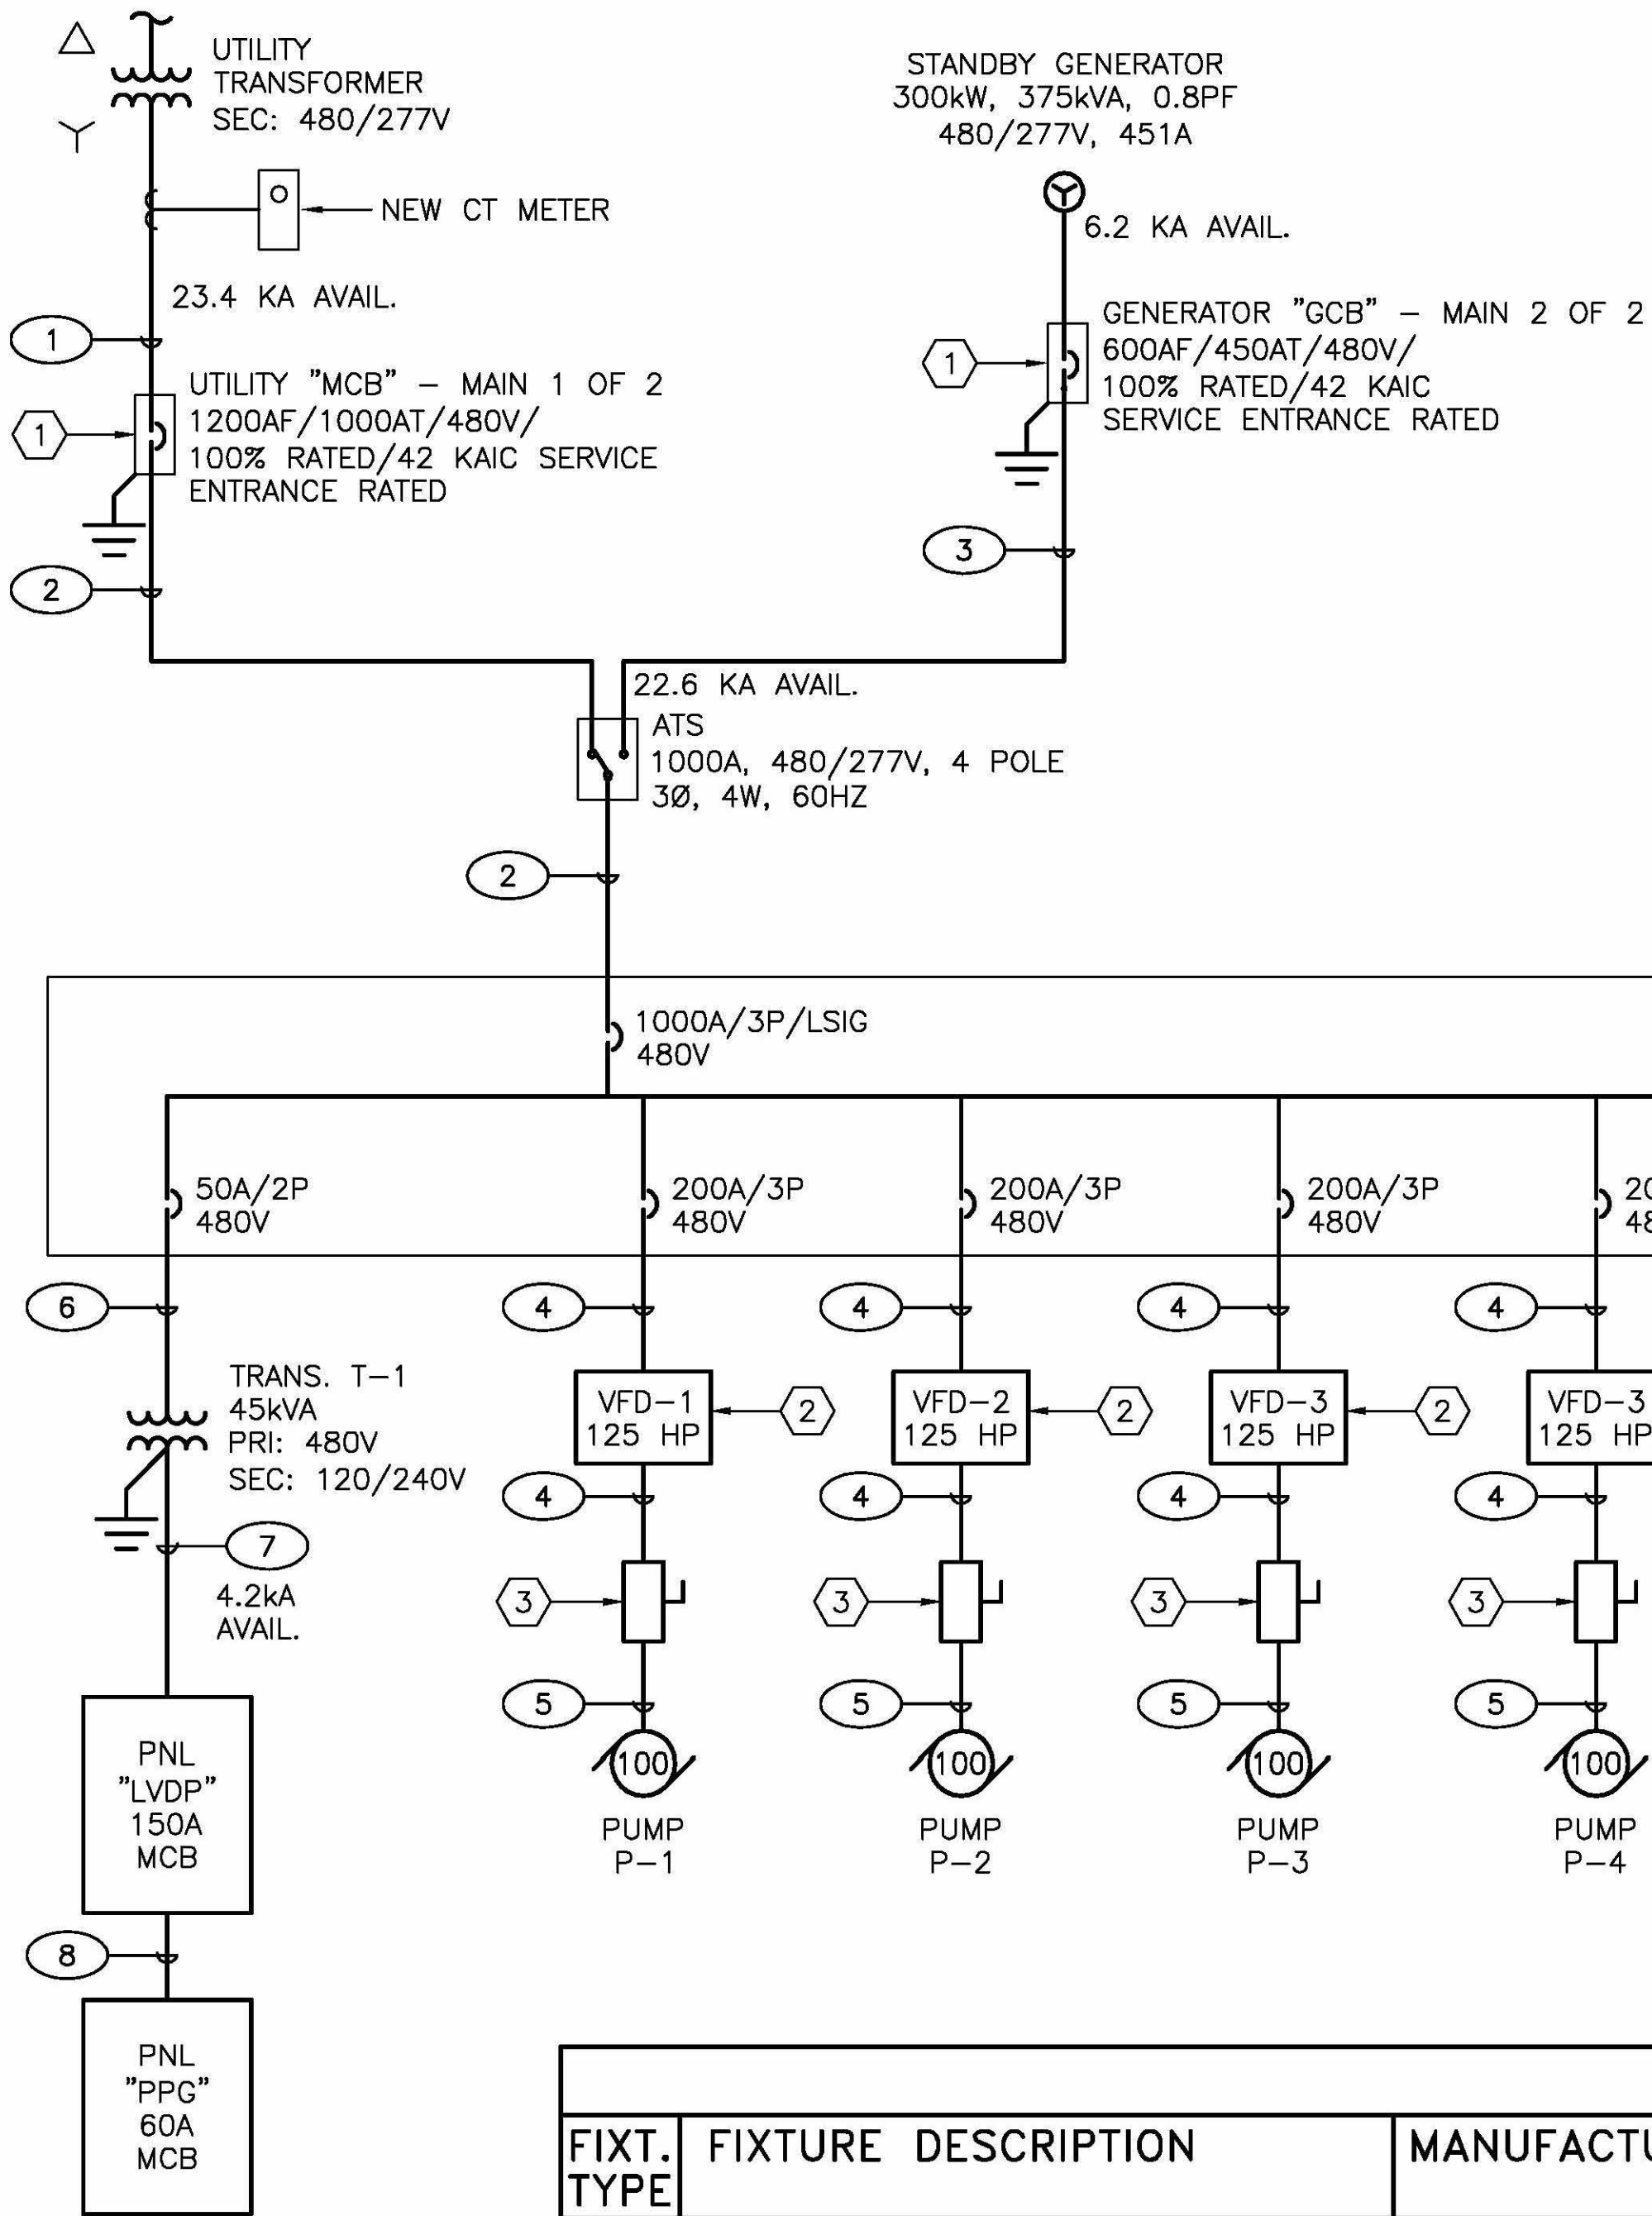

PANEL "LVDP"										MAINS: MCB		AMPS:150A		MOUNTING: SURFACE					
VOLTAGE: 240/120V										PHASE: 1		WIRE: 3		60HZ		MIN. INTERRUPTING RATING:10,000 A		NEMA: 12	
CKT NO	DESCRIPTION/LOCATION	BREAKERS		KVA		BREAKERS		DESCRIPTION/LOCATION	CKT NO										
		POLE	AMPS			AMPS	POLE												
1	PANEL "PPG"	2	60	8.18	0.26	20	1	INTERIOR LIGHTS	2										
3					1.14	20	1	EXTERIOR LIGHTS VIA CONTACTOR	4										
5	SPARE	1	20	—	—	20	1	SPARE	6										
7	CONTROL CABINET VIA UPS	1	20	1.80	—	20	1	SPARE	8										
9	SPARE	1	20	—	1.80	20	1	RECEPTACLES	10										
11	SPARE	1	20	—	1.80	20	1	RECEPTACLES	12										
13	SPARE	1	20	—	—	20	1	SPARE	14										
15	SPARE	1	20	—	0.20	20	1	TANK INVENTORY SYSTEM CONTROLLER	16										
17	SPACE	1	—	—	—	20	1	SPARE	18										
19	SPACE	1	—	—	—	20	1	SPARE	20										
21	SPACE	1	—	—	—	20	1	SPARE	22										
23	SPACE	1	—	—	—	—	1	SPACE	24										
25	SPACE	1	—	—	—	—	1	SPACE	26										
27	SPACE	1	—	—	—	—	1	SPACE	28										
29	SPACE	1	—	—	—	—	1	SPACE	30										
CONNECTED LOAD: 15.18 KVA																			

PANEL "PPG"										MAINS: MCB		AMPS:60A		MOUNTING: SURFACE					
VOLTAGE: 240/120V										PHASE: 1		WIRE: 3		60HZ		MIN. INTERRUPTING RATING: 10,000 A		NEMA: 12	
CKT NO	DESCRIPTION/LOCATION	BREAKERS		KVA		BREAKERS		DESCRIPTION/LOCATION	CKT NO										
		POLE	AMPS			AMPS	POLE												
1	JACKET WATER HEATER	1	30	2.50	0.58	30	1	LIGHTS	2										
3	EXHAUST FAN	1	20	1.50	1.80	20	1	RECEPTACLES	4										
5	WINDING HEATER	1	20	0.10	—	20	1	SPARE	6										
7	BATTERY CHARGER	1	20	1.50	0.20	20	1	TANK OVERFILL ALARM	8										
9	SPARE	1	20	—	—	20	1	SPARE	10										
11	SPARE	1	30	—	—	20	1	SPARE	12										
CONNECTED LOAD: 8.18 KVA																			

LIGHTING FIXTURE SCHEDULE						
FIXT. TYPE	FIXTURE DESCRIPTION	MANUFACTURER & BASIS OF DESIGN	NO. AND TYPE OF LAMPS	VOLT	MOUNTING	REMARKS
A	4' PENDANT MOUNTED FLUORESCENT, INDUSTRIAL LIGHTING FIXTURE CONSTRUCTED OF HEAVY GAUGE STEEL HOUSING WITH SOLID TOP REFLECTOR, ELECTRONIC START BALLAST, UL LISTING 1598 AND WIRE GUARD.	COLUMBIA LIGHTING - KL SERIES	(2) 32W, T8	120	PENDANT	
B	WALL MOUNTED HPS, CUTOFF, DIE CAST ALUMINUM HOUSING WITH ENCLOSED, GASKETED, ANODIZED ALUMINUM REFLECTOR, TEMPERED GLASS BOTTOM, TAMPER RESISTANT HARDWARE AND UL LISTED 1598, SUITABLE FOR USE IN WET LOCATIONS.	GE LIGHTING SYSTEMS, INC. - WALLIGHTER 250 CUTOFF SERIES	(1) 70W HPS	120	SURFACE	
C	POLE MOUNTED SITE FIXTURE	SPAULDING #CM1-MAF-S40-H3-F-Q-DB-F4	(1) 250W HPS	120	25' MTG. HT./CONC. POLE	IESNA FULL CUTOFF LIGHTING CLASSIFICATION


SERVICE LOAD SUMMARY	
LOAD DESCRIPTION:	LOAD (kVA)
LIGHTING, POWER, AND SMALL MOTOR LOADS (50kVA @ 125%)	62.5
NEW PUMP/VFD-1 100HP (128.9kVA @ 125%)	161.1
NEW PUMP/VFD-2 100HP (128.9kVA @ 100%)	128.9
NEW PUMP/VFD-3 100HP (128.9kVA @ 100%)	128.9
NEW PUMP/VFD-4 100HP (128.9kVA @ 100%)	128.9
SUB-TOTAL kVA	610.3
FUTURE CAPACITY (610.3kVA @ 125%)	762.9
TOTAL CURRENT (A) @ 480V, 3PH.	918A



7650 West Courtney Campbell Causeway
Suite 700
Tampa, Florida 33607
Ph: (813) 286-1711 Fax: (813) 286-6587
Florida Engineering Number: 000002

NO.	BY	DATE	DESCRIPTION
REVISIONS			

URS JOB NUMBER
12007391
PM: C. OSMANSKI
ENG: G. DAVIS
DRW: G. DAVIS
FILE SAVE DATE:
June 8, 2010

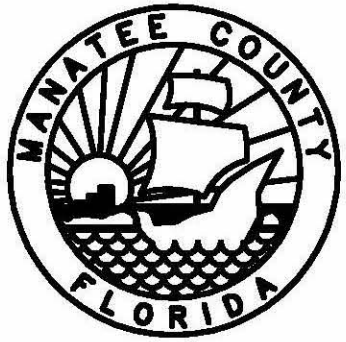

IMPROVEMENTS AT
TARA #20 MASTER LIFT STATION
FOR
MANATEE COUNTY GOVERNMENT
MANATEE COUNTY, FLORIDA

SINGLE LINE DIAGRAM

GLENN H. DAVIS
FLORIDA P.E. NO. 66443

PROJECT STATUS
RECORD DRAWINGS
MAY 2010

E-6

RECORD DRAWING

FEEDER SCHEDULE:


- (1) (3) SETS; (3) 500KCMIL PH. AND (1) 500KCMIL GROUNDED SERVICE CONDUCTOR IN 4IN. CONDUIT.
- (2) (3) SETS; (3) 500KCMIL PH., (1) 500KCMIL NEUT. AND (1) #2/0 AWG GND. IN 4IN. CONDUIT.
- (3) (2) SETS; (3)#4/0 AWG PH., (1)#4/0 AWG NEUT. AND (1)#2 AWG GND. IN 3IN. CONDUIT.
- (4) (3)#4/0 AWG PH., (1)#6 AWG GND. IN 2IN. CONDUIT.
- (5) CABLE PROVIDED BY PUMP MANUFACTURER.
- (6) (2)#1/0 AWG PH., (1)#6 AWG GND. IN 1-1/2" CONDUIT.
- (7) (2)#4/0 AWG PH., (1)#4/0 AWG NEUT. AND (1)#6 AWG GND. IN 2IN. CONDUIT.
- (8) (2)#4 AWG PH., (1)#4 AWG NEUT. AND (1)#10 AWG GND. IN 1-1/4IN. CONDUIT.
- (9) (3)#12 AWG PH. AND (1)#12 AWG GND. IN 3/4 IN. CONDUIT.
- (10) CONDUCTORS PROVIDED BY SPD MANUFACTURER.

REFERENCE NOTES:

- (1) PROVIDE NEUTRAL TO GROUND BOND. GROUNDING ELECTRODE CONDUCTOR (GEC) TO CONSIST OF #4/0 AWG FROM N-G BOND IN CIRCUIT BREAKER ENCLOSURE AND EXTENDED UNBROKEN TO TWO (2) 3/4" DIA. BY 10'-0" L COPPER CLAD STEEL VERTICALLY DRIVEN GROUND RODS IN ACCORDANCE WITH NEC 250.104. ROUTE EXTERIOR EXPOSED PORTIONS OF GEC IN PVC. ALL CONCEALED CONNECTIONS SHALL BE BY EXOTHERMIC WELD PROCESS.
- (2) PROVIDE 125 HP, 480V, PWM HEAVY DUTY USE RATED VFD IN A FREE STANDING, NEMA TYPE 12 ENCLOSURE.
- (3) PROVIDE NEMA TYPE 4X 316SS NON-FUSED 200A LOCAL DISCONNECTS.
- (4) PROVIDE SEPARATELY MOUNTED SURGE PROTECTIVE DEVICE (SPD) UNIT LISTED AS SUITABLE FOR INSTALLATION ON 480Y/277V, 60HZ, SUPPLY RATED FOR A MINIMUM OF 160KA PER PHASE AND 80KA PER MODE L-L, L-N, L-G AND N-G.

I/O DESIGNATION	DEVICE TYPE / DESCRIPTION	INDICATION TYPE	VOLTAGE	ASSOCIATED EQUIPMENT and/or LOCATION	REMARKS
PUMP 1 RUNNING	STOPPED/RUNNING	DI	24VDC	VFD 1	
PUMP 2 RUNNING	STOPPED/RUNNING	DI	24VDC	VFD 2	
PUMP 3 RUNNING	STOPPED/RUNNING	DI	24VDC	VFD 3	
PUMP 4 RUNNING	STOPPED/RUNNING	DI	24VDC	VFD 4	
PUMP 1 S/S	STOP/START	DO	–	VFD 1	DRY CONTACT
PUMP 2 S/S	STOP/START	DO	–	VFD 2	DRY CONTACT
PUMP 3 S/S	STOP/START	DO	–	VFD 3	DRY CONTACT
PUMP 4 S/S	STOP/START	DO	–	VFD 4	DRY CONTACT
PUMP 1 IN AUTO	H–O–A SW LOCAL/REMOTE	DI	24VDC	PUMP 1 H–O–A SW ON CONTROL CABINET	
PUMP 2 IN AUTO	H–O–A SW LOCAL/REMOTE	DI	24VDC	PUMP 2 H–O–A SW ON CONTROL CABINET	
PUMP 3 IN AUTO	H–O–A SW LOCAL/REMOTE	DI	24VDC	PUMP 3 H–O–A SW ON CONTROL CABINET	
PUMP 4 IN AUTO	H–O–A SW LOCAL/REMOTE	DI	24VDC	PUMP 4 H–O–A SW ON CONTROL CABINET	
VFD 1 SPEED CONTROL	VFD 1 SPEED CONTROL 0–100%	AO	–		4–20 mA
VFD 2 SPEED CONTROL	VFD 2 SPEED CONTROL 0–100%	AO	–		4–20 mA
VFD 3 SPEED CONTROL	VFD 3 SPEED CONTROL 0–100%	AO	–		4–20 mA
VFD 4 SPEED CONTROL	VFD 4 SPEED CONTROL 0–100%	AO	–		4–20 mA
VFD 1 SPEED RUNNING	VFD 1 SPEED RUNNING 0–100%	AI	–		4–20 mA
VFD 2 SPEED RUNNING	VFD 2 SPEED RUNNING 0–100%	AI	–		4–20 mA
VFD 3 SPEED RUNNING	VFD 3 SPEED RUNNING 0–100%	AI	–		4–20 mA
VFD 4 SPEED RUNNING	VFD 4 SPEED RUNNING 0–100%	AI	–		4–20 mA
WELL 1 LEVEL	WELL 1 LEVEL TRANSMITTER	AI	–		4–20 mA
WELL 2 LEVEL	WELL 2 LEVEL TRANSMITTER	AI	–		4–20 mA
DISCHARGE PRESSURE	PRESSURE TRANSMITTER	AI	–		4–20 mA
FLOW SENSOR	FLOW TRANSMITTER	AI	–		4–20 mA
GEN RUNNING	GENERATOR RUN STATUS CONTACTS	DI	24VDC	GENERATOR CONTROL PANEL	
GEN ALARM	GENERATOR SUMMARY ALARM	DI	24VDC	GENERATOR CONTROL PANEL	
WELL 1 HIGH LEVEL	FLOAT CONTACT	DI	24VDC	WELL 1 HIGH LEVEL FLOAT	
WELL 1 LOW LEVEL	FLOAT CONTACT	DI	24VDC	WELL 1 LOW LEVEL FLOAT	
WELL 2 HIGH LEVEL	FLOAT CONTACT	DI	24VDC	WELL 2 HIGH LEVEL FLOAT	
WELL 2 LOW LEVEL	FLOAT CONTACT	DI	24VDC	WELL 2 LOW LEVEL FLOAT	
ATS LOSS OF POWER	ATS LOSS OF POWER CONTACT	DI	24VDC	ATS CONTROLLER	
ATS – NORMAL	ATS IN NORMAL POSITION CONTACT	DI	24VDC	ATS CONTROLLER	
ATS – EMERGENCY	ATS IN EMERGENCY POSITION CONTACT	DI	24VDC	ATS CONTROLLER	
GEN FUEL TANK LOW	GEN FUEL TANK LOW CONTACT	DI	24VDC	TANK GAUGING CONTROLLER	SET AT <25%
GEN FUEL TANK LEAK	GEN FUEL TANK LEAK CONTACT	DI	24VDC	TANK GAUGING CONTROLLER	
PUMP 1 FAULT	PUMP FAULT	DI	24VDC	PUMP 1 MAS CONTROLLER/VFD	
PUMP 2 FAULT	PUMP FAULT	DI	24VDC	PUMP 2 MAS CONTROLLER/VFD	
PUMP 3 FAULT	PUMP FAULT	DI	24VDC	PUMP 3 MAS CONTROLLER/VFD	
PUMP 4 FAULT	PUMP FAULT	DI	24VDC	PUMP 4 MAS CONTROLLER/VFD	

RECORD DRAWING

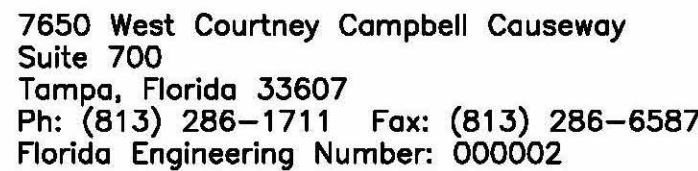

NO.	BY	DATE	DESCRIPTION
REVISIONS			

URS JOB NUMBER
12007391
PM: C. OSMANSKI
ENG: G. DAVIS
DRW: G. DAVIS
FILE SAVE DATE:
November 19, 2008



IMPROVEMENTS AT
TARA #20 MASTER LIFT STATION
FOR
MANATEE COUNTY GOVERNMENT
MANATEE COUNTY, FLORIDA

PLC INPUT-OUTPUT SCHEDULE

GLENN H. DAVIS
FLORIDA P.E. NO. 66443

PROJECT STATUS
RECORD DRAWINGS
MAY 2010

E-7