



MANATEE COUNTY

April 18, 2013

All Interested Bidders:

SUBJECT: Invitation for Bid #13-1324-OV
McCollum's Lake Subdivision Resurfacing Project and
Leffingwell Avenue, From US 301 to Cedar Street
(aka 9th Street) (CDBG Project)

ADDENDUM #1

Bidders are hereby notified that this Addendum shall be acknowledged on page 40 of the Bid Form and made a part of the above named bidding and contract documents. Bids submitted without acknowledgement of the Addendum will be considered incomplete.

The following items are issued to add to, modify, and clarify the bid and contract documents. These items shall have the same force and effect as the original bidding and contract documents, and cost involved shall be included in the bid prices. Bids to be submitted on the specified bid date, shall conform to the additions and revisions listed herein.

Bidders Note: The deadline for clarification requests was **April 17, 2013 at 5:00 PM**. This deadline has been established to maintain fair treatment of all potential bidders, while maintaining the expedited nature of the Economic Stimulus that the contracting of this work may achieve. Questions received after this date and time shall not be considered.

A public records request was made for the engineer's estimate for this project.

Attached is a copy of the engineer's estimate letter (1 page) dated April 16, 2013.

Bidders Note: Clarification and Responses to questions received at the Non-Mandatory Information Conference which was held on April 10, 2013 and questions receiving through the clarification period of April 17, 2013.

Financial Management Department – Purchasing Division
1112 Manatee Avenue West, Suite 803, Bradenton, FL 34205
Phone: 941-749-3055 – Fax: 941-749-3034
www.myanatee.org

LARRY BUSTLE * MICHAEL GALLEN* JOHN R. CHAPPIE * ROBIN DISABATINO * VANESSA BAUGH * CAROL WHITMORE * BETSY BENAC
District 1 District 2 District 3 District 4 District 5 District 6 District 7

April 18, 2013
Invitation for Bid #13-1324-OV
McCollum's Lake Subdivision Resurfacing Project
and Leffingwell Avenue, From US 301 to Cedar Street
(aka 9th Street) CDBG Project

Bidders Note: Option #2, Typical Sheet #4 has been modified to show a wedge mill. PDFs of revised sheets, #4, 5 and #10 shall be made a part of this Addendum No. 1

Q1. Please provide the overall yield on the project.

A1. The overall yield on the project will be 138# or 1 1/4" of SIII Asphalt.

Q2. Are Reflective Pavement Markers required on Leffingwell Avenue?

A2. Yes, Reflective Pavement Markers are required on Leffingwell Avenue.

Q3. Please provide clarification as to the whether or not the cul-de-sac will be edge milled.

A3. Plan sheets #5 and #10 have been modified to show the edge milled in the cul-de-sac.

Q4. Does this project require Thermo Plastic Pavement Markings?

A4. No, this project does not require Thermo Plastic Pavement Markings. See note on modified Plan Sheet #4.

If you have submitted a bid prior to receiving this addendum, you may request in writing that your original, sealed bid be returned to your firm. All sealed bids received will be opened on the date stated.

END OF ADDENDUM #1

Bids will be received at the **Manatee County Purchasing Division, 1112 Manatee Avenue West, Suite 803, Bradenton, FL 34205** until **2:30 P.M. on April 26, 2013.**

Sincerely,



Melissa Wendel, CPPO
Purchasing Official, Purchasing Division

Ov/ (4 total pages attached)


MEMORANDUM



Public Works Department
Project Management Division
1022 26th Avenue East
Bradenton, FL 34208

Phone: 941.708-7450
Fax: 941.708-7579
www.mymanatee.org

MANATEE COUNTY FLORIDA


To: Olga Valcich, Contract Specialist
From: Brian Martineau, Senior Engineering Specialist 
Date: April 16, 2013
Subject: McCollums Lake Subdivision and Leffingwell Ave CDBG project estimate
IFB #13-1324-OV

The Construction Cost for the proposed McCollums Lake Subdivision and Leffingwell Ave CDBG resurfacing projects, as depicted on the approved Construction Plans is estimated to be **\$93,666.00** for McCollums Lake Subdivision and **\$15,237.80** for Leffingwell Ave.

If you have any questions, or require additional information, please do not hesitate to call me at Ext 7243.

cc by email.


Chad Butzow, P.E. Deputy Director
Jeff Streitmatter, P.E. Project Management Division Manager
Suzie Dobbs, Community Development Division Manager
William O'Shea, Community Development Project Manager

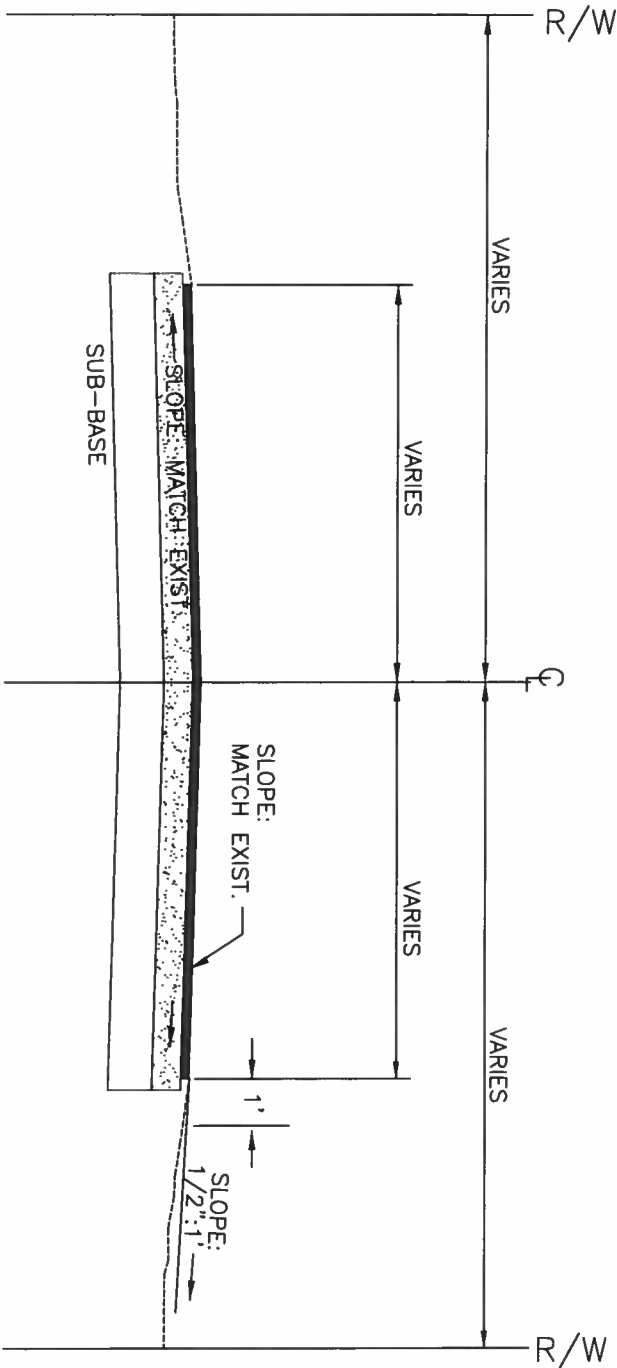

TYPICAL SECTION
NTS


NOTES:

- ALL WORK SHALL BE DONE IN ACCORDANCE WITH FDOT STANDARD SPECIFICATIONS FOR ROADS AND BRIDGES 2000 EDITION.
- IT IS THE CONTRACTORS RESPONSIBILITY TO VERIFY ALL MEASUREMENTS.
- THE VENDOR SHALL FURNISH ALL NECESSARY SIGNS, FLAG PERSONS, MESSAGE BOARDS, ETC. THAT ARE IN KEEPING WITH GOOD PRACTICE AND/OR REQUIRED BY THE COUNTY FOR TRAFFIC CONTROL.
- CONTRACTOR SHALL NOTIFY ALL RESIDENTS, BUSINESSES AND ASSOCIATIONS IN THE PROJECT LIMITS A MINIMUM OF 72 HOURS PRIOR TO THE ONSET OF CONSTRUCTION.
- THE CONTRACTOR WILL PROVIDE THE COUNTY THE PAVEMENT DESIGN EFFECTIVE THE DAY OF PAVING OPERATIONS.
- THE CONTRACTOR MUST RESURFACE ANY MILLED SURFACE WITHIN 24 HOURS.
- THE VENDOR SHALL HAUL ALL ASPHALT MILLING; PRODUCED FROM THE MILLING PROCESS TO THE COUNTY YARD LOCATED ON 69TH ST. E. THE CONTRACTOR IS RESPONSIBLE FOR THE REMOVAL AND DISPOSAL OF ALL OTHER EXCESS MATERIAL.
- DRIVEWAYS ALONG THE STREETS SHALL BE DONE AS AN AS REQUIRED BASIS TO OBTAIN A SMOOTH TRANSITION FROM ROAD TO DRIVEWAY AND SUPPORT THE EDGE OF PAVEMENT.
- AT NO TIME CAN THE ROAD BE CLOSED.
- ALL MANHOLE AND WATER VALVE RISERS MUST BE METAL.
- NO MANATEE COUNTY R/W USE PERMIT REQUIRED.
- NO TESTING WILL BE REQUIRED.
- THERMO PLASTIC NOTE REQUIRED.

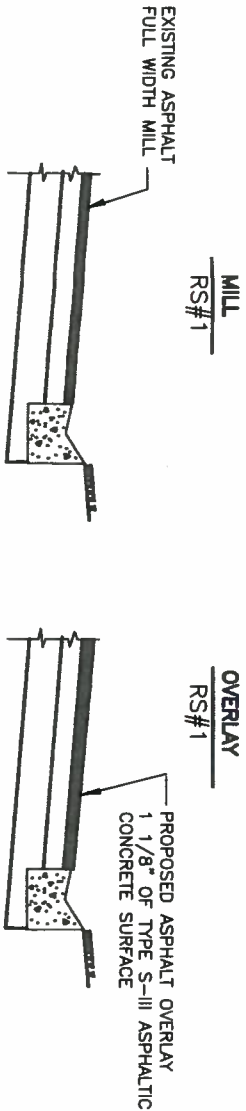


NOTE: SHOULDER WORK MAY BE REQUIRED WHEN NO CURB IS PRESENT

RESURFACING OPTION #1
FULL WIDTH WITH SINGLE LIFT OVERLAY
NTS

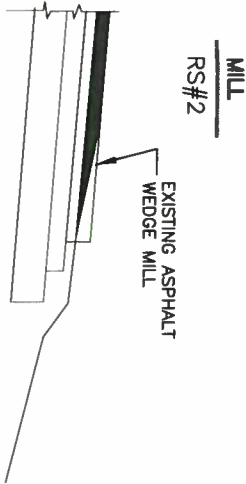

RESURFACING OPTION #2
WEDGE MILL AND OVERLAY
NTS

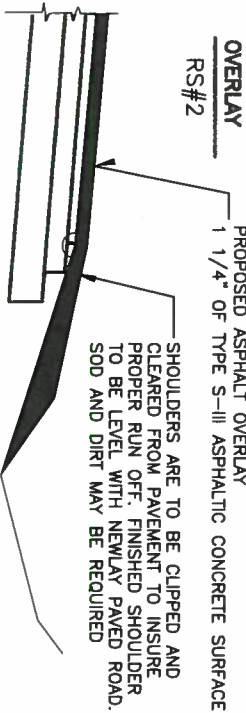

RESURFACING OPTION #2
ASPHALT OVERLAY
NTS

CDBC RESURFACING
MCCOLLUM LAKE SUBDIVISION
AND LEFFINGWELL AVE.

DETAILS




NO.	REVISION DESCRIPTION	BY	DATE
1	THERMO NOTE	BM	4/12/13
1	WEDGE MILL	BM	4/12/13
1	SHOULDER	BM	4/12/13

PROJECT #	17B--0019904
SURVEY #	N/A
SEC./TWN./RGE	S10/T35/R17
SCALE	1"=40'
BY	DATE
SURVEYED	N/A
DESIGNED	CB/BM 10/25/2012
DRAWN	CB 10/25/2012
CHECKED	BM 10/25/2012
BRIAN MARTINEAU	
PAVEMENT MANAGER	

Signature & Date
4-15-13

* CONTRACTOR RESPONSIBILITY
TO VERIFY ALL MEASUREMENTS

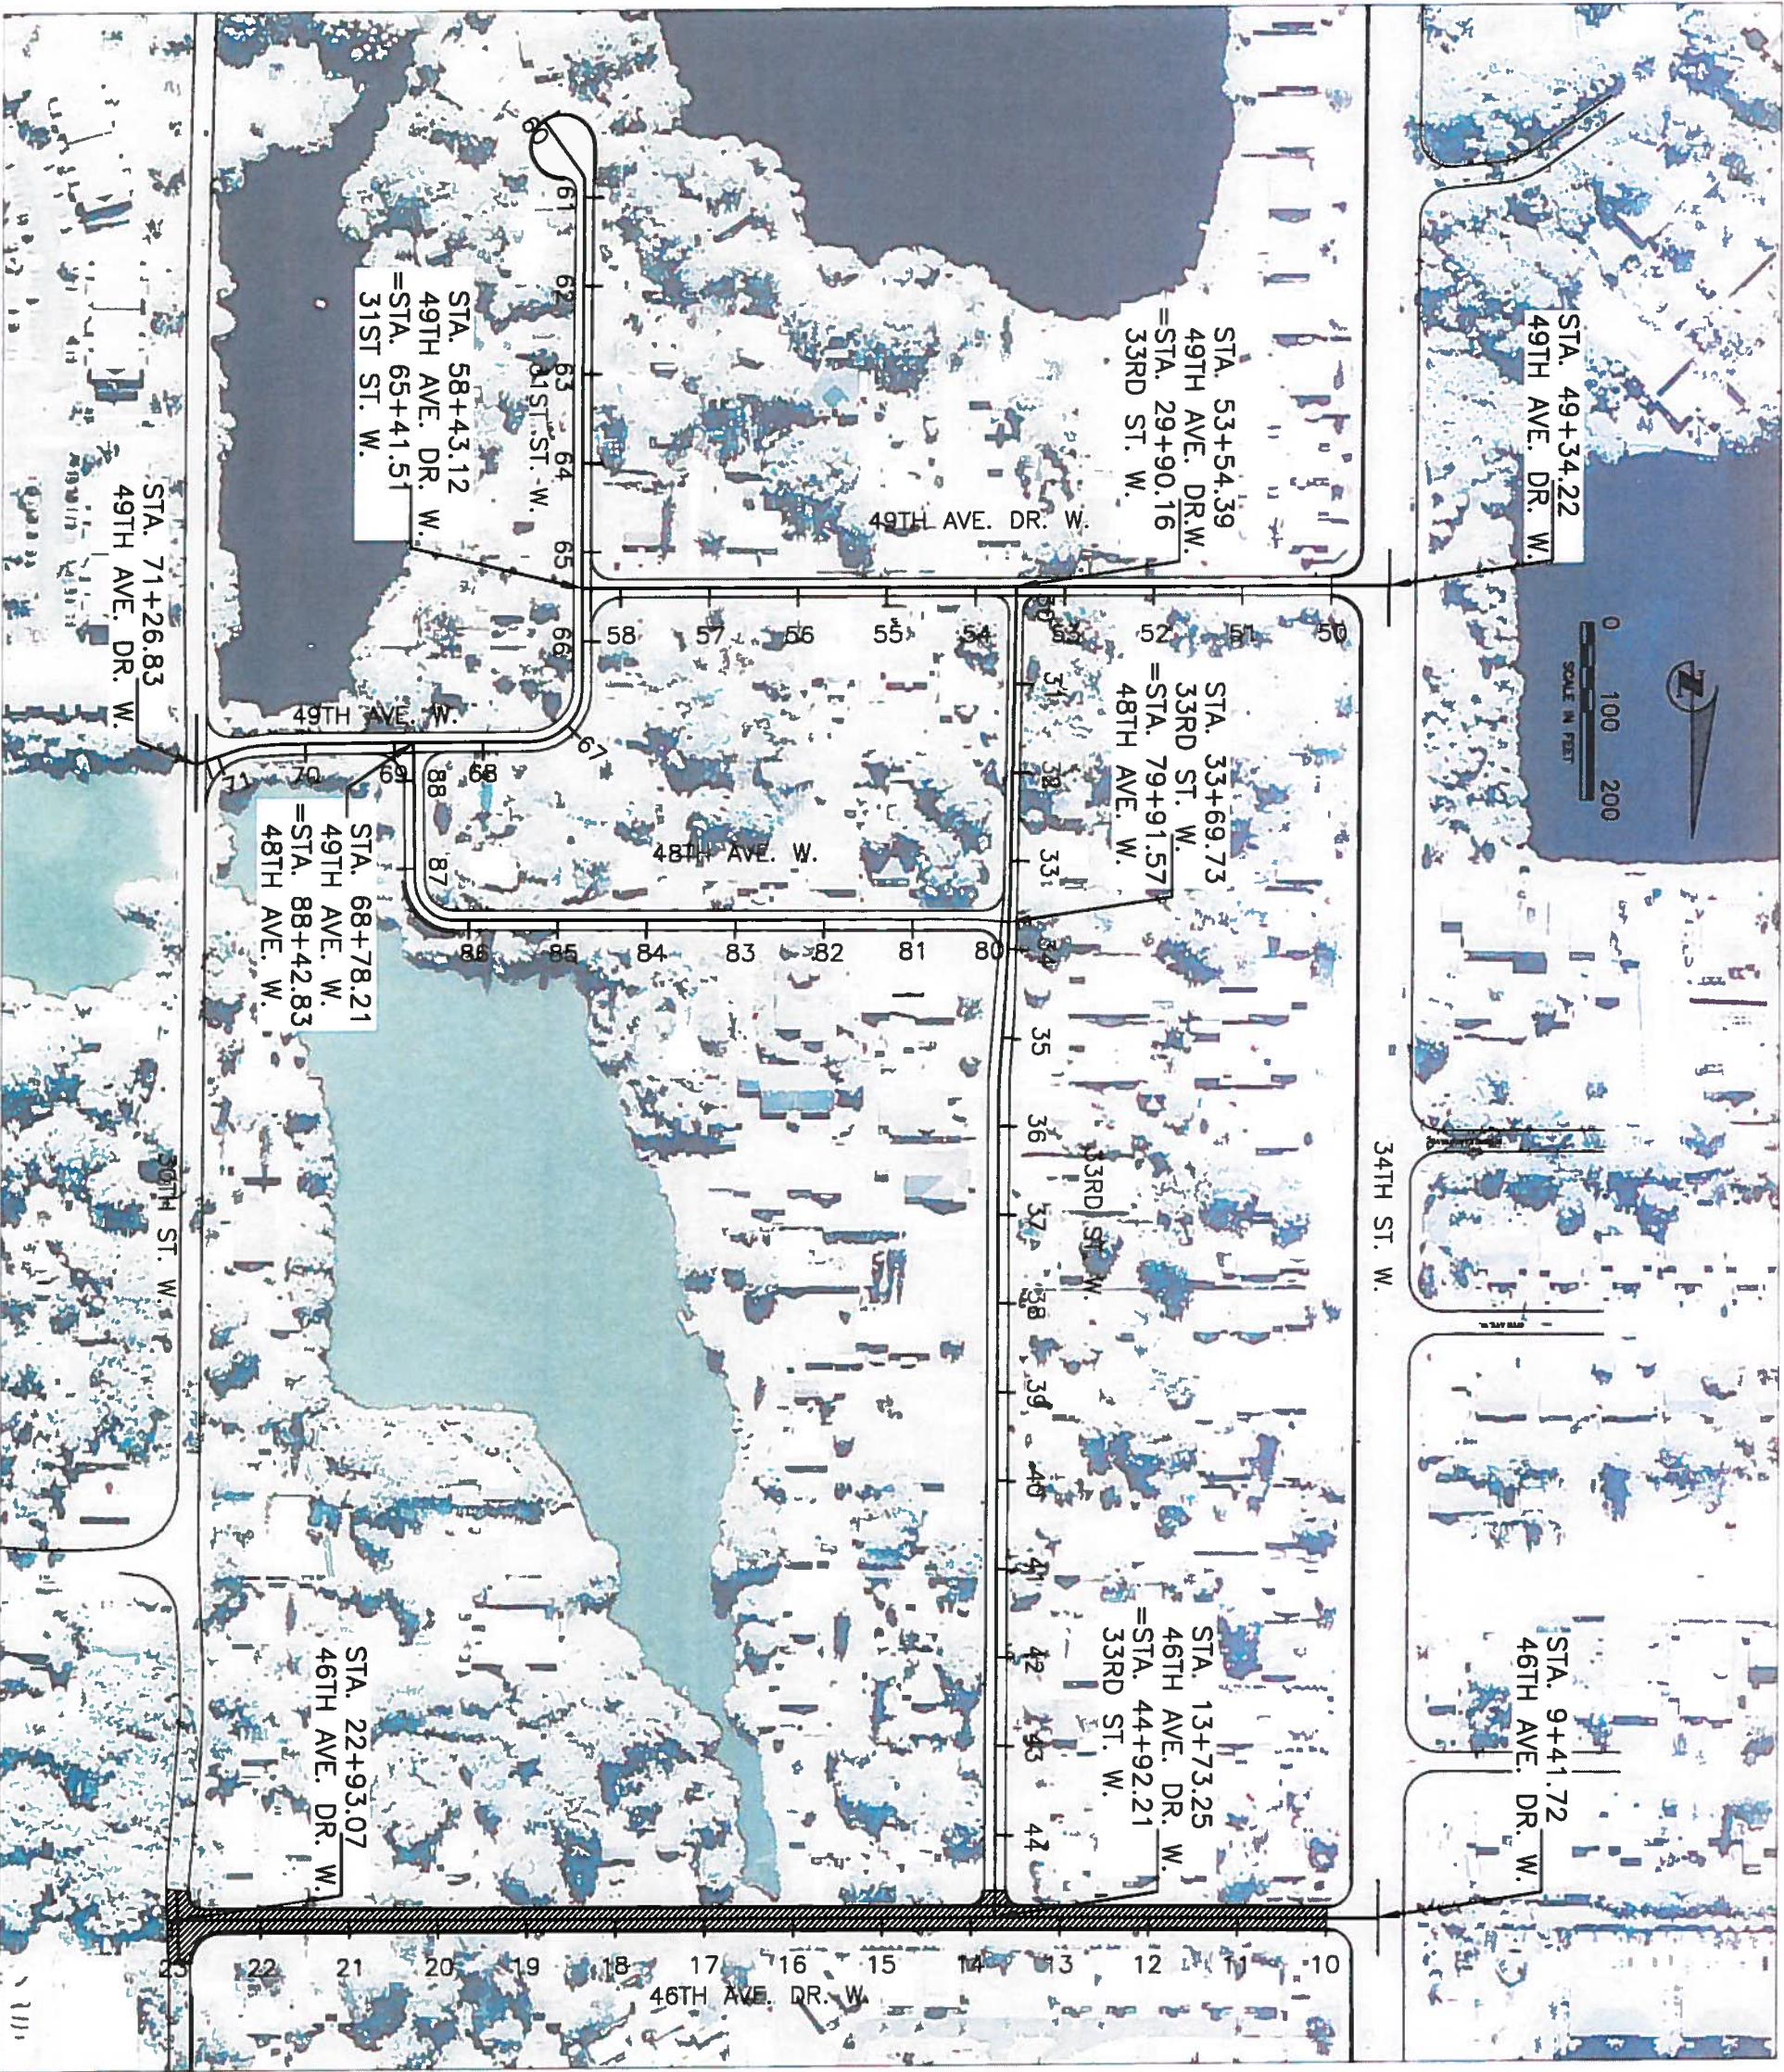

CDBC RESURFACING MCCOLLUM LAKE SUBDIVISION AND LEFFINGWELL AVE. CONTROL SHEET


NO.	REVISION DESCRIPTION	BY	DATE
1	REMOVE HATCHING	BM	4/12/13
PROJECT #	17B-0019904		
SURVEY #	N/A		
SEC./TWN./RGE	S.10/T.35/R.17		
SCALE	AS SHOWN		
SURVEYED	N/A		
DESIGNED	CB/BM		10/25/2012
DRAWN	CB		10/25/2012
CHECKED	BM		10/25/2012

BRIAN MARTINEAU
PAVEMENT MANAGER


Signature & Date
SHEET 5

OPTION #1

OPTION #2

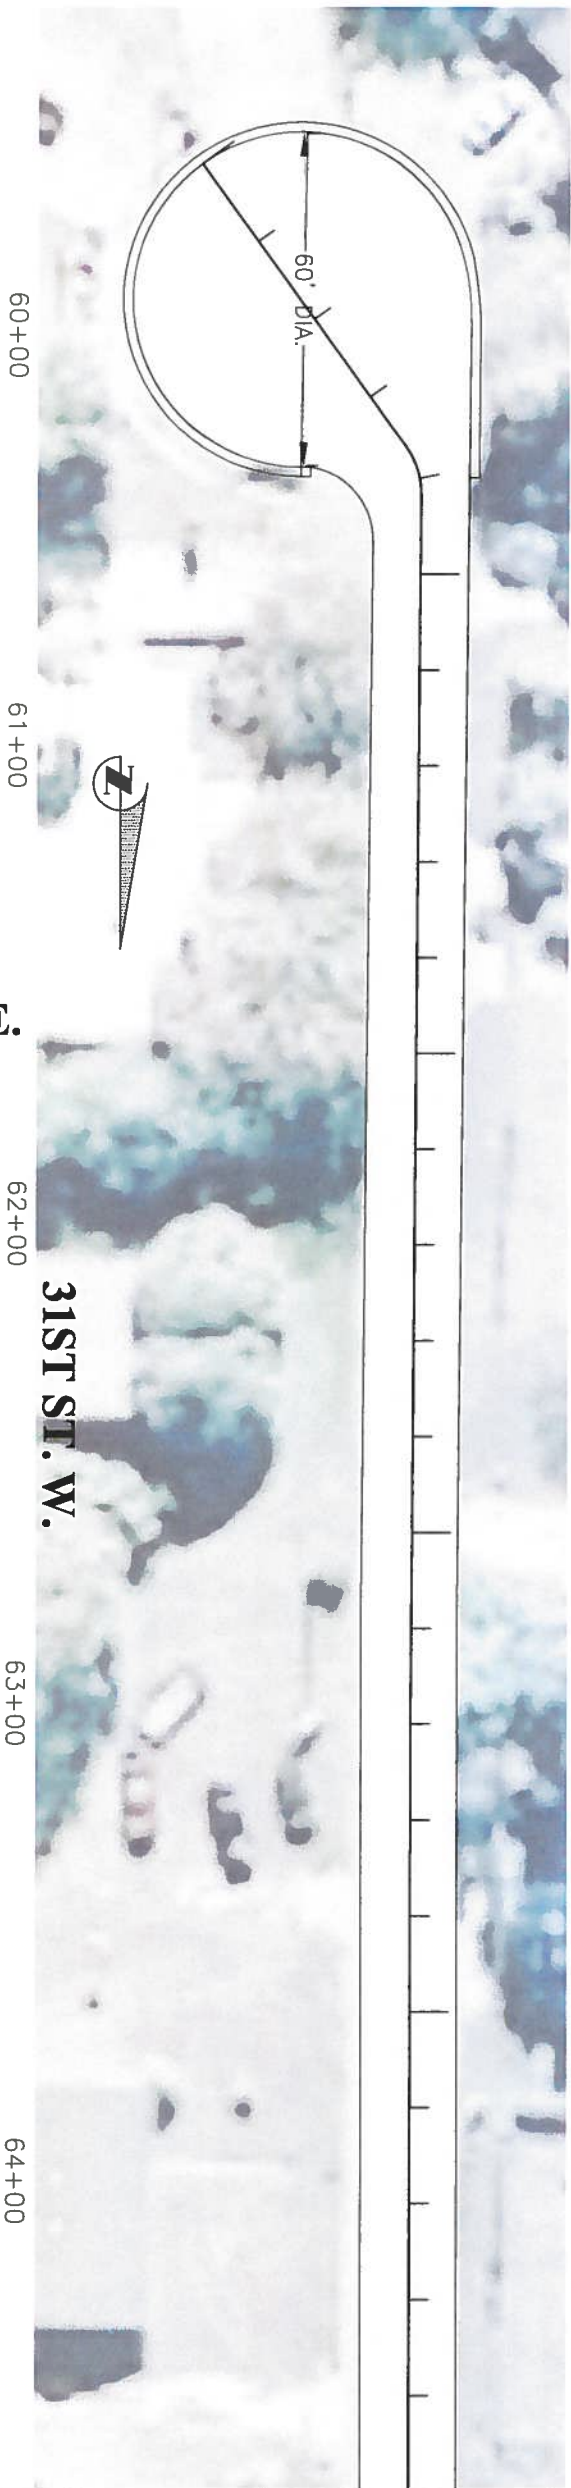

MATCH LINE STA. 65+00

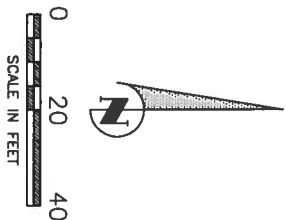

31ST ST. W.
STA. 58+43.12
49TH AVE. DR. W.
=STA. 65+41.51
31ST ST. W.

OPTION #2

49TH AVE. DR. W.

MATCH LINE
65+00

31ST ST. W.

65+00

66+00

49TH AVE. W.
MATCH LINE
67+20

OPTION #2

34+00

48TH AVE. W.

STA. 68+78.21
49TH AVE. DR. W.
=STA. 88+42.83
48TH AVE. W.



MATCH LINE
STA. 67+20

49th AVE. W.

68+00

69+00

70+00

71+00

30TH AVE. W.

STA. 71+26.83
49TH AVE. DR. W.

**CDBC RESURFACING
MCCOLLUM LAKE SUBDIVISION
AND LEFFINGWELL AVE.
31ST STREET W. AND 49TH AVENUE W.
STA. 60+00 TO STA. 71+14**



NO.	REVISION DESCRIPTION	BY	DATE
1	REMOVE HATCHING	BM	4/12/13
1	OPTION #1	BM	4/12/13
PROJECT # 178-0019904			
SURVEY # N/A			
SEC./TWN./RGE S10/T35/R17			
SCALE 1"=40'			
BY DATE			
SURVEYED N/A N/A			
DESIGNED CB/BM 10/25/2012			
DRAWN CB 10/25/2012			
CHECKED BM 10/25/2012			
BRIAN MARTINEAU			
PAVEMENT MANAGER			
Signature & Date 4-15-13			
SHEET 10			