


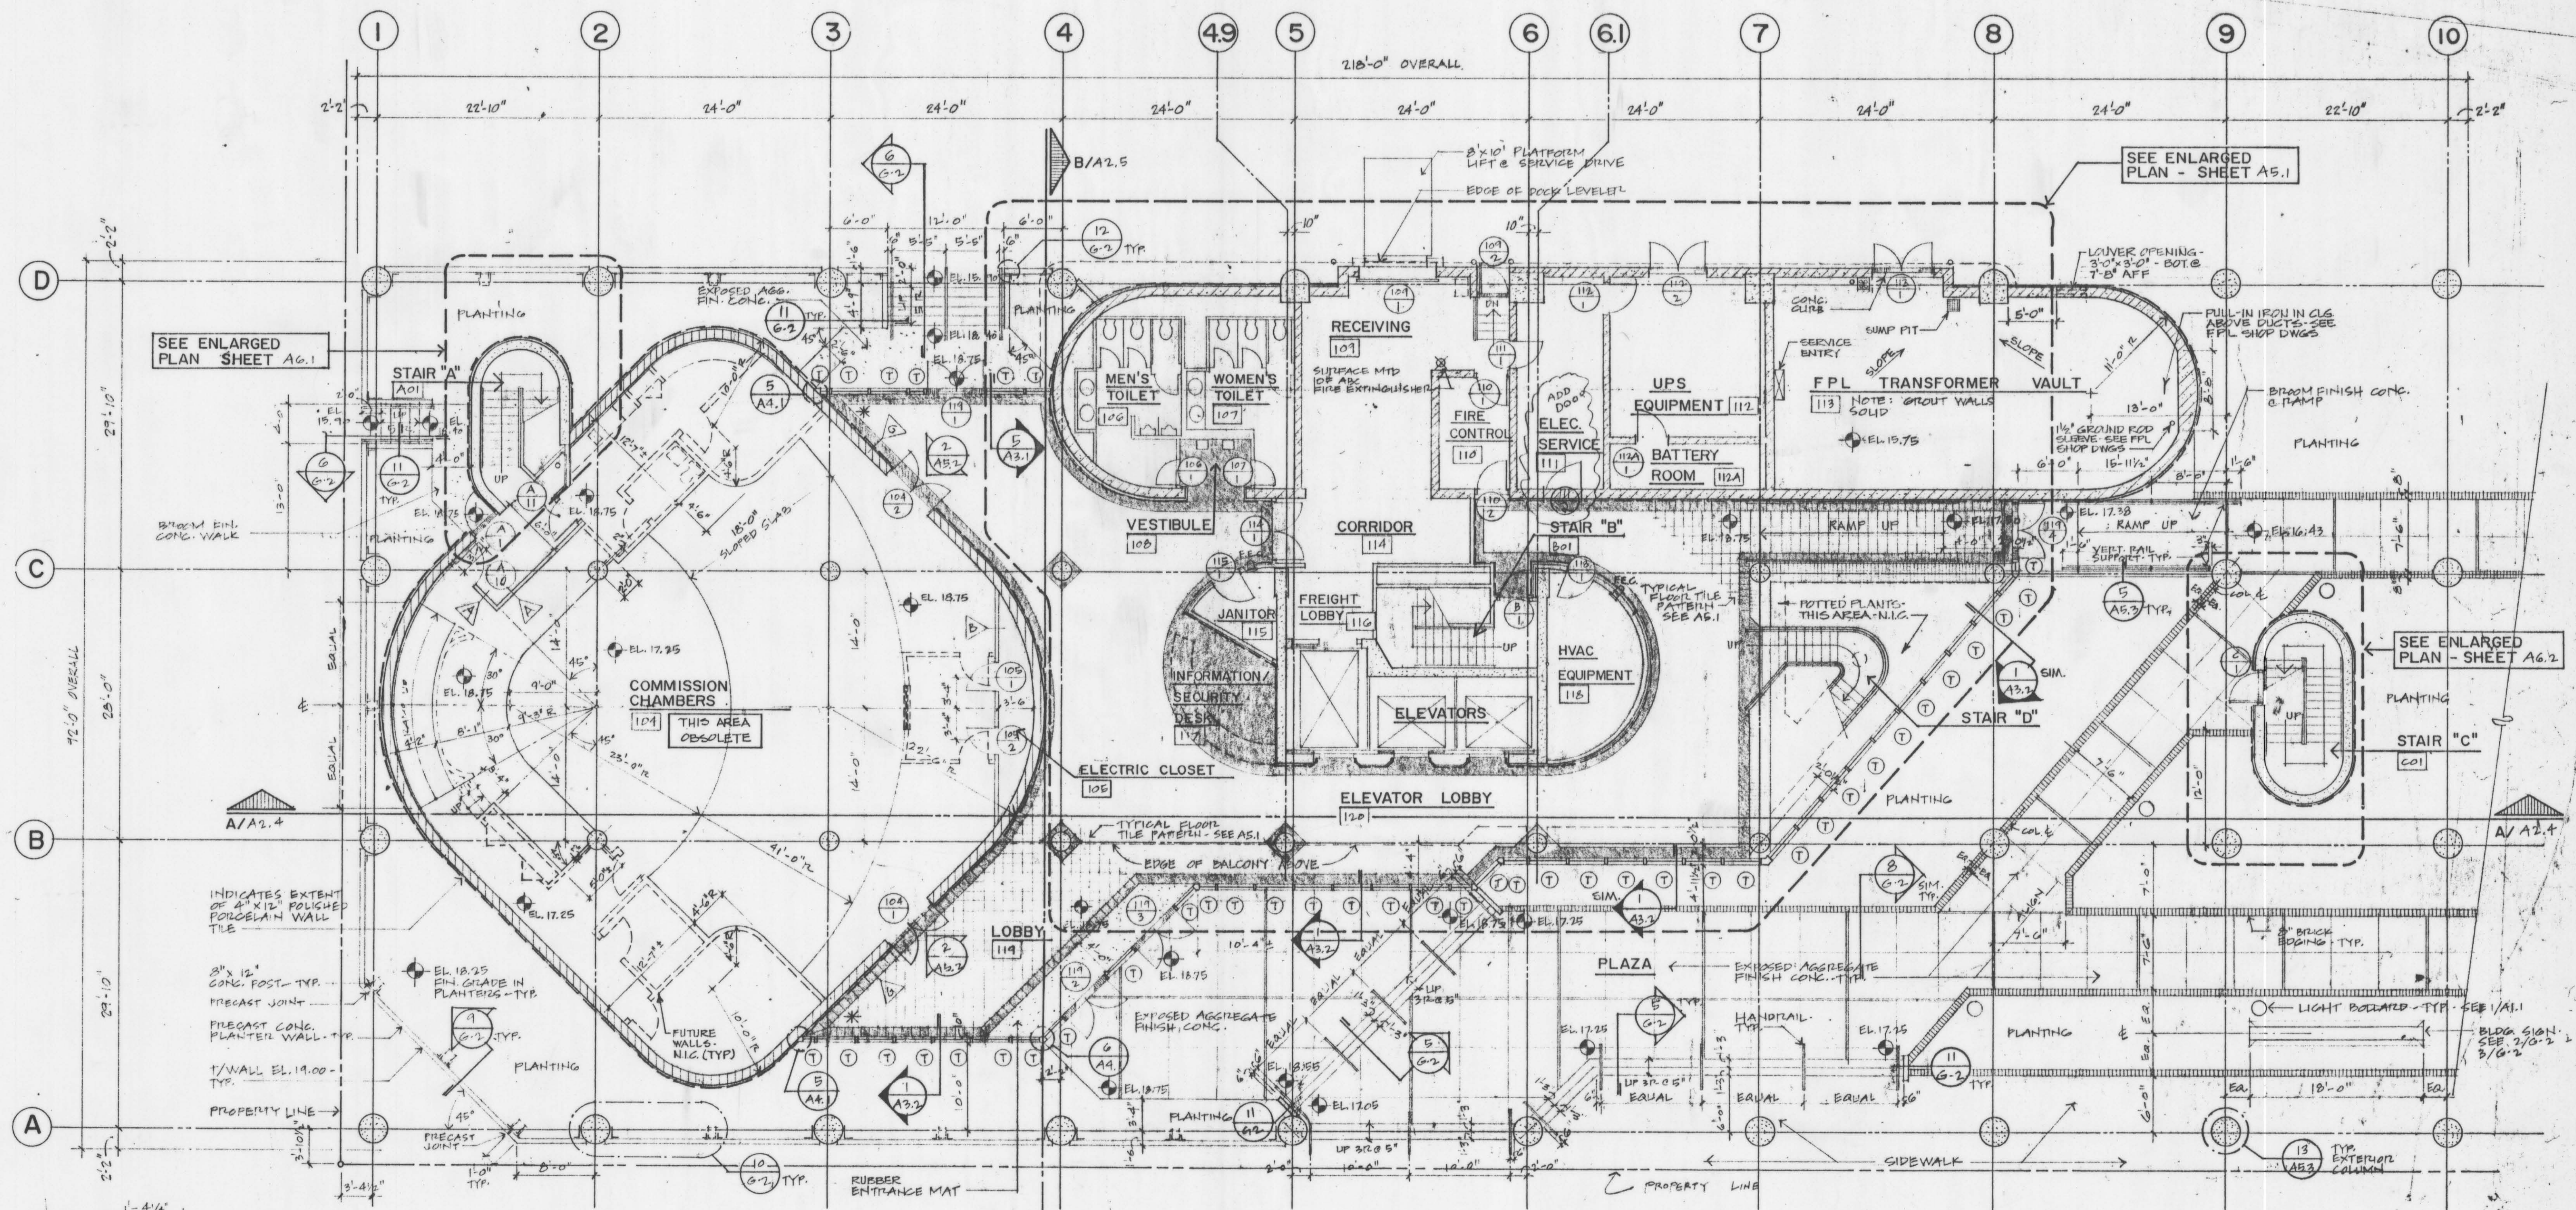

First Floor Plan

1/8" = 1'-0"
FIN. FLR. ELEVATION 18.75' (0'-0")

(T) DENOTES TEMPERED GLASS PANELS

(A) DENOTES 8" x 8" PORCELAIN ACCENT
FLOOR TILE - GRANITE GREY

FEC. RECESSED FIRE EXTINGUISHER CABINET

* INDICATES LOCATION OF FUTURE PUBLIC
PHONE KIOSK - N.I.C.
VERIFY LOCATION & TYPE IN FIELD.

Grating Detail

1 1/2" = 1'-0"

First Floor Plan - Office Building

**Manatee County
Governmental Complex**

Bradenton, Florida

The Huntington Group Architects, Inc.
1001 3rd Avenue West Suite 300 Bradenton, Florida 33505 813/746-3505

Williams Trebilcock Whitehead Architects Planners Interior Designers
38 East Pine Street Orlando, Florida 32801 305/423-7802

Drawing No.

A1.1

Date

10/1/88

Project No.

6801

AS BUILT

AGENCY:
COUNTY: *Manatee*
DEVELOPER: *Manatee County*

Light Bollard Detail

3/4" = 1'-0"