


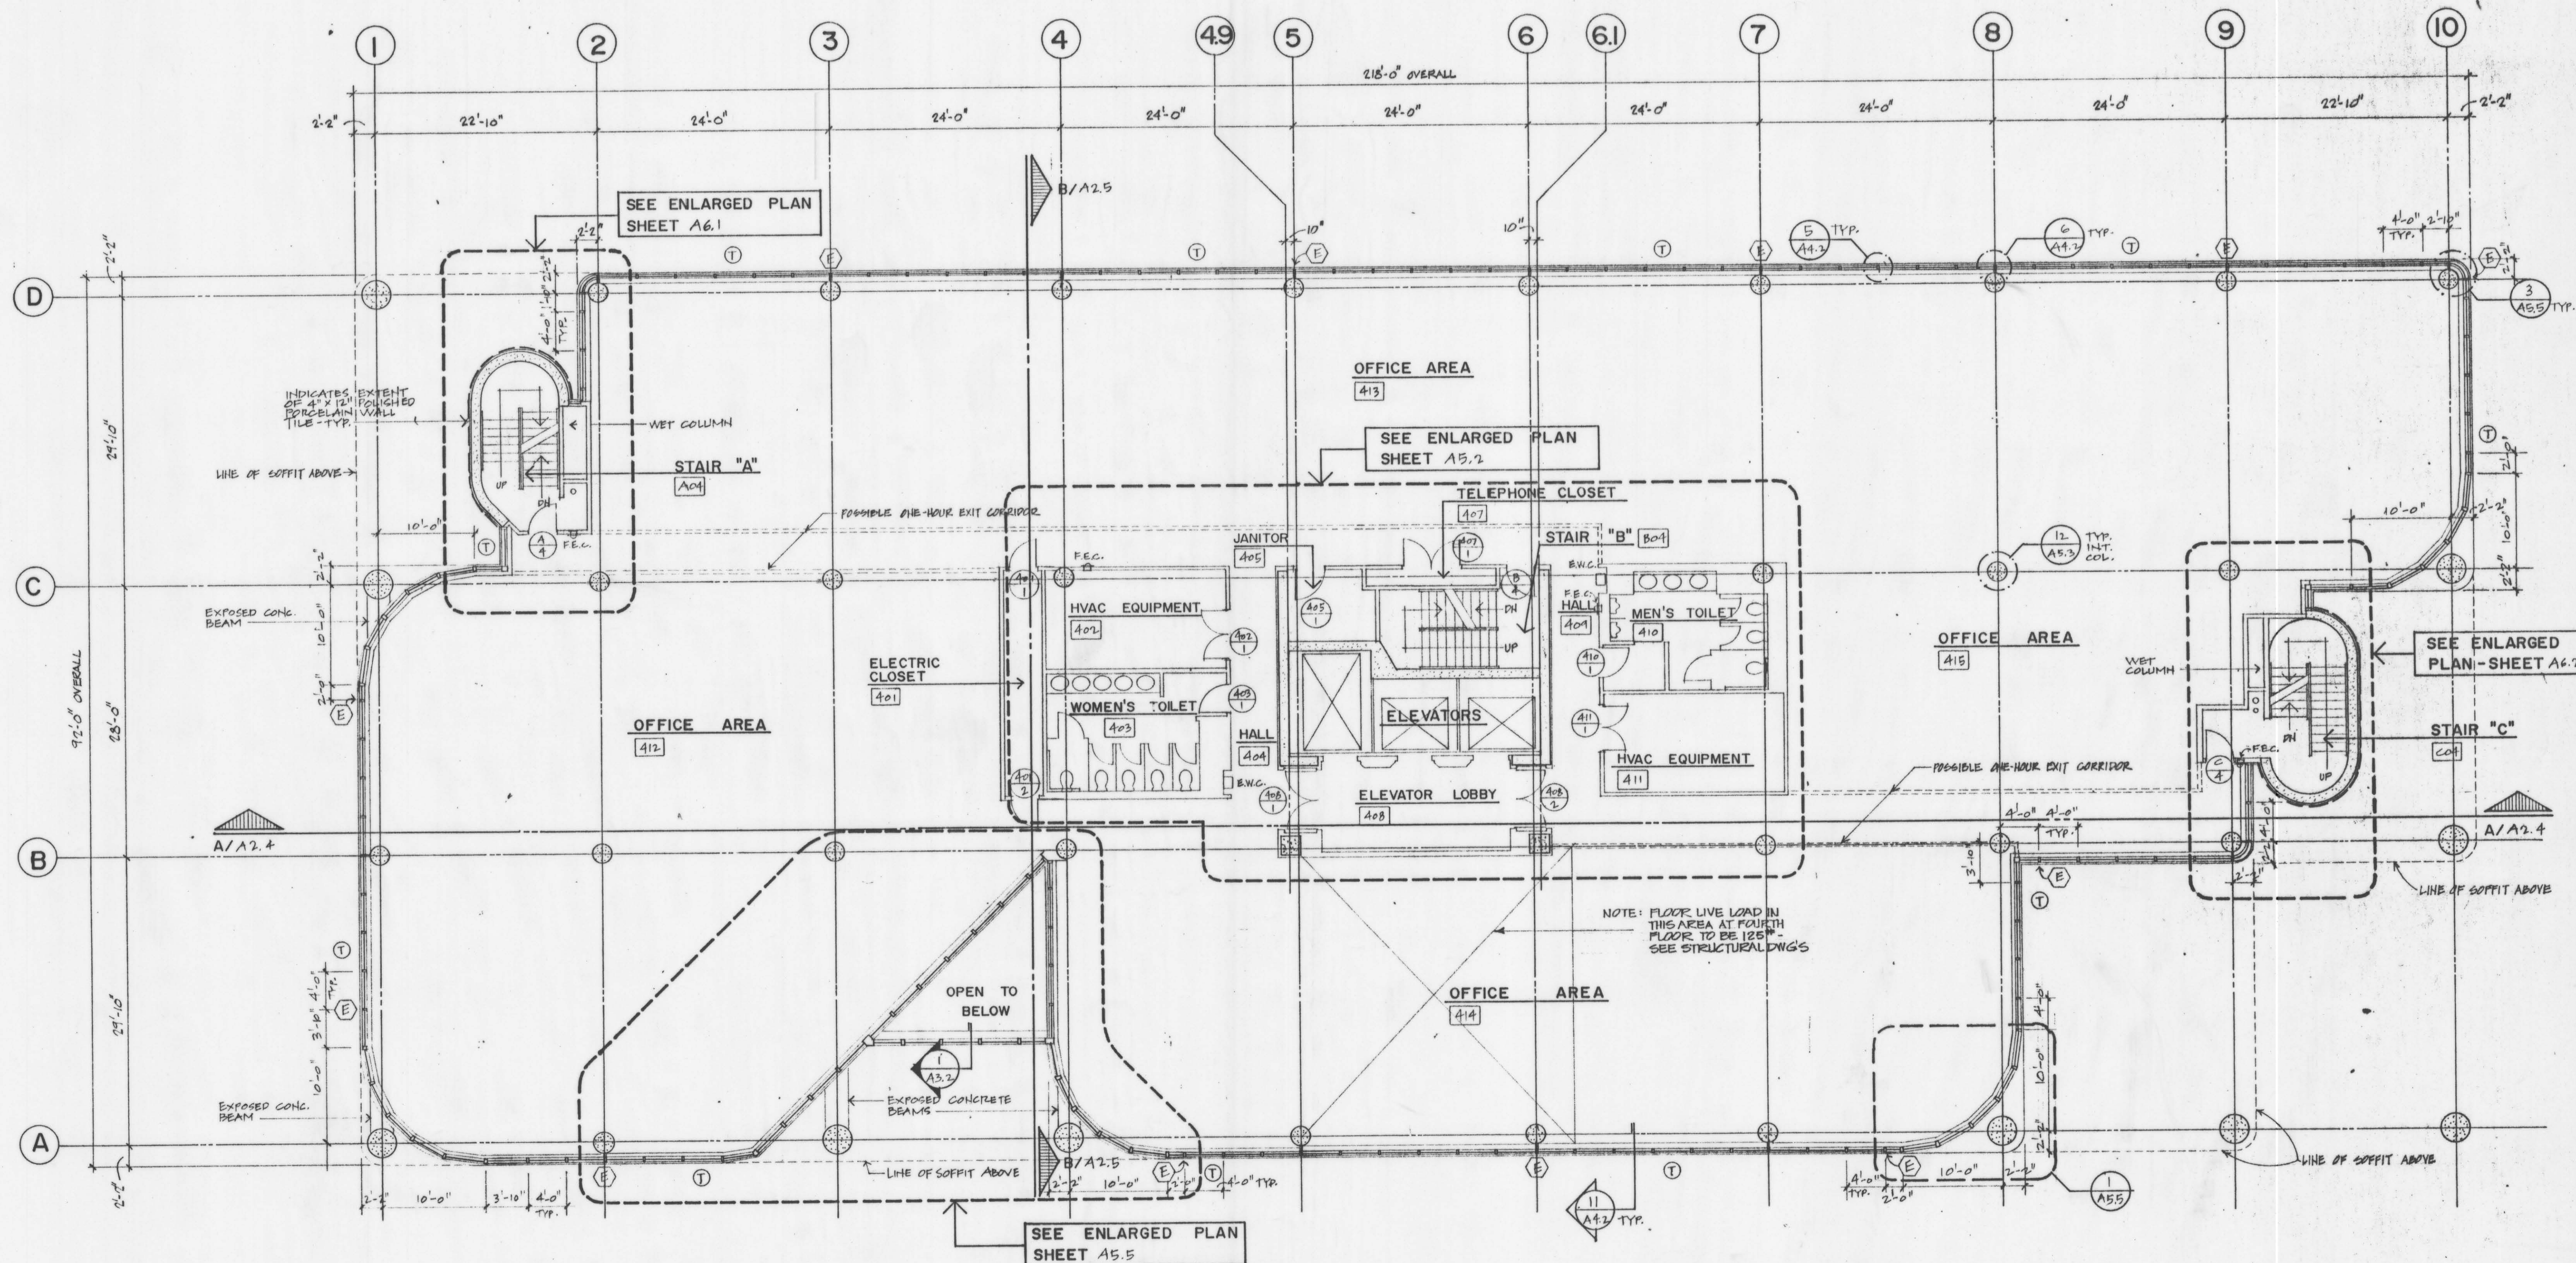

Fourth Floor Plan

1/8" = 1'-0"

FIN. FLR. EL. +37'-0"

(T) DENOTES TEMPERED GLASS PANELS - SEE DET. V/A1.2

(E) DENOTES EXPANSION MULLION. SEE DET. B/A5.5

F.E.C. RECESSED FIRE EXTINGUISHER CABINET

AS BUILT

AGENCY: *[Signature]*
COUNTY: *[Signature]*
DEVELOPER: *[Signature]*

Fourth Floor Plan - Office Building

Manatee County Governmental Complex Bradenton, Florida

The Huntington Group Architects, Inc.
1001 3rd Avenue West Suite 300 Bradenton, Florida 39505 813/746-3595
Williams Trebilcock Whitehead Architects Planners Interior Designers
36 East Pine Street Orlando, Florida 32801 405/423-7862

Drawing No.
A1.4

Date
Issue and construction
number 11/1991
Project No.
6801

4TH FLOOR