
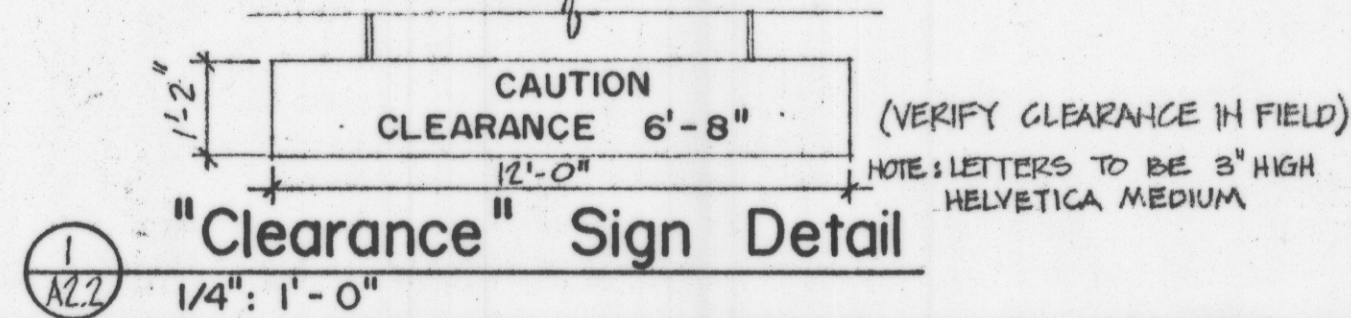
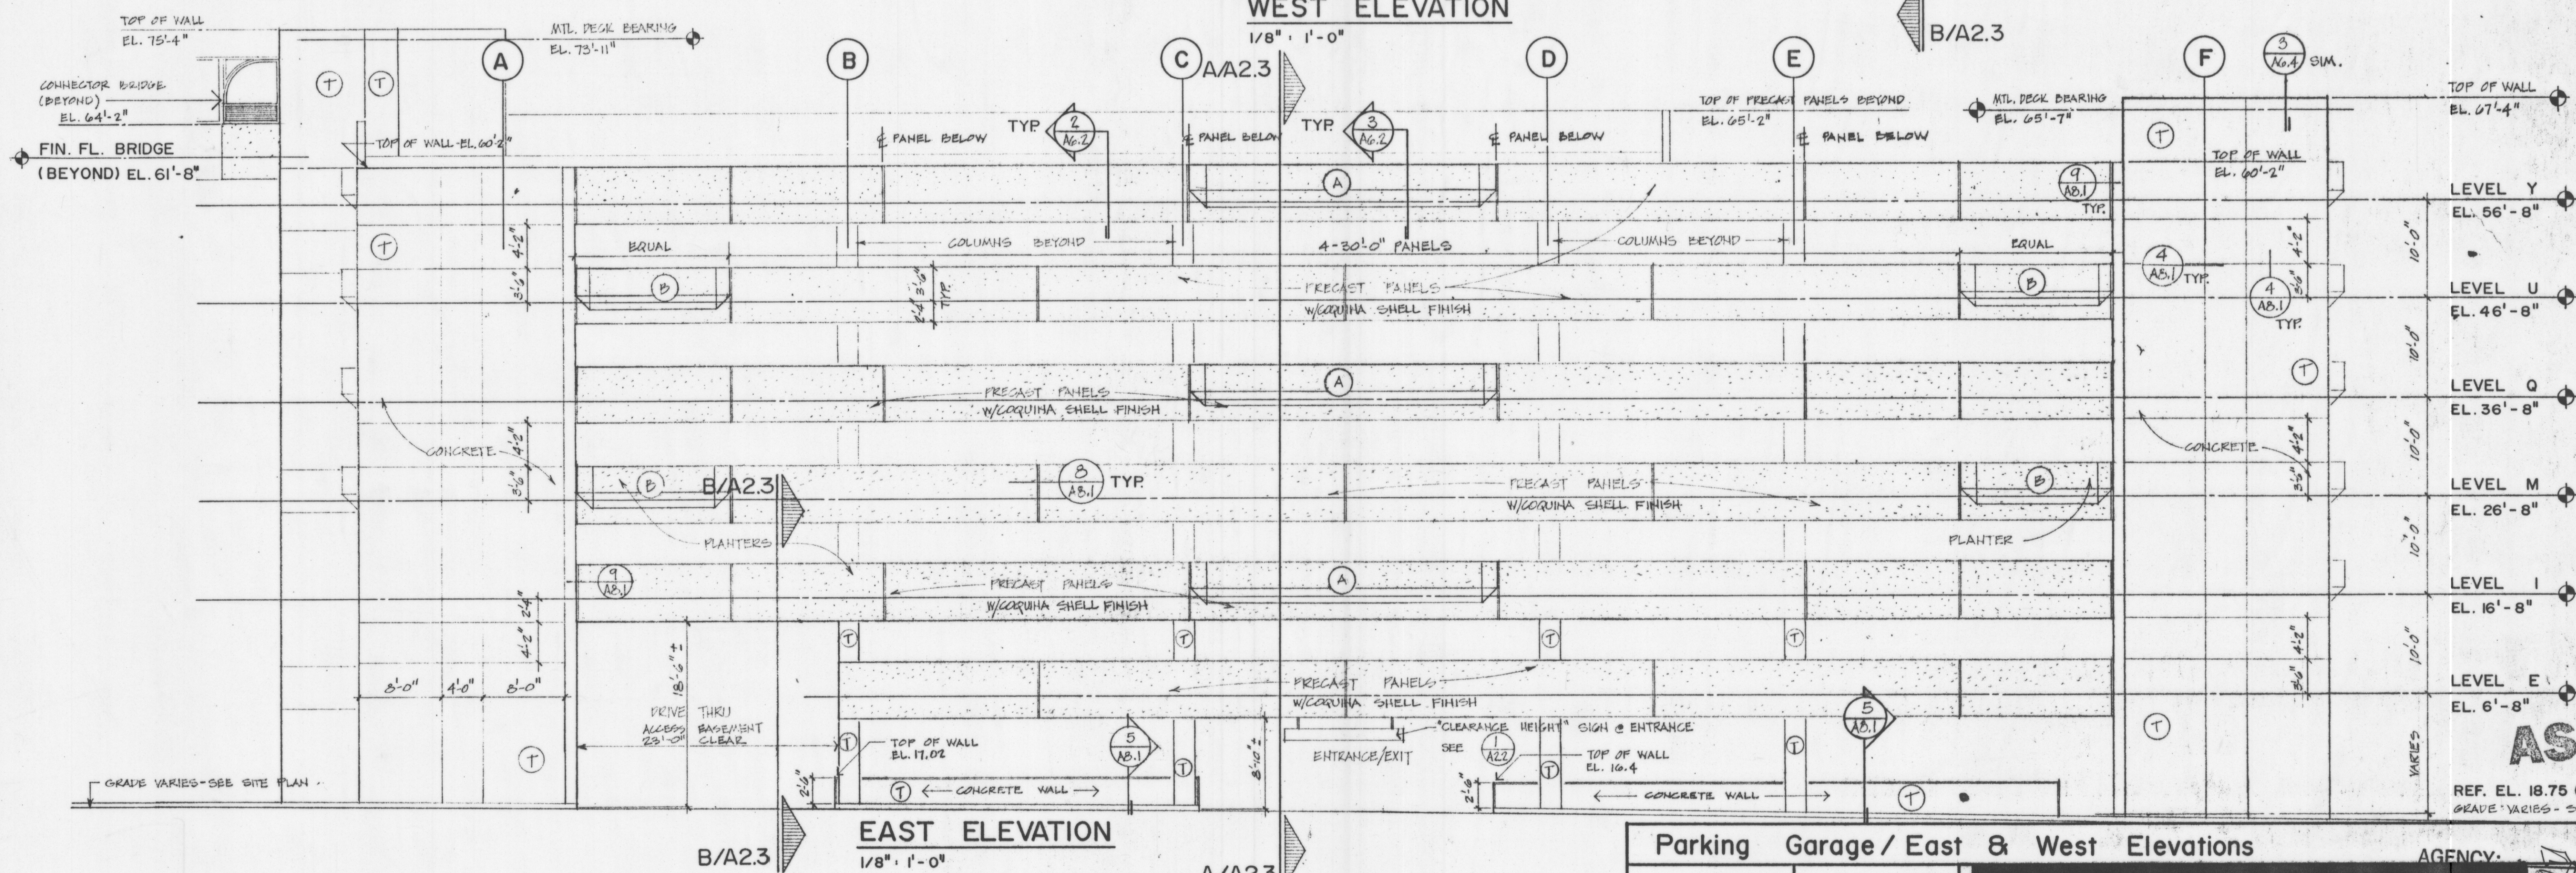


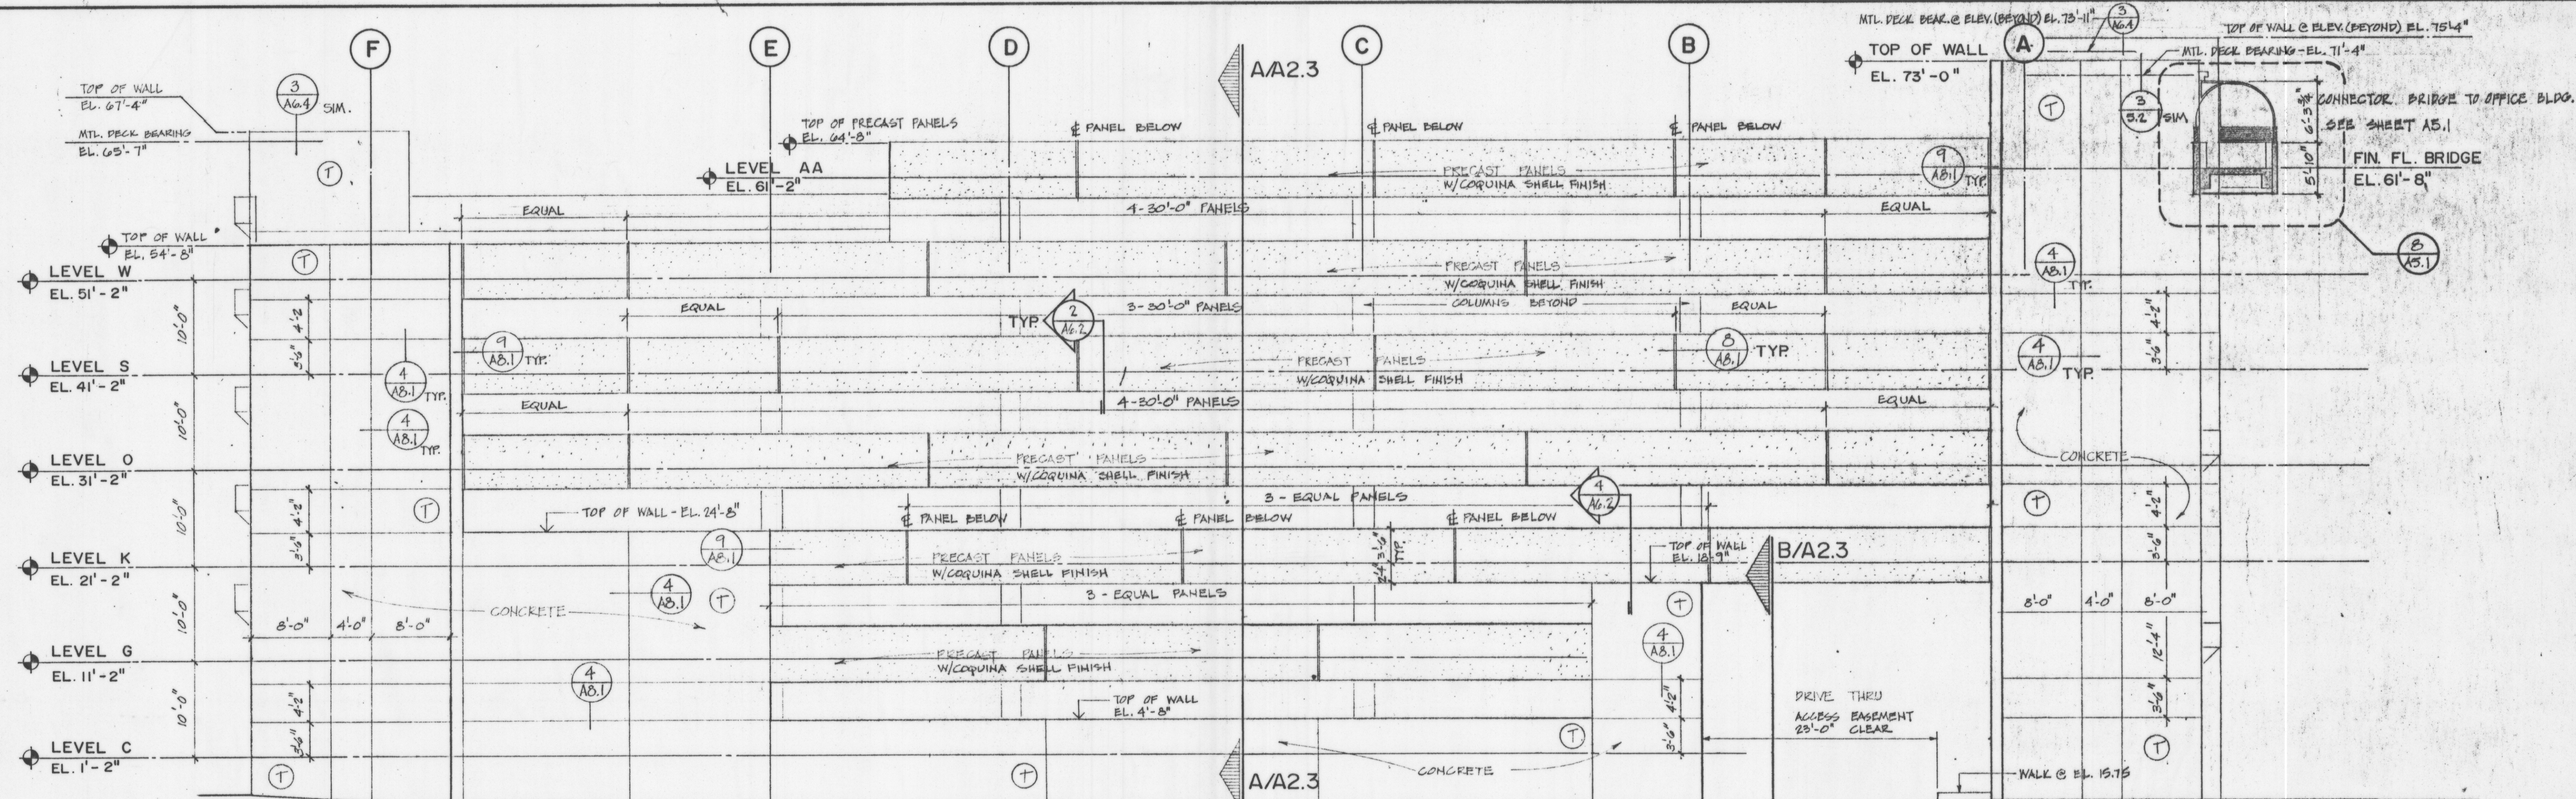

Parking Garage / East & West Elevations

**Manatee County
Governmental Complex**

The Huntington Group Architects, Inc.
1001 3rd Avenue West Suite 300 Bradenton, Florida 33506 813/746-3595
Williams Trebilcock Whitehead Architects Planners Interior Designers
36 East Pine Street Orlando, Florida 32801 805/423-7882

AGENCY:

DEVELOPER:

Drawing No.

A2.2

Date

ISSUED FOR CONSTRUCTION

Project No.

6801

AS BUILT

REF. EL. 18.75 (0'-0")
GRADE VARIES - SEE SITE PLAN