

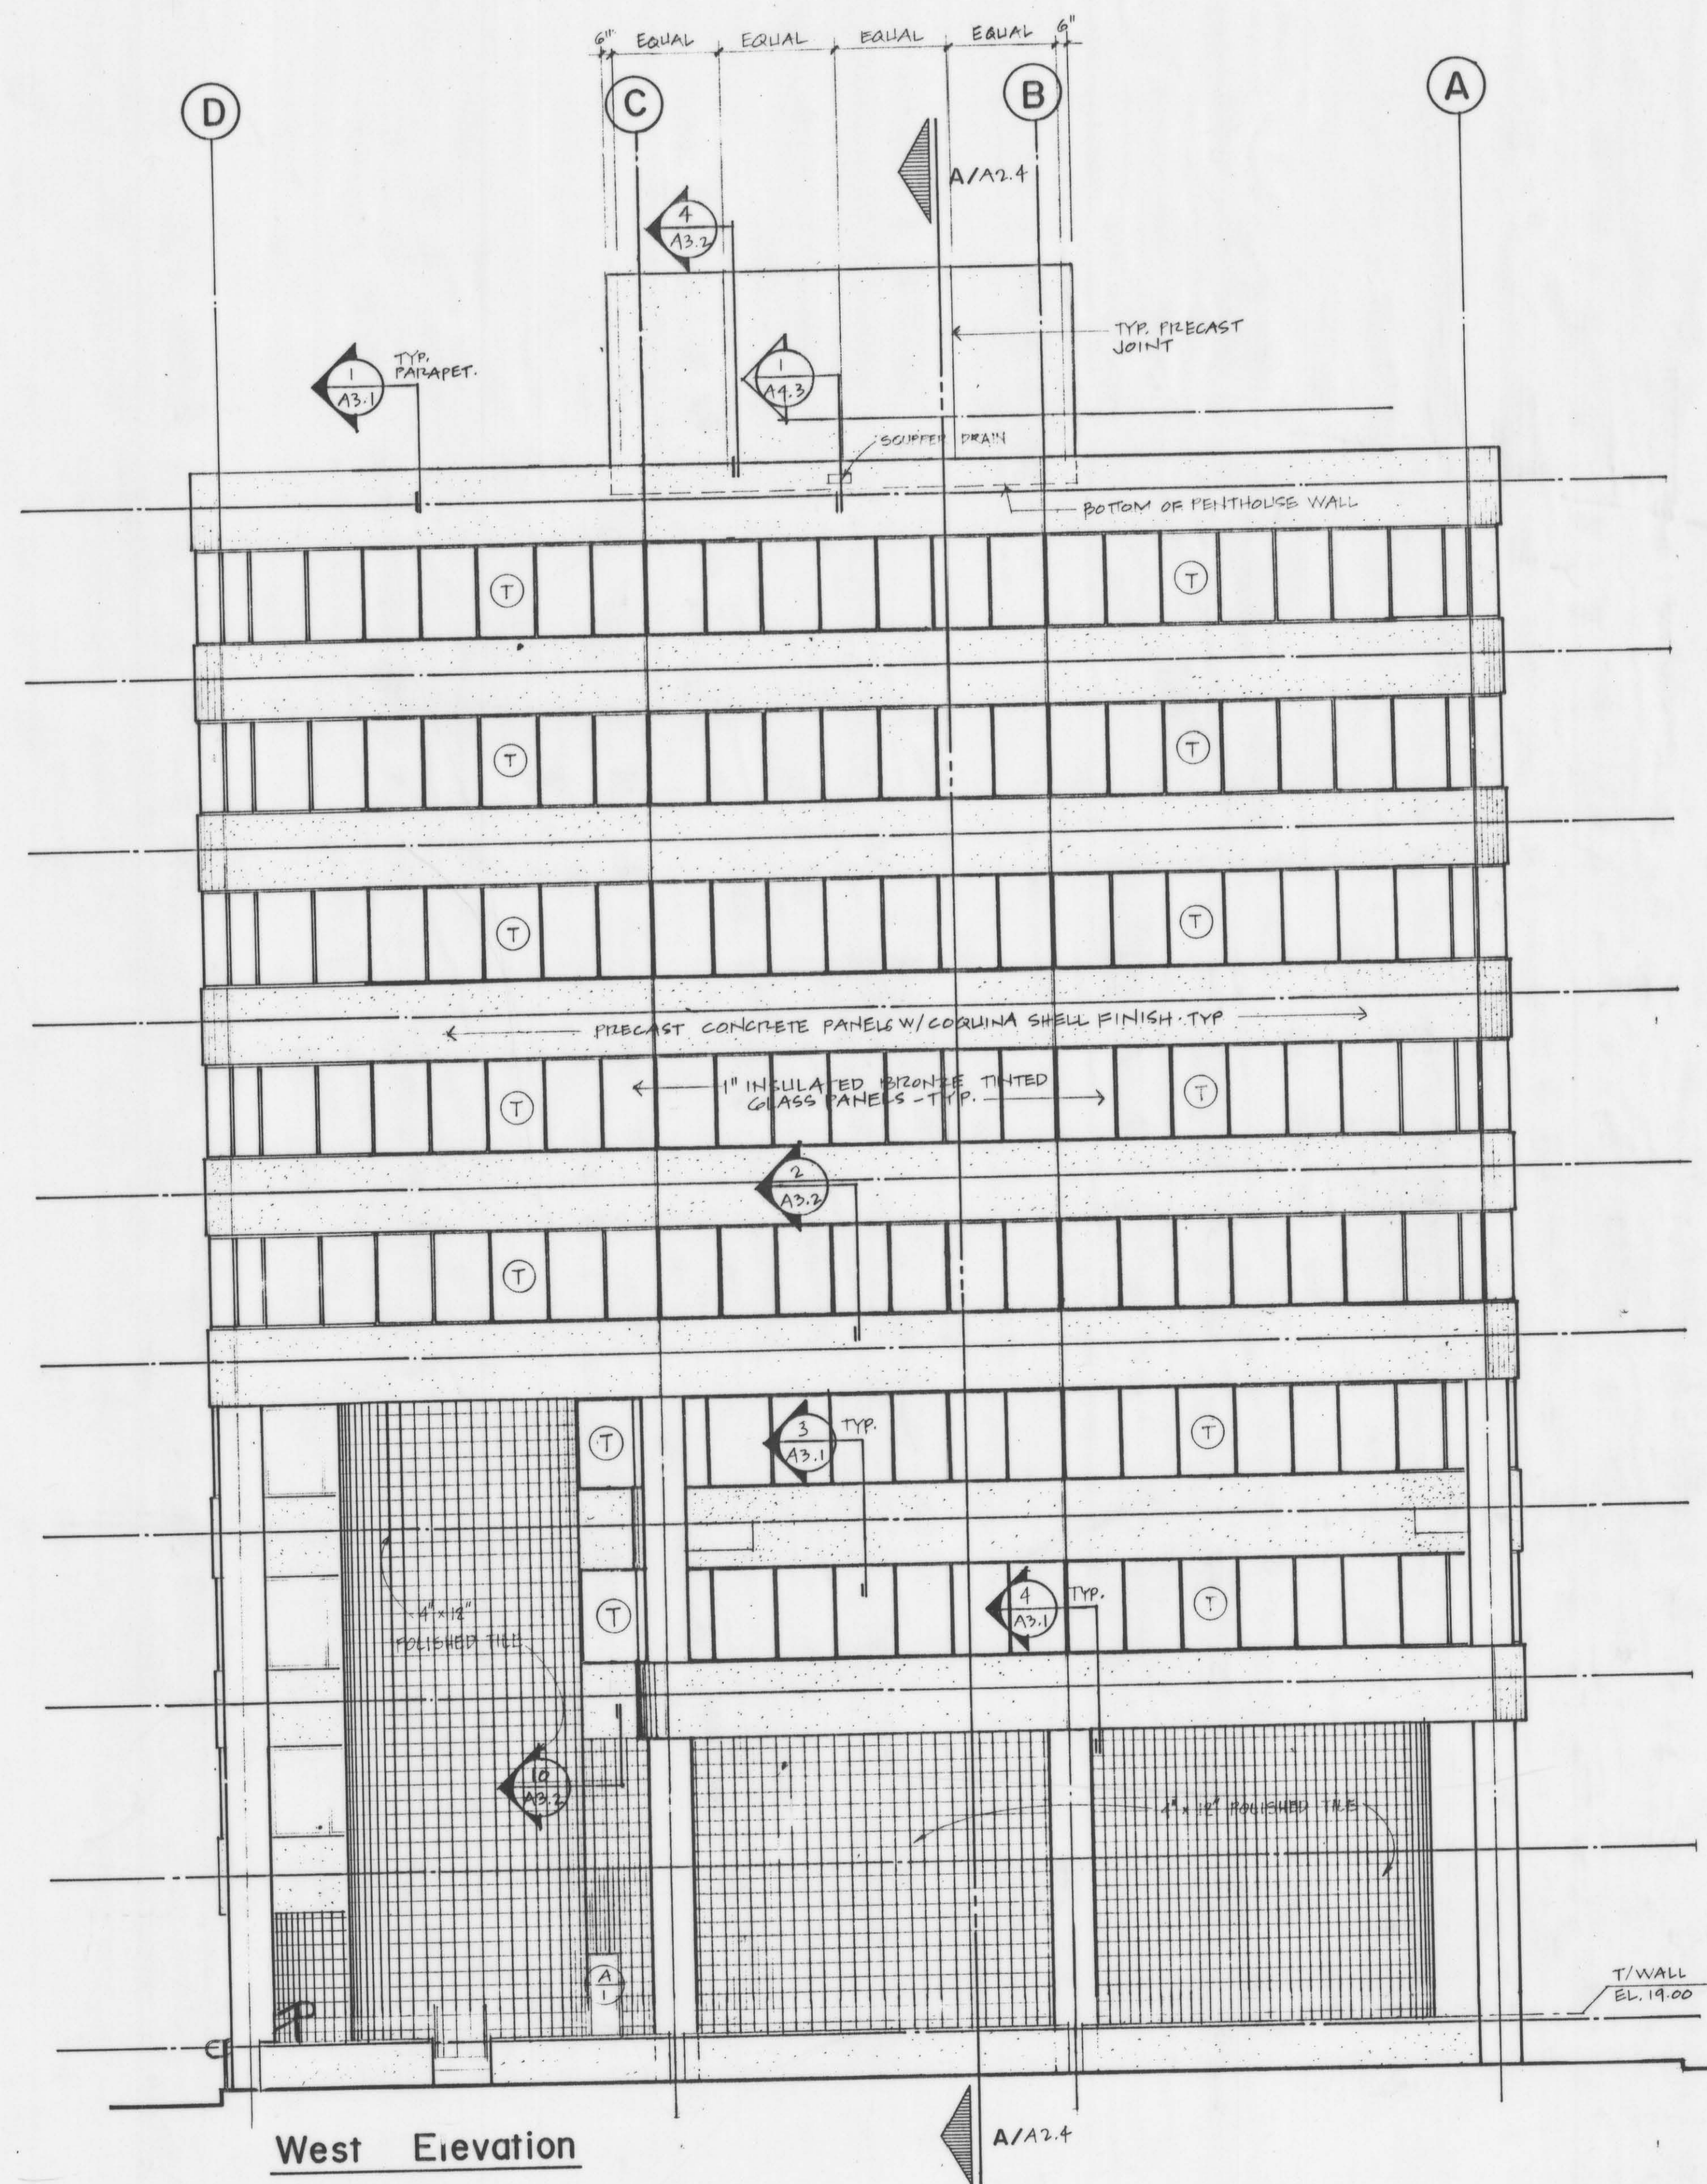


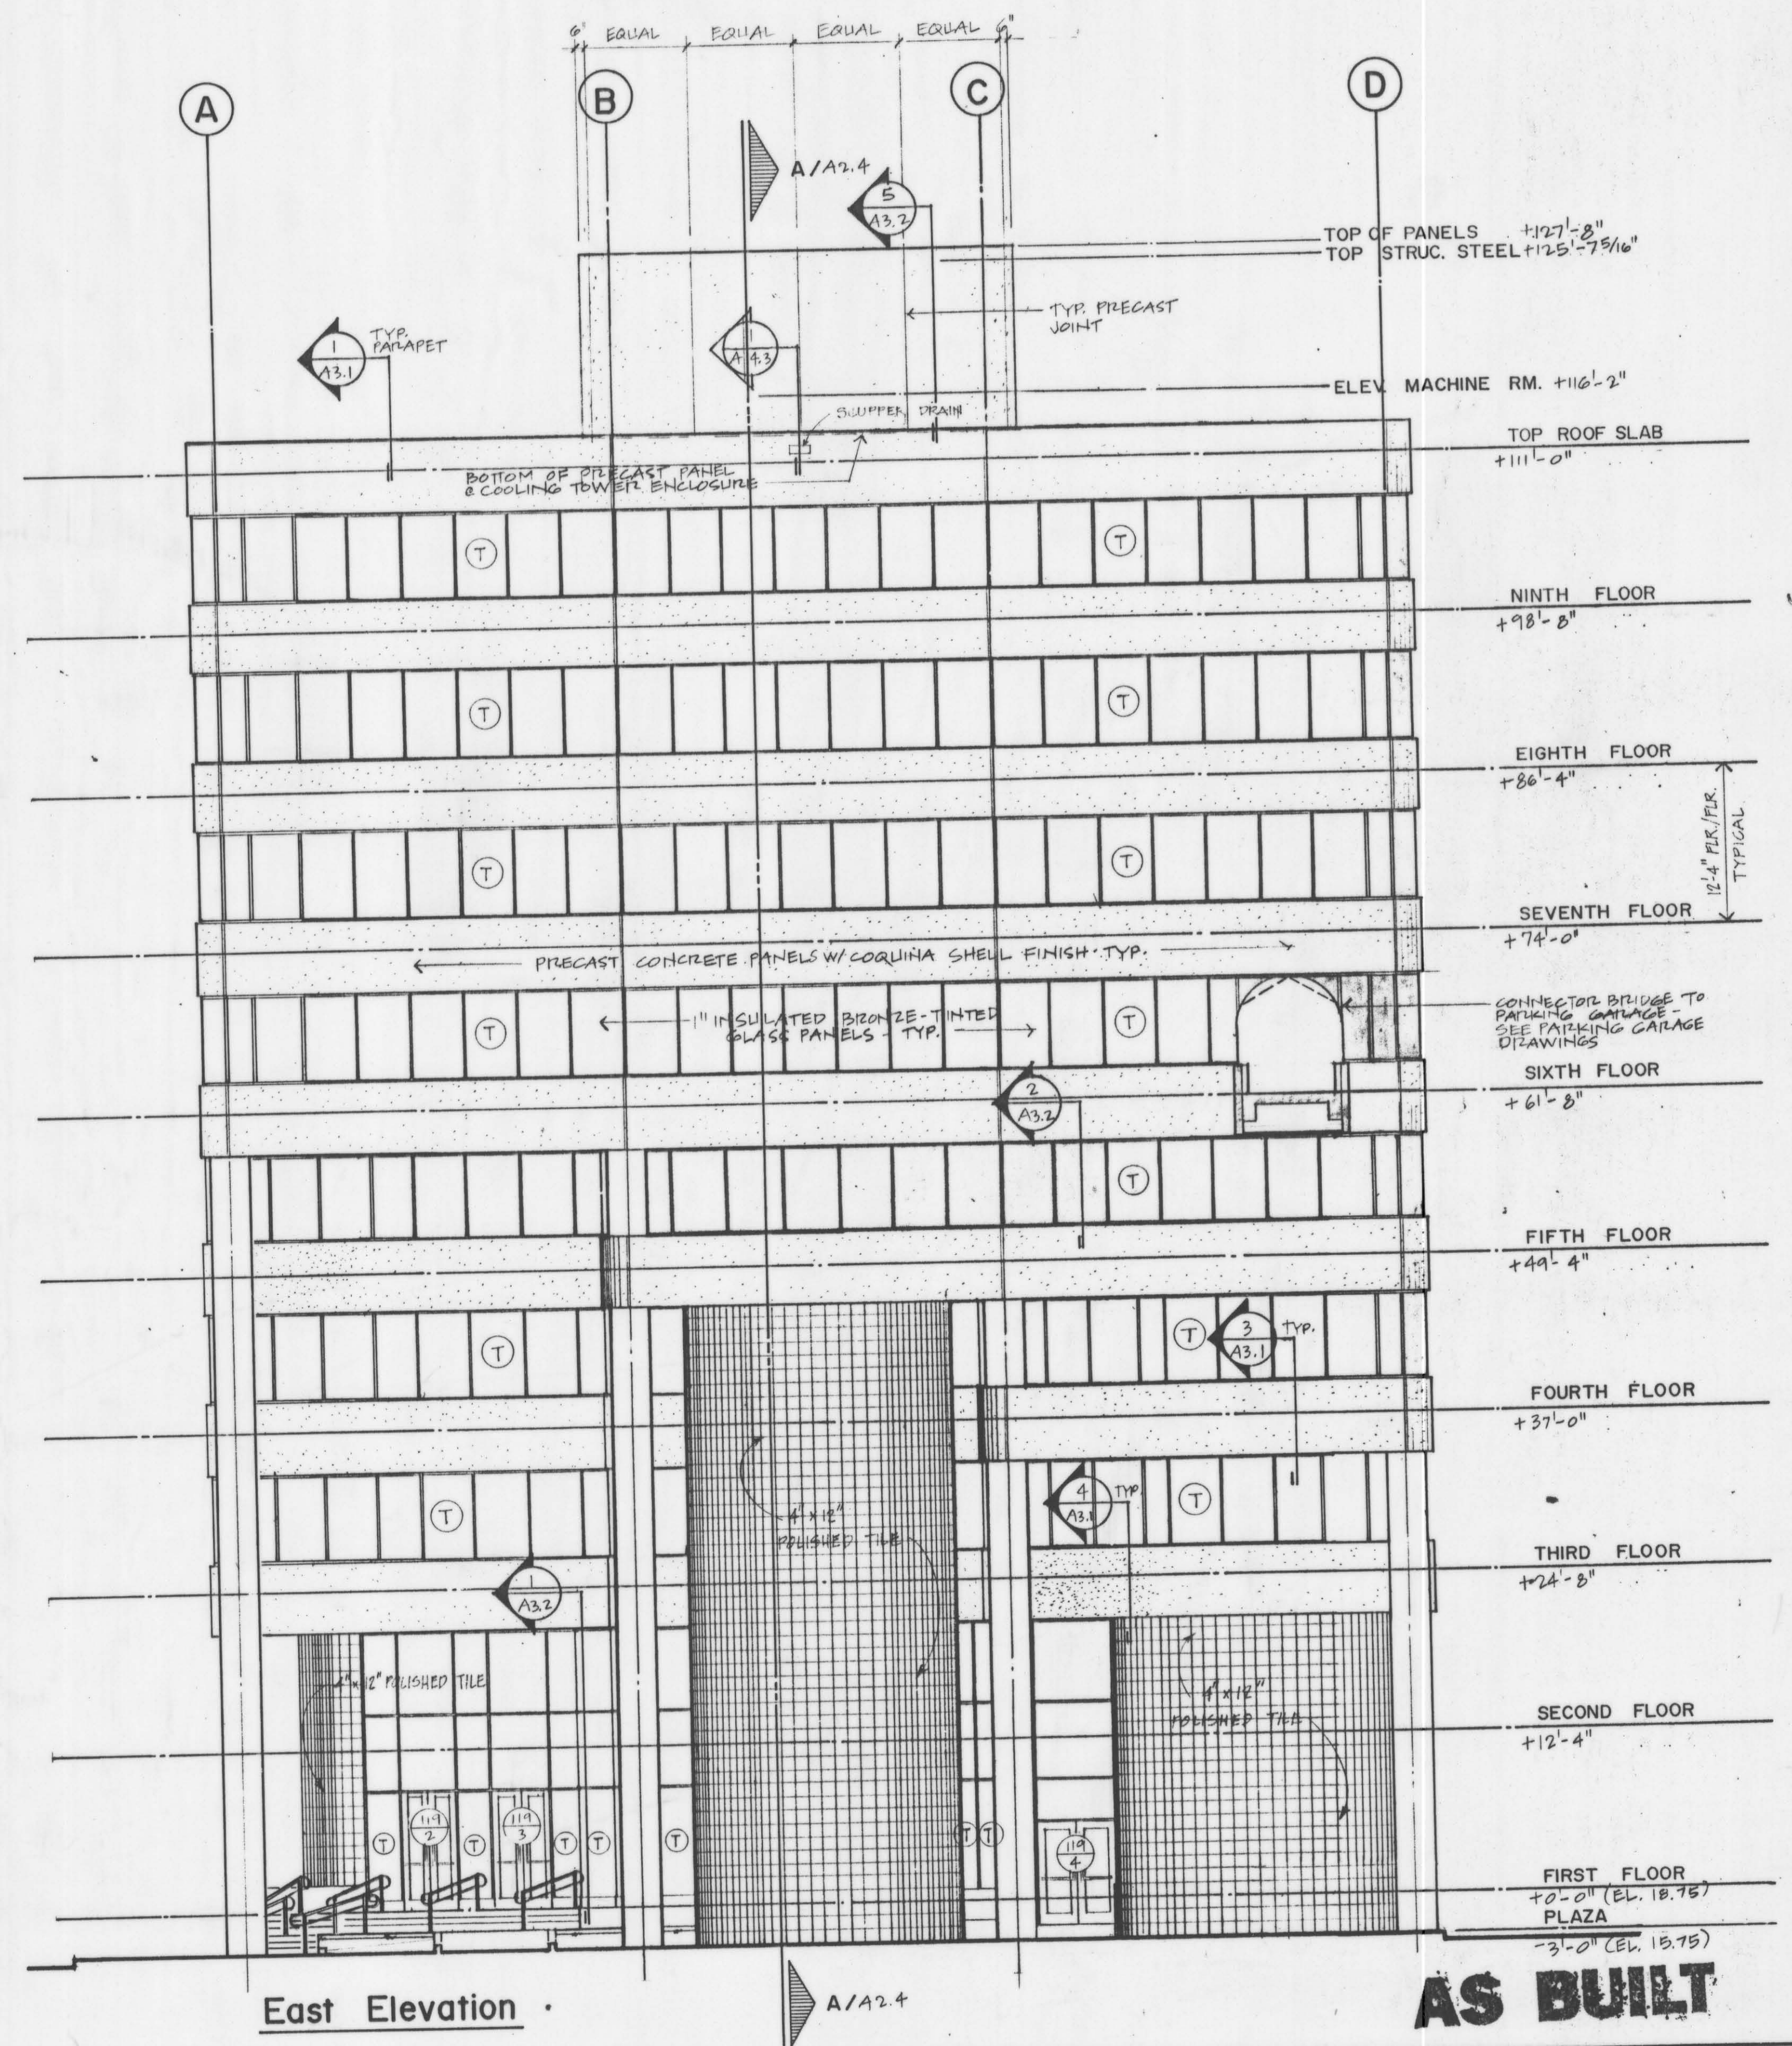

West Elevation

(T) DENOTES TEMPERED GLASS KNOCKOUT PANEL
 [] DENOTES SPANDREL GLASS W/DARK INSULATION BACKING

Exterior Elevations
 1/8" = 1'-0"

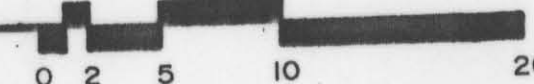

East Elevation

AS BUILT

East - West Elevations

**Manatee County
 Governmental Complex**

The Huntington Group Architects, Inc.
 1001 3rd Avenue West Suite 300 Bradenton, Florida 33505 813/746-3595
Williams Trebilcock Whitehead Architects Planners Interior Designers
 38 East Pine Street Orlando, Florida 32801 305/423-7862

COUNTY: *Manatee*
 DEVELOPER: *Manatee County*

Drawing No. **A2.3**
 Date ISSUED FOR CONSTRUCTION October 18, 1987
 Project No. 6801