


MATCH LINE
SEE SHEET 2 OF 8

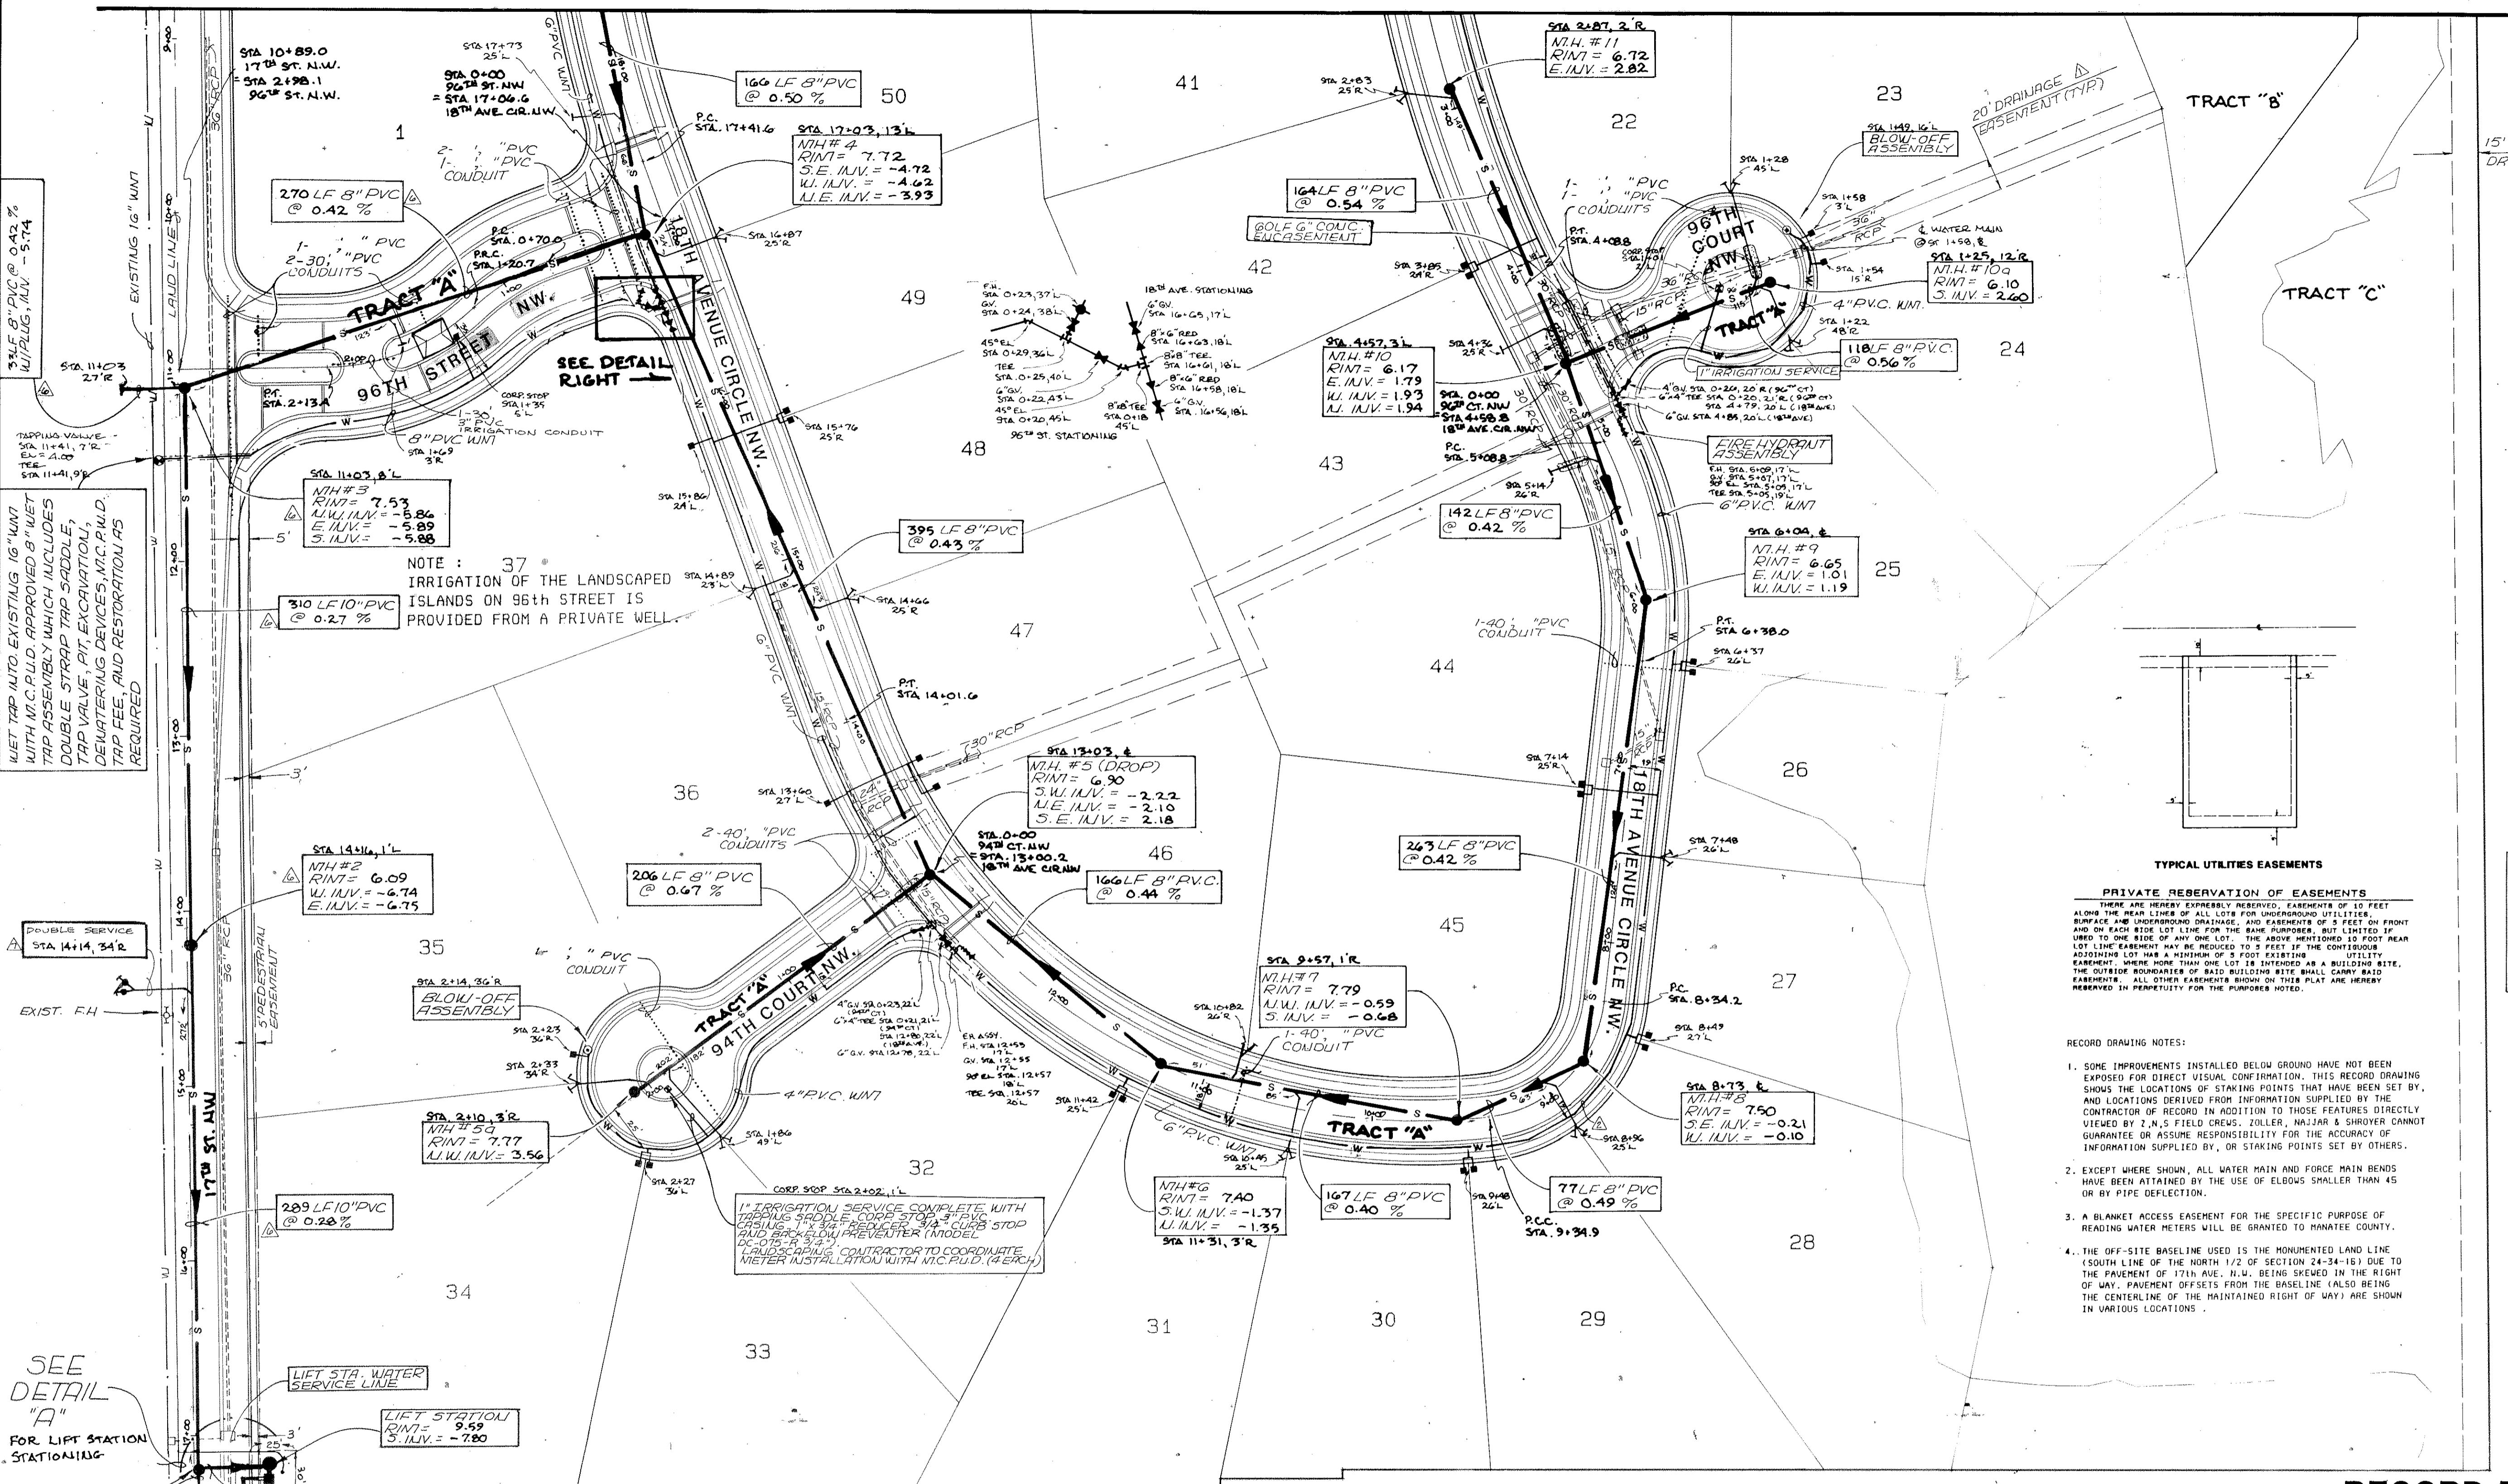

RECORD DRAWING


OF SEWER & WATER PLAN FOR THE LOOP

LOCATED IN:

SEC. 24, TWP. 34 S., RGE. 16 E.⁺

MANATEE COUNTY, FLORIDA

NOTE: TRACT "A", RESERVED FOR THE PURPOSES OF INGRESS-EGRESS, UTILITIES AND PRIVATE DRAINAGE, IS TO BE OWNED AND MAINTAINED BY "THE LOOP HOMEOWNER'S ASSOCIATION, INC.". THE DEPICTION UPON THIS RECORD DRAWING OF THE AREA WITHIN TRACT "A" IS IN NO WAY TO BE CONSTRUED AS A DEDICATION OF THE PRIVATE STREET AND UTILITIES WITHIN TRACT "A" TO THE GENERAL PUBLIC OR MANATEE COUNTY FOR THE PURPOSES OF OWNERSHIP, IMPROVEMENT OR MAINTENANCE.

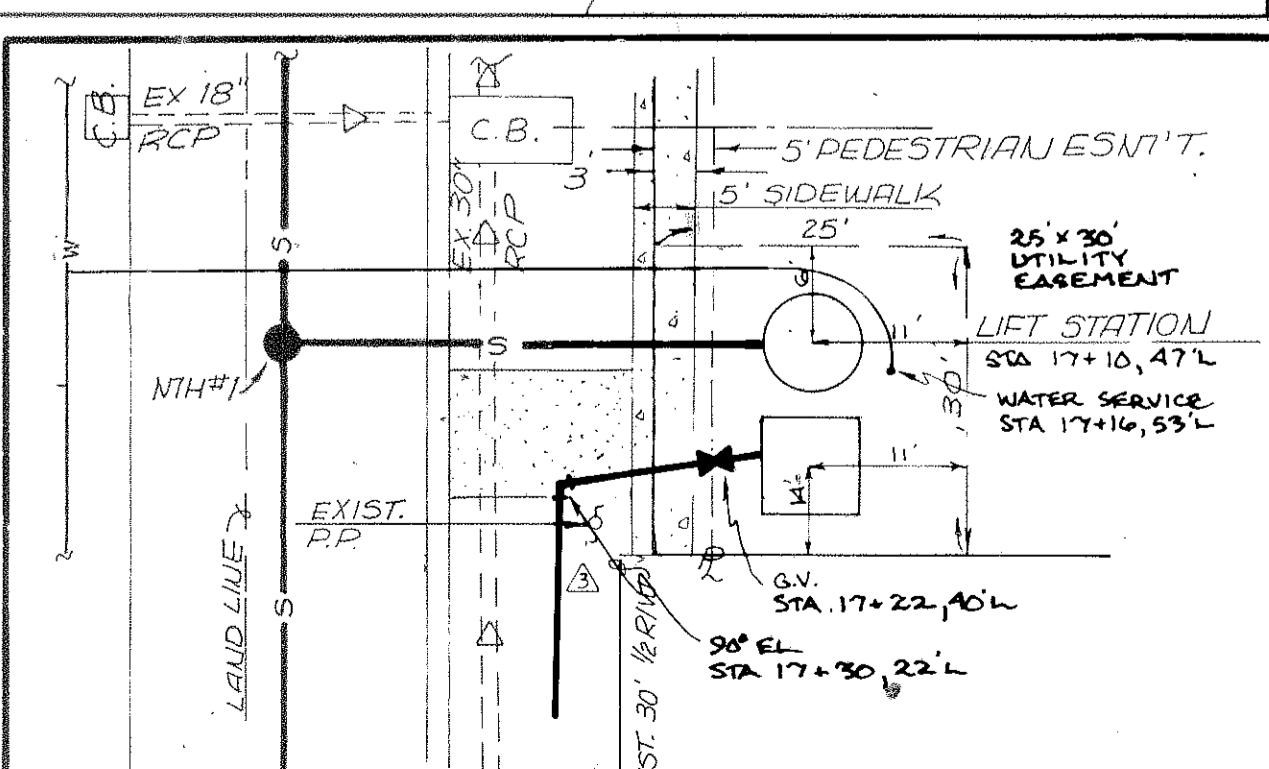


I HEREBY CERTIFY THAT THE RECORD DRAWINGS OF THE UTILITIES SHOWN, SUPERIMPOSED UPON THE DESIGN CONSTRUCTION PLANS, IS TO THE BEST OF MY KNOWLEDGE, INFORMATION AND BELIEF, A TRUE AND CORRECT REPRESENTATION OF THE IMPROVEMENTS AS SHOWN.
ZOLLER, NAJJAR & SHROYER, INC. P.O. BOX 9448 BRADENTON, FLORIDA 34206
DATE OF FIELD WORK : 12-20-4-91 DATE OF CERTIFICATION:
JAMES N. GATCH, JR. PLS. #2295
DATE OF FIELD WORK : 12-20-4-91 DATE OF CERTIFICATION:

REVISIONS
1. DRAWDRAWN EASEMENTS 2. ADDED PER REVIEW 3. REVISERED 4. NOTE #1 5. P.D. FRAMES, MM. 6. REVISED 7. DRAWDRAWN EASEMENT 8. RECORD DRAWING 9. FINAL SUBJ TO REV PER MAPD
10/17/90 10/25/90 10/31/90 11/14/90 TSP 5-8-91 5-14-91

Zoller, Najjar & Shroyer, Inc. Engineers, Planners, Surveyors & Landscape Architects
201 5TH AVENUE DRIVE EAST POST OFFICE BOX 9448 FAX (813) 748-3316 BRADENTON FLORIDA 34206 TELEPHONE (813) 748-8306
DESIGNED BY MSD CHECKED BY MAY 1990 SCALE 1"=50' DRAWN BY JT COMP. - JOB NO. 758-11617 FILE NO. 10640 SHEET 1 OF 8

T 233

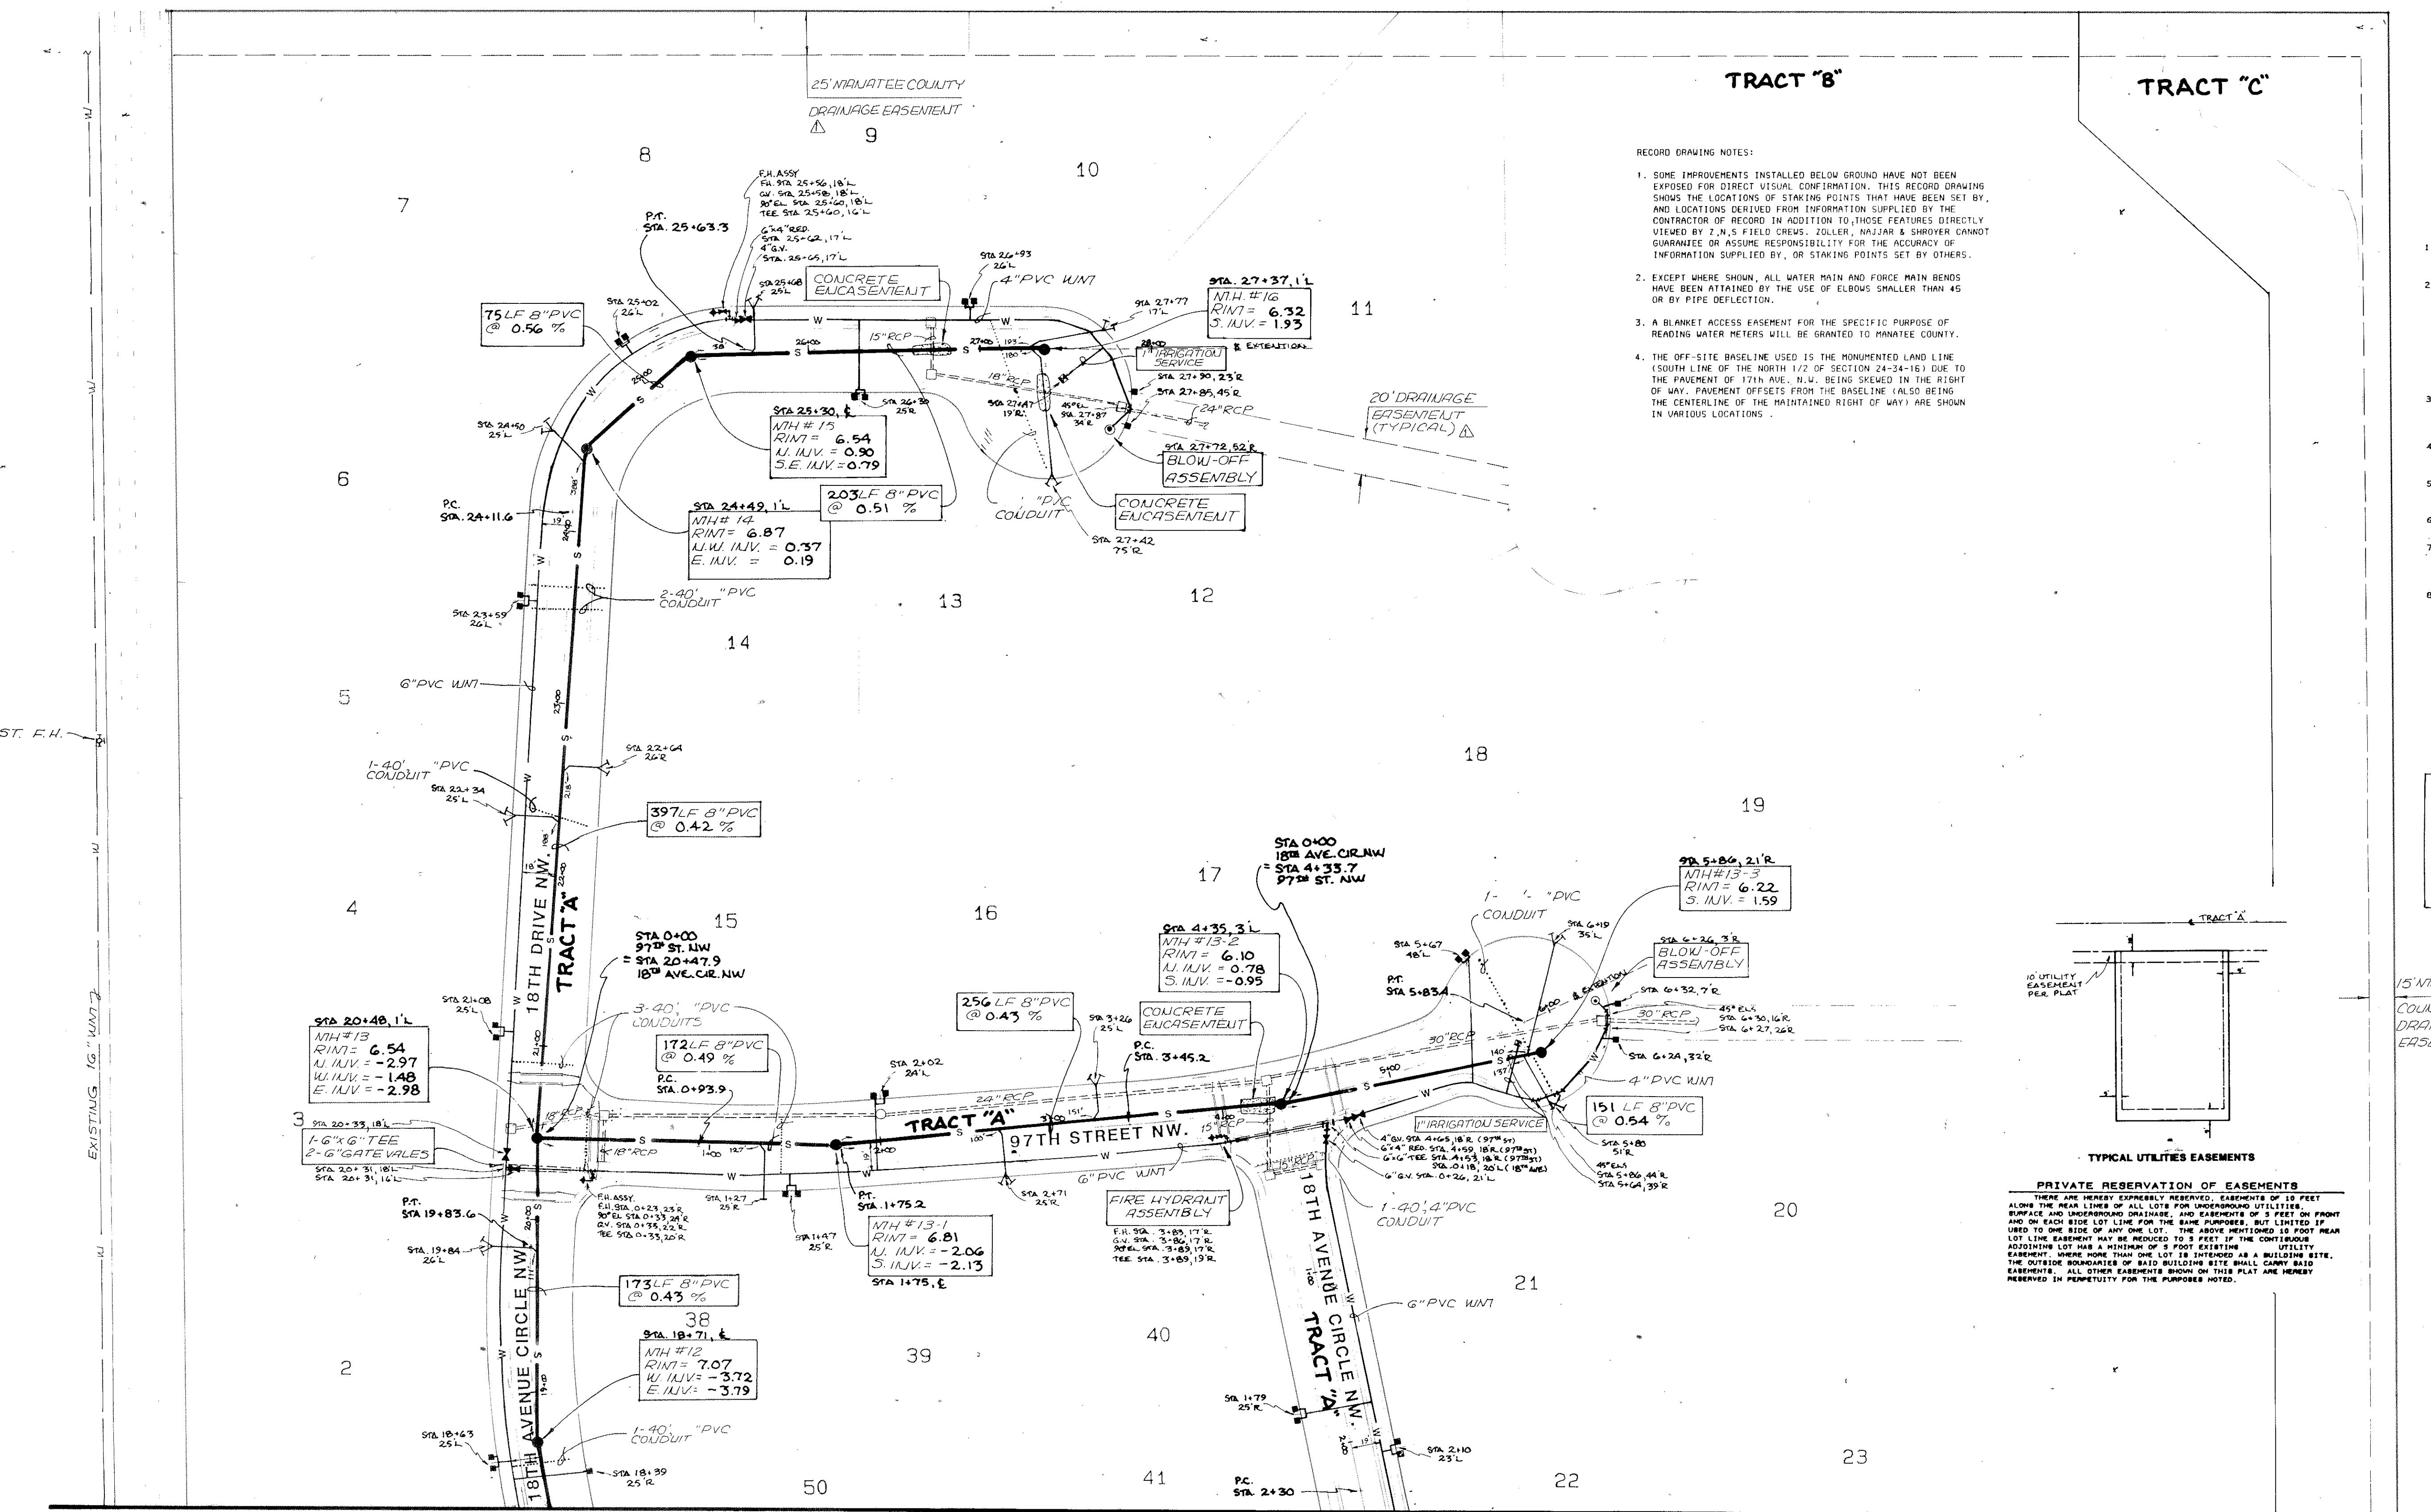

MATCH LINE
SEE SHEET 1 OF 8

NOTE : TRACT "A", RESERVED FOR THE PURPOSES OF INGRESS-EGRESS, UTILITIES AND PRIVATE DRAINAGE, IS TO BE OWNED AND MAINTAINED BY "THE LOOP HOMEOWNER'S ASSOCIATION, INC.". THE DEPICTION UPON THIS RECORD DRAWING OF THE AREA WITHIN TRACT "A" IS IN NO WAY TO BE CONSTRUED AS A DEDICATION OF THE PRIVATE STREET AND UTILITIES WITHIN TRACT "A" TO THE GENERAL PUBLIC OR MANATEE COUNTY FOR THE PURPOSES OF OWNERSHIP, IMPROVEMENT OR MAINTENANCE.

I HEREBY CERTIFY THAT THE RECORD DRAWINGS OF THE UTILITIES SHOWN, SUPERIMPOSED UPON THE DESIGN CONSTRUCTION PLANS, IS TO THE BEST OF MY KNOWLEDGE, INFORMATION AND BELIEF, A TRUE AND CORRECT REPRESENTATION OF THE IMPROVEMENTS AS SHOWN.

ZOLLER, NAJJAR & SHROYER, INC.
P.O. BOX 9448
BRADENTON, FLORIDA 34206

JAMES N. GATCH, JR. PL. #4295
DATE OF FIELD WORK : 12-26-4-91 DATE OF CERTIFICATION:

REVISIONS	
DRAINS EASEMENT	ADDED 7-9-90
1	REVISED 10-1-90
2	REVISED 10-1-90
3	PED RAMPS MOD. 10/26/90
4	RECORD DRAWING TOP 5-18-91
5	FINAL SURV. W/R/REV 5-14-91
6	PER MCMPD
7	

Zoller, Najjar & Shroyer, Inc.
Engineers, Planners, Surveyors & Landscape Architects


2015H AVENUE DRIVE EAST
POST OFFICE BOX 9448

FAX (813) 748-3316
BRADENTON, FLORIDA 34206
TELEPHONE (813) 748-8980

DESIGNED WT CHECKED MSD DATE MAY 1990 SCALE 1"=50'
DRAWN JT COMP - JOB NO. 758-1617 FILE NO. 10640 SHEET 2 OF 8

- WATER & SEWER CONSTRUCTION NOTES
- All proposed improvements to the site to be staked in the field by or under the supervision of a Florida Registered Land Surveyor.
 - The Contractor is responsible for coordinating and contracting for the production of reproducible record drawings with the Engineer. The Contractor shall have obtained all necessary field data required for the production of record drawings. Record Drawings must meet the requirements of Manatee County Public Works Department minimum technical standards (Rev. #3). The Record Drawings are to be performed and certified by the Engineer of Record for the Contractor.
 - All proposed construction is to meet or exceed latest applicable Manatee County Construction standards and is to be dedicated for public private use of the development. Non-deedable Construction.
 - The Contractor is to coordinate the location and elevation of all FPL, GIE and Irrigation service sleeves with respective agency prior to construction.
 - The Contractor is to assure himself that all underground utilities and storm sewer is constructed, tested and operational prior to any roadway construction.
 - All proposed electrical and communication services are to be located underground as directed by respective agency.
 - Watermain \rightarrow PIGMENTATED COLOR BLUE. Water services where located under pavement to be encased in Class 160, SDR-26.(3" min.)
 - All utilities and/or drainage shown as existing are to be field verified. For any new and/or elevation prior to construction, Contractor to notify "CANDY" 48 hours prior to start of construction for possible utility locations not shown.

NOTE:
CONDUIT LOCATIONS AND SIZES AS SHOWN ARE FOR ALLOCATION PURPOSES. ACTUAL SIZES AND LOCATIONS TO BE DETERMINED BY INTERESTED PARTIES DURING THE PRE-CONSTRUCTION CONFERENCE.

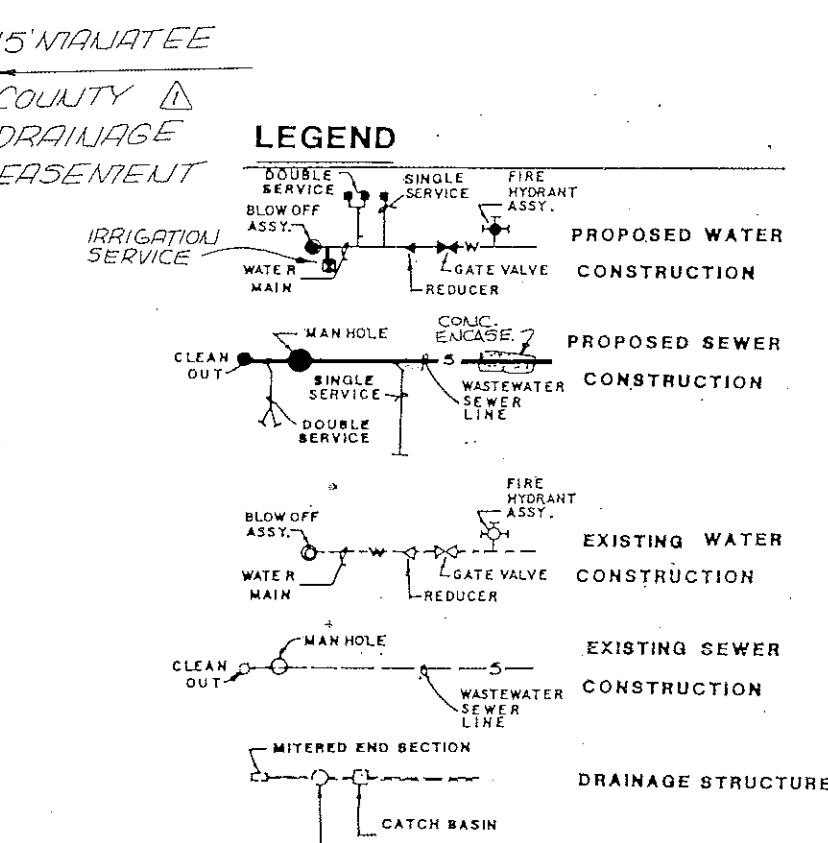

RECORD DRAWING OF SEWER & WATER PLAN FOR THE LOOP

LOCATED IN:
SEC. 24, TWP. 34 S., RGE. 16 E.
MANATEE COUNTY, FLORIDA

T 234

RECORD DRAWING NOTES:

- SOME IMPROVEMENTS INSTALLED BELOW GROUND HAVE NOT BEEN EXPOSED FOR DIRECT VISUAL CONFIRMATION. THIS RECORD DRAWING SHOWS THE LOCATIONS OF STAKING POINTS THAT HAVE BEEN SET BY, AND LOCATIONS DERIVED FROM INFORMATION SUPPLIED BY THE CONTRACTOR FOR USE IN DETERMINING THE EXACT LOCATION AS IT IS VIEWED ON A L.S. FIELD DRAWING. ZOLLER, NAJJAR & SHROYER CANNOT GUARANTEE OR ASSUME RESPONSIBILITY FOR THE ACCURACY OF INFORMATION SUPPLIED BY, OR STAKING POINTS SET BY OTHERS.
- EXCEPT WHERE SHOWN, ALL WATER MAIN AND FORCE MAIN BENDS HAVE BEEN ATTAINED BY THE USE OF ELBOWS SMALLER THAN 45 OR BY PIPE DEFLECTION.
- THE FORCE MAIN CONSISTS OF 3,653 LINEAR FEET OF 4" PVC.
- THE OFF-SITE BASELINE USED IS THE MONUMENTED LAND LINE (SOUTH LINE OF THE NORTH 1/2 OF SECTION 24-34-16) DUE TO THE PAVEMENT OF 17th AVE. N.W. BEING SKEWED IN THE RIGHT OF WAY. PAVEMENT OFFSETS FROM THE BASELINE (ALSO BEING THE CENTERLINE OF THE MAINTAINED RIGHT OF WAY) ARE SHOWN IN VARIOUS LOCATIONS.

I HEREBY CERTIFY THAT THE RECORD DRAWINGS OF THE UTILITIES SHOWN SUPERIMPOSED UPON THE DESIGN CONSTRUCTION PLANS, IS TO THE BEST OF MY KNOWLEDGE, INFORMATION AND BELIEF, A TRUE AND CORRECT REPRESENTATION OF THE IMPROVEMENTS AS SHOWN.

ZOLLER, NAJJAR & SHROYER, INC.
P.O. BOX 9448
BRADENTON, FLORIDA 34206

JAMES N. BATCHEL, JR. P.L.S. #4295
DATE OF FIELD WORK: 12-90 - 4-91 DATE OF CERTIFICATION:

REVISIONS
GUARD RAIL ADDED PER M.C. REVIEW 7/9/90
2 RECORD DRAWING 5-8-91
FINAL SUBM. W/ REV 5-14-91
3 PER MCPWD

4
5
6
7

Zoller, Najjar & Shroyer, Inc.
Engineers, Planners, Surveyors & Landscape Architects

BRADENTON, FLORIDA 34206
2015 AVENUE DRIVE EAST
POST OFFICE BOX 9448
FAX (813) 748-3316
TELEPHONE (813) 748-8006

DESIGNED BY CHECKED BY DATE MAY 1990 SCALE AS SHOWN
DRAWN BY COMP. BY JOB NO. 750-11617 FILE NO. 10640 SHEET 3 OF 8

RECORD DRAWING

OF


17TH AVENUE NW.

PLAN

FOR THE LOOP

LOCATED IN:


SEC. 24, TWP. 34 S., RGE. 16 E.
MANATEE COUNTY, FLORIDA

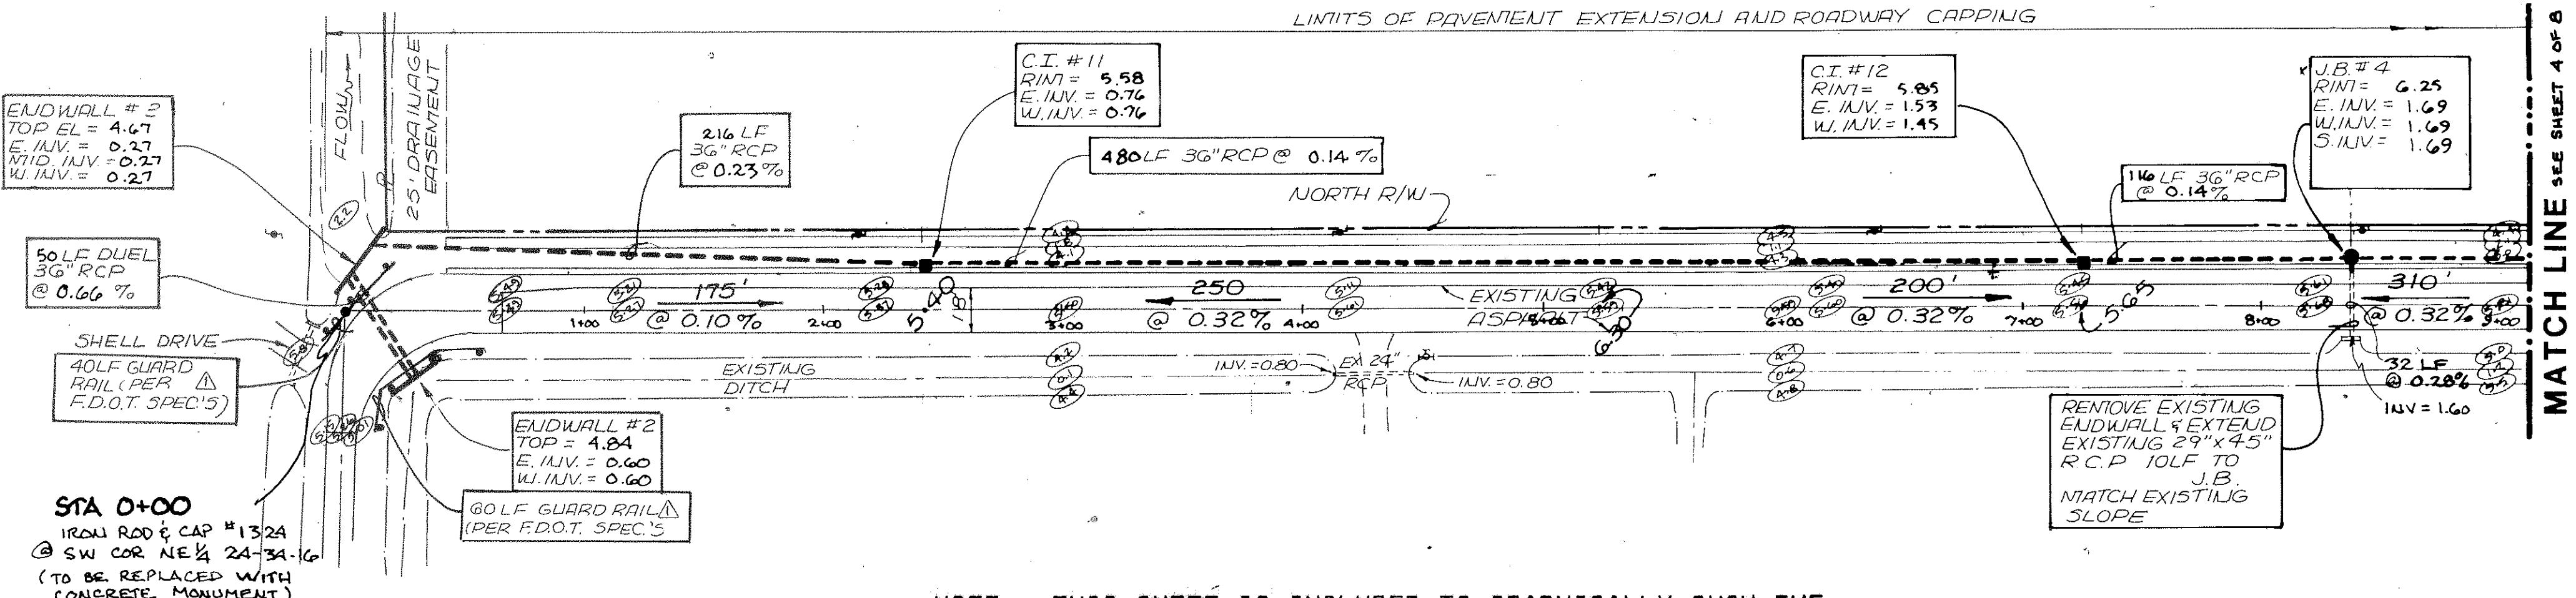

NOTE : THIS SHEET IS INCLUDED TO GRAPHICALLY SHOW THE STATIONING BASIS FOR SANITARY, WATER AND FORCE MAIN IMPROVEMENTS ON 17th AVE. N.W.

Scale:

Vert. 1" = 2'
Horiz. 1" = 50'

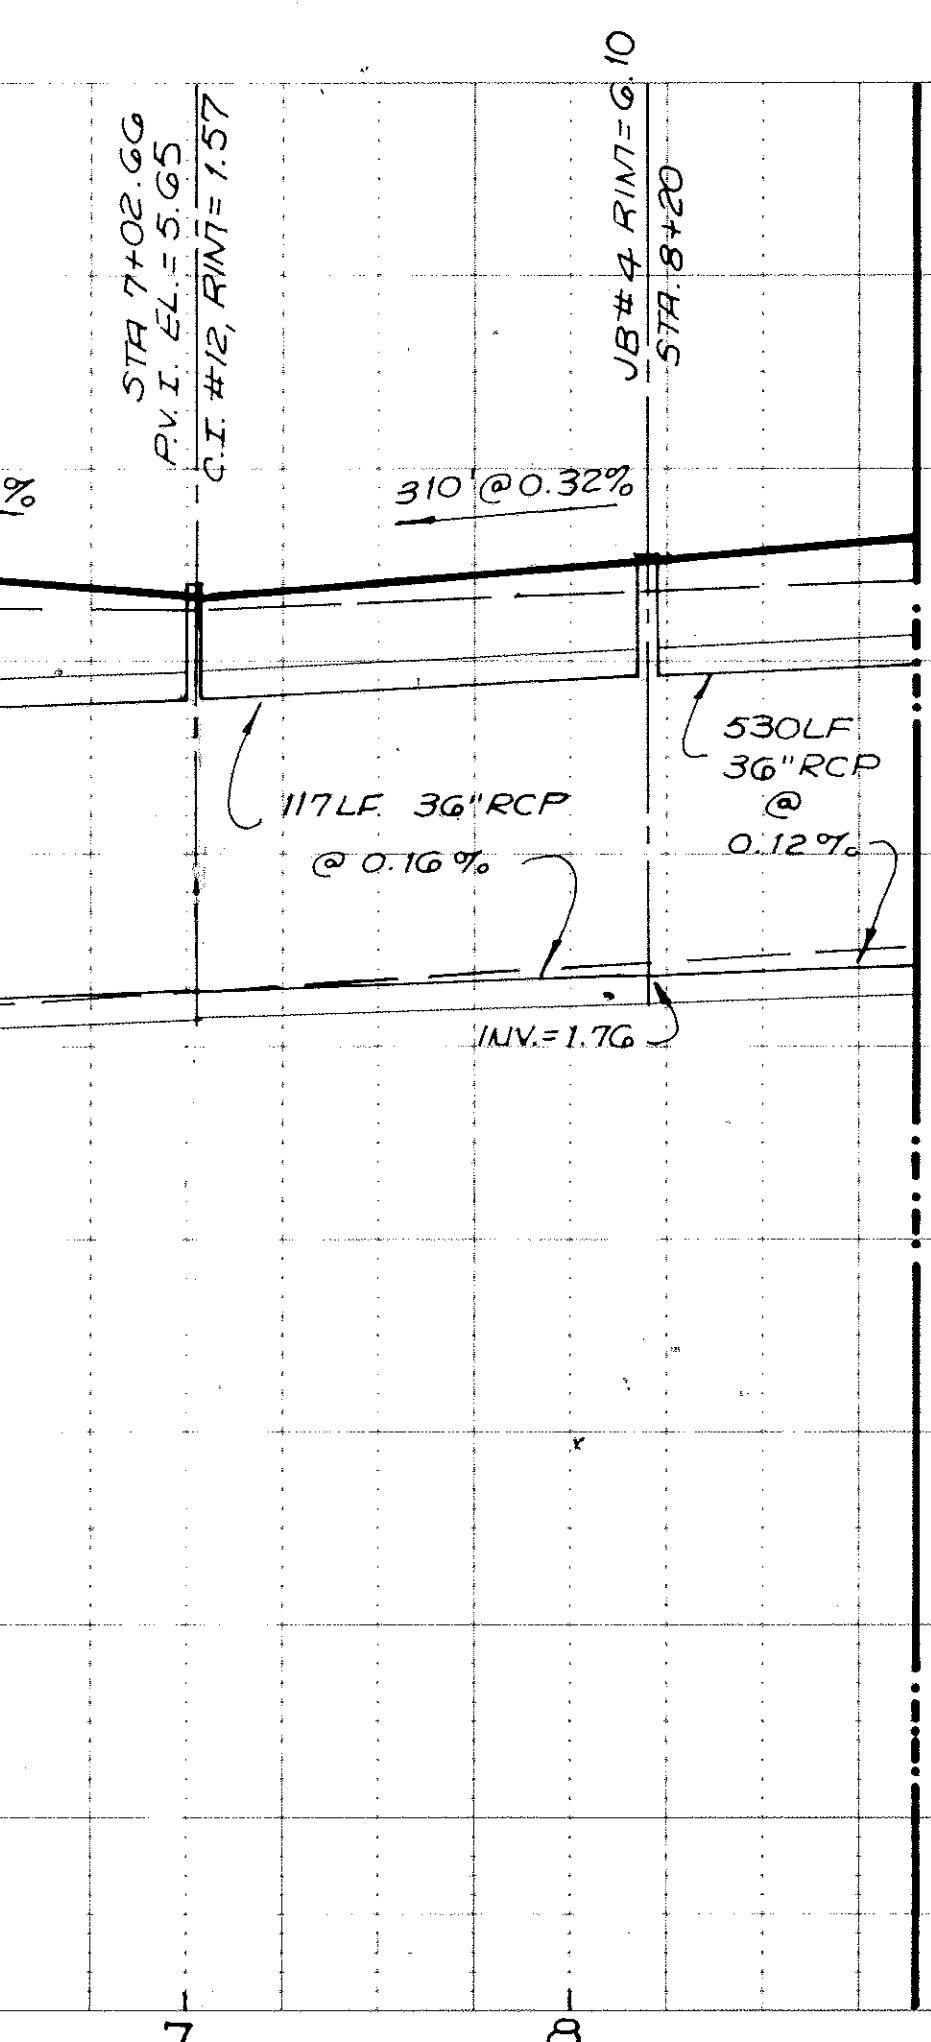

NOTE : PROFILE IS NOT PART OF RECORD DRAWING

PLAN SURVEYED BY
NOTE BOOK NO. 10000
STRUCTURE NOTATIONS CHECKED
No.

PROFILE SURVEYED BY
NOTE BOOK NO. 10000
STRUCTURE NOTATIONS CHECKED
No.

10
9
8
7
6
5
4
3
2
1
0
-1
-2
-3
-4
-5
-6
-7
-8
-9

0 1 2 3 4 5 6 7 8

NOTES:

- EXISTING FORCEMAIN TO BE FIELD LOCATED BY MANATEE COUNTY UTILITIES PRIOR TO PROPOSED FORCEMAIN CONSTRUCTION.
- ALL IMPROVEMENTS WITHIN RIGHT-OF-WAY TO BE CONSTRUCTED TO LATEST APPLICABLE MANATEE COUNTY REGULATIONS AND SPECIFICATIONS. THE CONTRACTOR IS RESPONSIBLE FOR THE RELOCATION OR RECONSTRUCTION OF ANY UNDERGROUND UTILITIES, DRAINAGE FACILITIES, SIGNS, MAILBOXES, AND ANY OTHER ITEM LOCATED WITHIN THE RIGHT-OF-WAY DISTURBED DURING CONSTRUCTION. IF DISTURBED, THE GRASS AREA 2' BEHIND CURB TO BE SODDED. ALL ASPHALT AND CONCRETE SURFACES TO BE REMOVED TO HAVE SAWCUT EDGES.

RECORD DRAWING NOTES:

- SOME IMPROVEMENTS INSTALLED BELOW GROUND HAVE NOT BEEN EXPOSED FOR DIRECT VISUAL CONFIRMATION. THIS RECORD DRAWING SHOWS THE LOCATIONS OF STAKING POINTS THAT HAVE BEEN SET BY, AND LOCATIONS DERIVED FROM INFORMATION SUPPLIED BY THE CONTRACTOR OF RECORD IN ADDITION TO THOSE FEATURES DIRECTLY VIEWED BY Z.N.S FIELD CREWS. ZOLLER, NAJJAR & SHROYER CANNOT GUARANTEE OR ASSUME RESPONSIBILITY FOR THE ACCURACY OF INFORMATION SUPPLIED BY, OR STAKING POINTS SET BY OTHERS.
- EXCEPT WHERE SHOWN, ALL WATER MAIN AND FORCE MAIN BENDS HAVE BEEN ATTAINED BY THE USE OF ELBOWS SMALLER THAN 45 OR BY PIPE DEFLECTION.
- THE FORCE MAIN CONSISTS OF 3,653 LINEAR FEET OF 6" PVC.
- THE OFF-SITE BASELINE USED IS THE MONUMENTED LAND LINE (SOUTH LINE OF THE NORTH 1/2 OF SECTION 24-34-16) DUE TO THE PAVEMENT OF 17TH AVE. N.W. BEING SKewed IN THE RIGHT OF WAY. PAVEMENT OFFSETS FROM THE BASELINE (ALSO BEING THE CENTERLINE OF THE MAINTAINED RIGHT OF WAY) ARE SHOWN IN VARIOUS LOCATIONS.

I HEREBY CERTIFY THAT THE RECORD DRAWINGS OF THE UTILITIES SHOWN, SUPERIMPOSED UPON THE DESIGN CONSTRUCTION PLANS, IS TO THE BEST OF MY KNOWLEDGE, INFORMATION AND BELIEF, A TRUE AND CORRECT REPRESENTATION OF THE IMPROVEMENTS AS SHOWN.

ZOLLER, NAJJAR & SHROYER, INC.
P.O. BOX 9448
BRADENTON, FLORIDA 34206

JAMES N. GATCH, JR. PLS #4295
DATE OF FIELD WORK: 12-30-4-91 DATE OF CERTIFICATION:

REVISIONS

1	TEE VALVE ADDED PER	1/9/90
2	MC REVIEW ADDED PER	7/8/90
3	ADDED	11/1/90
4	RECORD DRAWING	5-8-91
5	FINAL SUBM W/REV	TJS
6	PER MCWD	5-14-91
7		

2015 AVENUE DRIVE EAST
POST OFFICE BOX 9448
FAX (813) 748-3316
BRADENTON FLORIDA 34206
TELEPHONE (813) 748-8080


Zoller, Najjar & Shroyer, Inc.
Engineers, Planners, Surveyors & Landscape Architects
DESIGNED WT CHECKED NTSD DATE MAY 1990 SCALE SHOWN
DRAWN JH COMP JOB NO. 758-11617 FILE NO. 10640 SHEET 5 OF 8

RECORD DRAWING
OFOFF-SITE FORCEMAIN
PLAN
FOR
THE LOOP

LOCATED IN:


SEC. 24, TWP. 34 S., RGE. 16 E.
MANATEE COUNTY, FLORIDAMATCH LINE
(SEE SHEET 6 OF 8)

Scale:

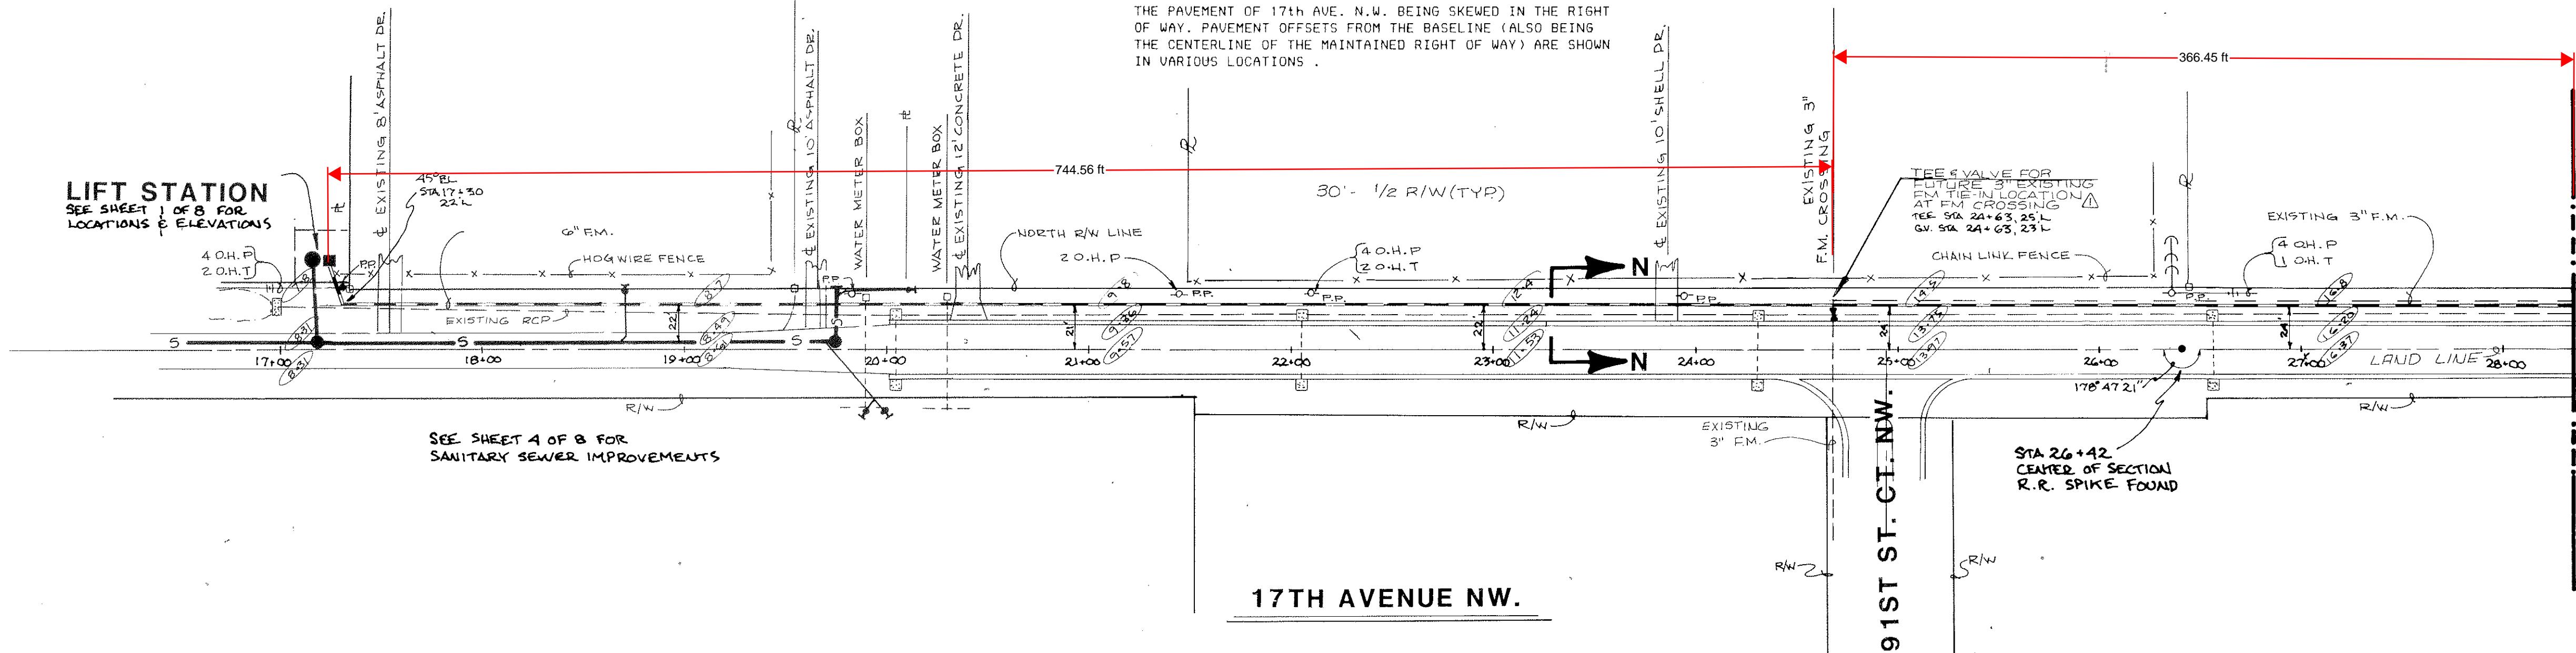Vert. 1" = 2'
Horiz. 1" = 50'NOTE : PROFILE IS NOT
PART OF RECORD DRAWING

PROFILE	DATE
NOTE BOOK	BY
STRUCTURE NOTATIONS	NOTES
STRUCTURE NOTATIONS	NOTES

PROFILE	DATE
NOTE BOOK	BY
STRUCTURE NOTATIONS	NOTES
STRUCTURE NOTATIONS	NOTES

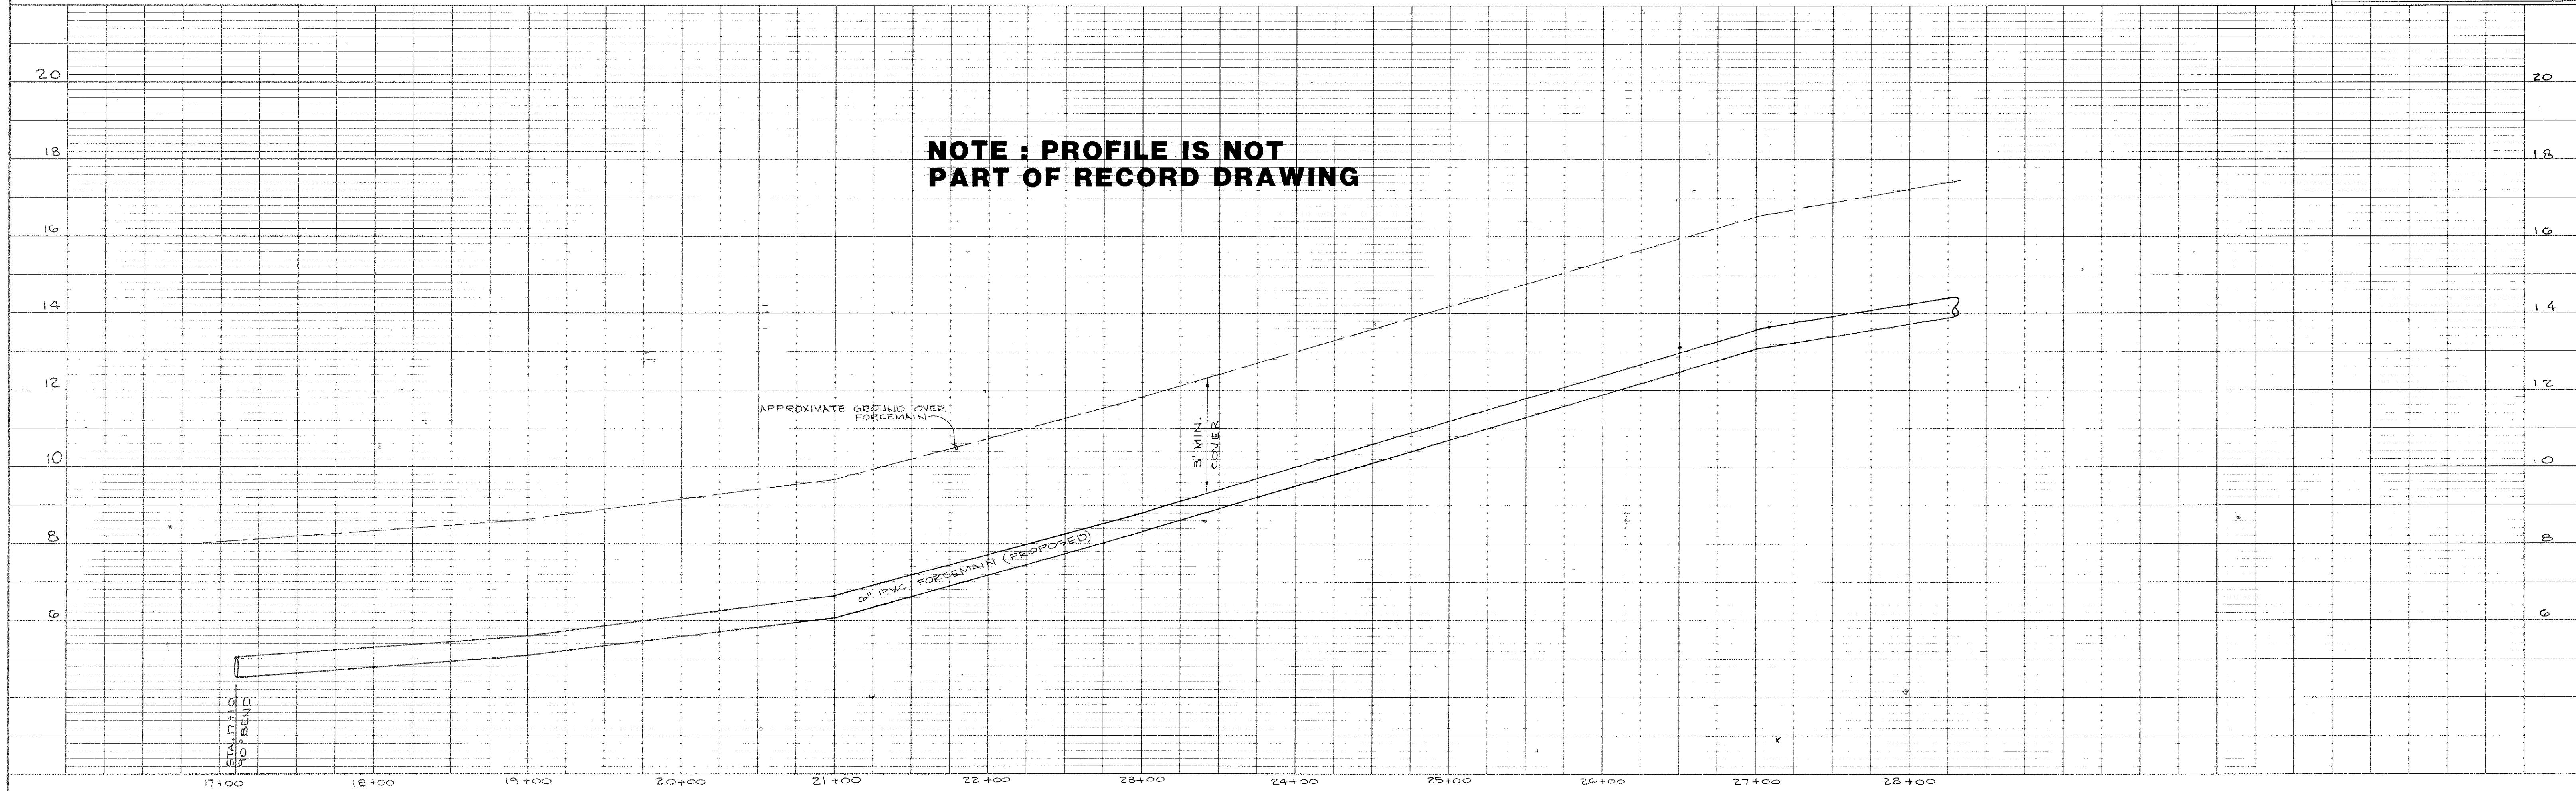

NOTES:

- EXISTING FORCEMAIN TO BE FIELD LOCATED BY MANATEE COUNTY UTILITIES PRIOR TO PROPOSED FORCEMAIN CONSTRUCTION.
- ALL IMPROVEMENTS WITHIN RIGHT-OF-WAY TO BE CONSTRUCTED TO LATEST APPLICABLE MANATEE COUNTY REGULATIONS AND SPECIFICATIONS. THE CONTRACTOR IS RESPONSIBLE FOR THE RELOCATION OR RECONSTRUCTION OF ANY UNDERGROUND UTILITIES, DRAINAGE FACILITIES, SIGNS, MAILBOXES, AND ANY OTHER ITEM LOCATED WITHIN THE RIGHT-OF-WAY DISTURBED DURING CONSTRUCTION. IF DISTURBED, THE GRASS AREA 2' BEHIND CURB TO BE SODDED. ALL ASPHALT AND CONCRETE SURFACES TO BE REMOVED TO HAVE SAWCUT EDGES.

I HEREBY CERTIFY THAT THE RECORD DRAWINGS OF THE UTILITIES SHOWN, SUPERIMPOSED UPON THE DESIGN CONSTRUCTION PLANS, IS TO THE BEST OF MY KNOWLEDGE, INFORMATION AND BELIEF, A TRUE AND CORRECT REPRESENTATION OF THE IMPROVEMENTS AS SHOWN.

ZOLLER, NAJJAR & SHROYER, INC.
P.O. BOX 9448
BRADENTON, FLORIDA 34206

JAMES N. GATCH, JR. PLS. #4295
DATE OF FIELD WORK : 12-90 - 4-91 DATE OF CERTIFICATION:

REVISIONS	
1	FM OFFSET ADDED PER MAN CO. REVIEW 7/9/90
2	RECORD DRAWING 5-91
3	PER MCPWD 5-14-91
4	
5	
6	
7	

Zoller, Najjar & Shroyer, Inc.
Engineers, Planners, Surveyors & Landscape Architects


2015 AVENUE DRIVE EAST
POST OFFICE BOX 9448
FAX: (813) 746-3316
BRADENTON, FLORIDA 34206
TELEPHONE (813) 746-8080

RECORD DRAWING OF

OFF-SITE FORCEMAIN PLAN FOR THE LOOP

LOCATED IN:
SEC. 24, TWP. 34 S., RGE. 16 E.
MANATEE COUNTY, FLORIDA

MATCH LINE
SEE SHEET 7 OF 8

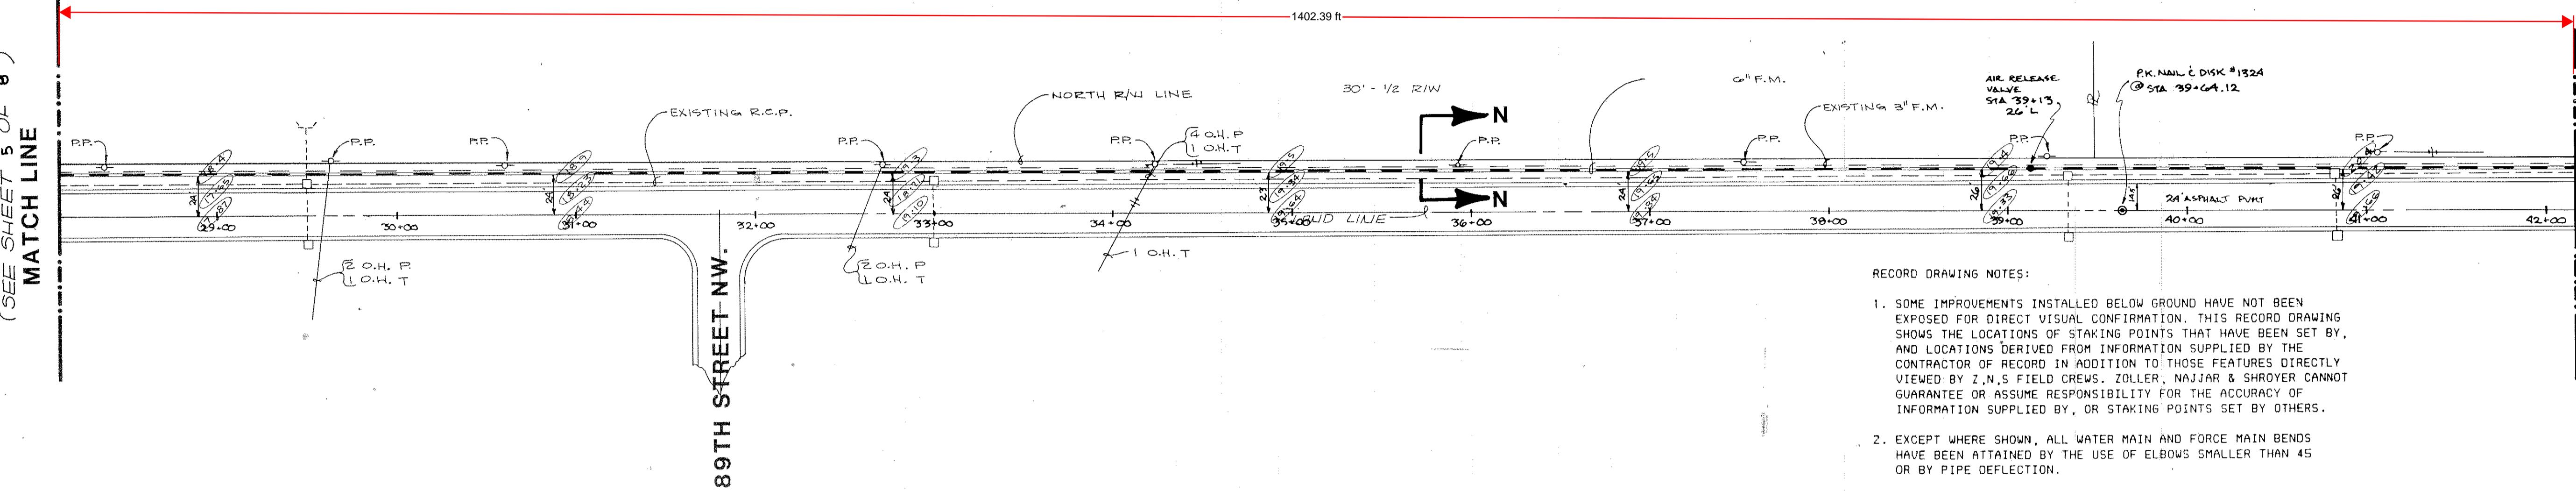

RECORD DRAWING NOTES:


- SOME IMPROVEMENTS INSTALLED BELOW GROUND HAVE NOT BEEN EXPOSED FOR DIRECT VISUAL CONFIRMATION. THIS RECORD DRAWING SHOWS THE LOCATIONS OF STAKING POINTS THAT HAVE BEEN SET BY, AND LOCATIONS DERIVED FROM INFORMATION SUPPLIED BY THE CONTRACTOR OF RECORD IN ADDITION TO THOSE FEATURES DIRECTLY VIEWED BY Z.N.S FIELD CREWS. ZOLLER, NAJJAR & SHROYER CANNOT GUARANTEE OR ASSUME RESPONSIBILITY FOR THE ACCURACY OF INFORMATION SUPPLIED BY, OR STAKING POINTS SET BY OTHERS.
- EXCEPT WHERE SHOWN, ALL WATER MAIN AND FORCE MAIN BENDS HAVE BEEN ATTAINED BY THE USE OF ELBOWS SMALLER THAN 45 OR BY PIPE DEFLECTION.
- THE FORCE MAIN CONSISTS OF 3,653 LINEAR FEET OF 6" PVC.
- THE OFF-SITE BASELINE USED IS THE MONUMENTED LAND LINE (SOUTH LINE OF THE NORTH 1/2 OF SECTION 24-34-16) DUE TO THE PAVEMENT OF 17TH AVE. N.W. BEING SKewed IN THE RIGHT OF WAY. PAVEMENT OFFSETS FROM THE BASELINE (ALSO BEING THE CENTERLINE OF THE MAINTAINED RIGHT OF WAY) ARE SHOWN IN VARIOUS LOCATIONS.

Scale:
Vert. 1" = 2'
Horiz. 1" = 50'

17TH AVENUE NW

NOTE : PROFILE IS NOT
PART OF RECORD DRAWING

PROFILE
SURVEYED
PLOTTED - CHECKED
NOTE BOOK
BY A MEMBER
STRUCTURE NOTATIONS CHECKED
No. _____

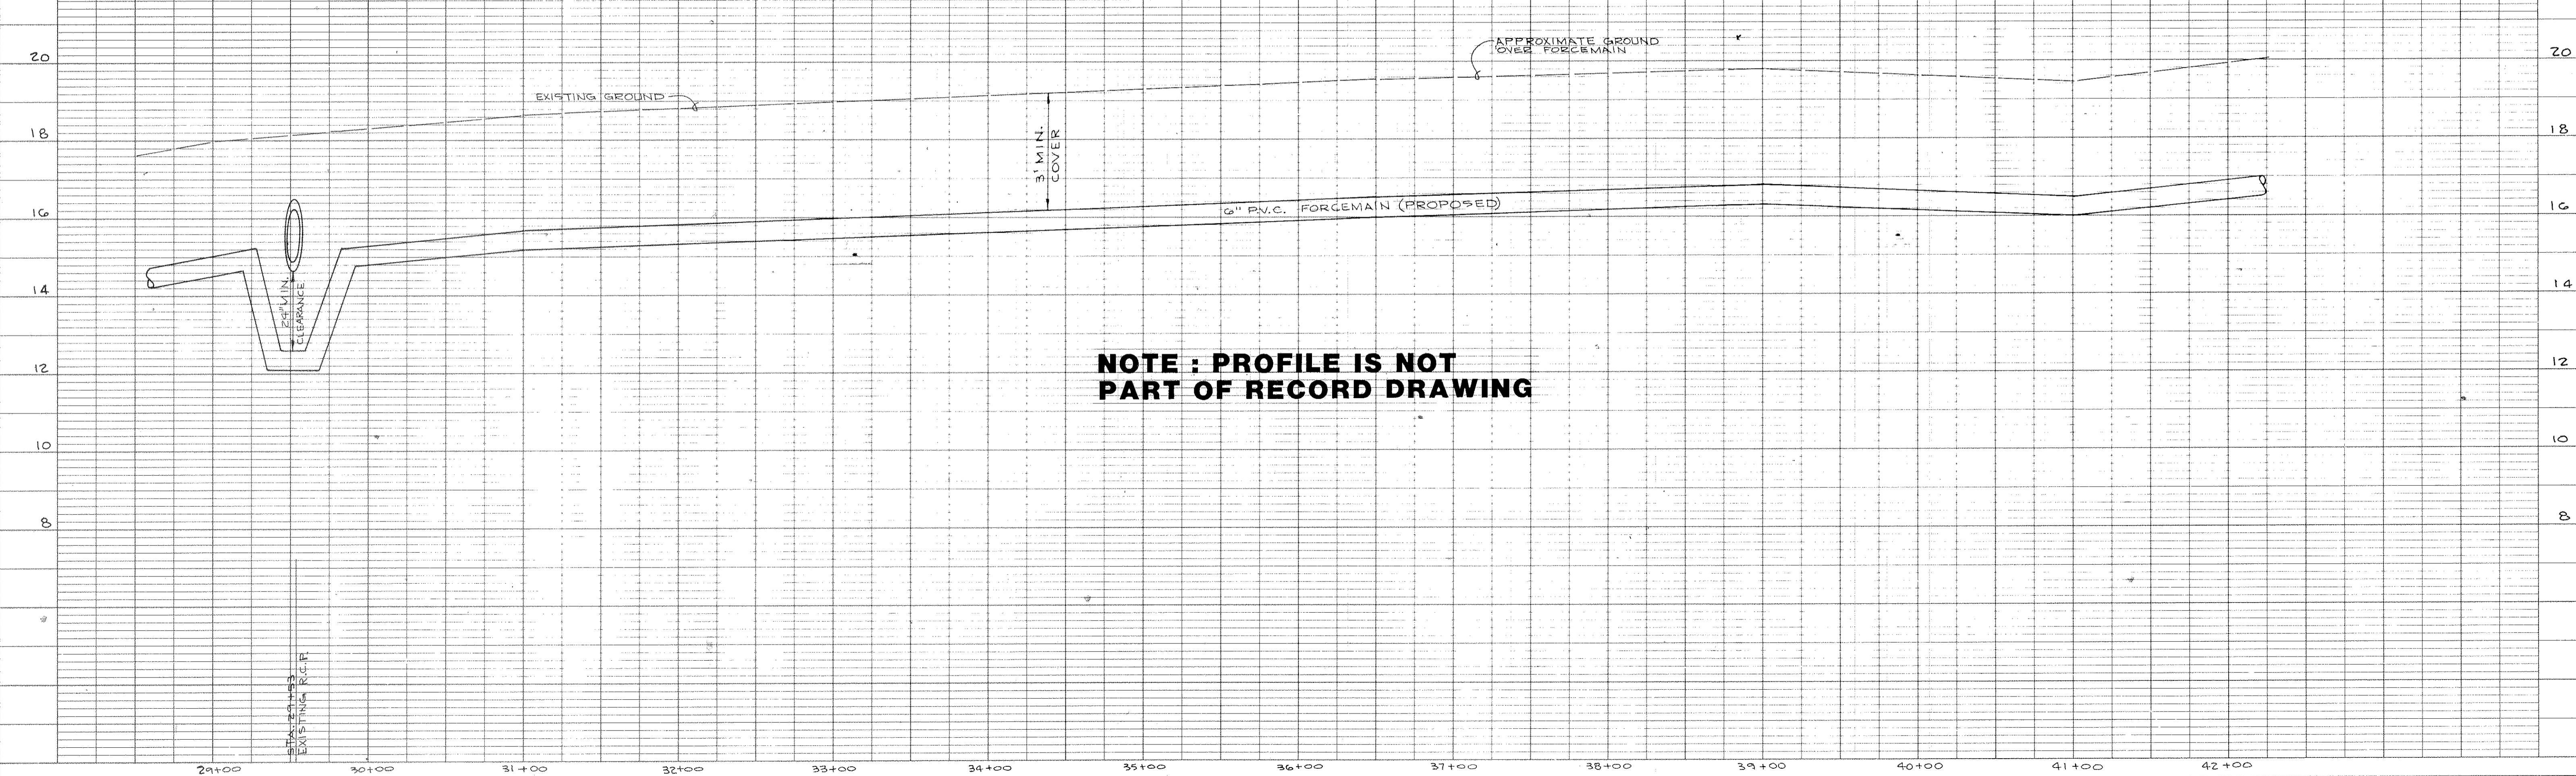

NOTES:

- EXISTING FORCEMAIN TO BE FIELD LOCATED BY MANATEE COUNTY UTILITIES PRIOR TO PROPOSED FORCEMAIN CONSTRUCTION.
- ALL IMPROVEMENTS WITHIN RIGHT-OF-WAY TO BE CONSTRUCTED TO LATEST APPLICABLE MANATEE COUNTY REGULATIONS AND SPECIFICATIONS. THE CONTRACTOR IS RESPONSIBLE FOR THE RELOCATION OR RECONSTRUCTION OF ANY UNDERGROUND UTILITIES, DRAINAGE FACILITIES, SIGNS, MAILBOXES, AND ANY OTHER ITEM LOCATED WITHIN THE RIGHT-OF-WAY DISTURBED DURING CONSTRUCTION. IF DISTURBED, THE GRASS AREA 2' BEHIND CURB TO BE SODDED. ALL ASPHALT AND CONCRETE SURFACES TO BE REMOVED TO HAVE SAWCUT EDGES.

I HEREBY CERTIFY THAT THE RECORD DRAWINGS OF THE UTILITIES SHOWN, SUPERIMPOSED UPON THE DESIGN CONSTRUCTION PLANS, IS TO THE BEST OF MY KNOWLEDGE, INFORMATION AND BELIEF, A TRUE AND CORRECT REPRESENTATION OF THE IMPROVEMENTS AS SHOWN.

ZOLLER, NAJJAR & SHROYER, INC.
P.O. BOX 9448
BRADENTON, FLORIDA 34206

JAMES N. GATCH, JR. PL-54295
DATE OF FIELD WORK: 12-90 - 4-91 DATE OF CERTIFICATION:

REVISIONS

ROAD CUT REVIEW	7/9/90
MATERIAL PER	7/9/90
FM TO MULCH IN REVEGED	
3 FM ON W SIDE TO R SIDE 10/19/90	
4 RECORD DRAWING 5/19/91	
5 PER MCWD 5/14/91	


201 5TH AVENUE DRIVE EAST
POST OFFICE BOX 9448

FAX (813) 748-3316

BRADENTON FLORIDA 34208
TELEPHONE (813) 748-0860


Zoller, Najjar & Shroyer, Inc.
Engineers, Planners, Surveyors & Landscape Architects

DESIGNED WT CHECKED N750 DATE MAY 1990 SCALE SHOWN
DRAWN J/T/H COMP. JOB NO. 758-11617 FILE NO. 10640 SHEET 7 OF 8

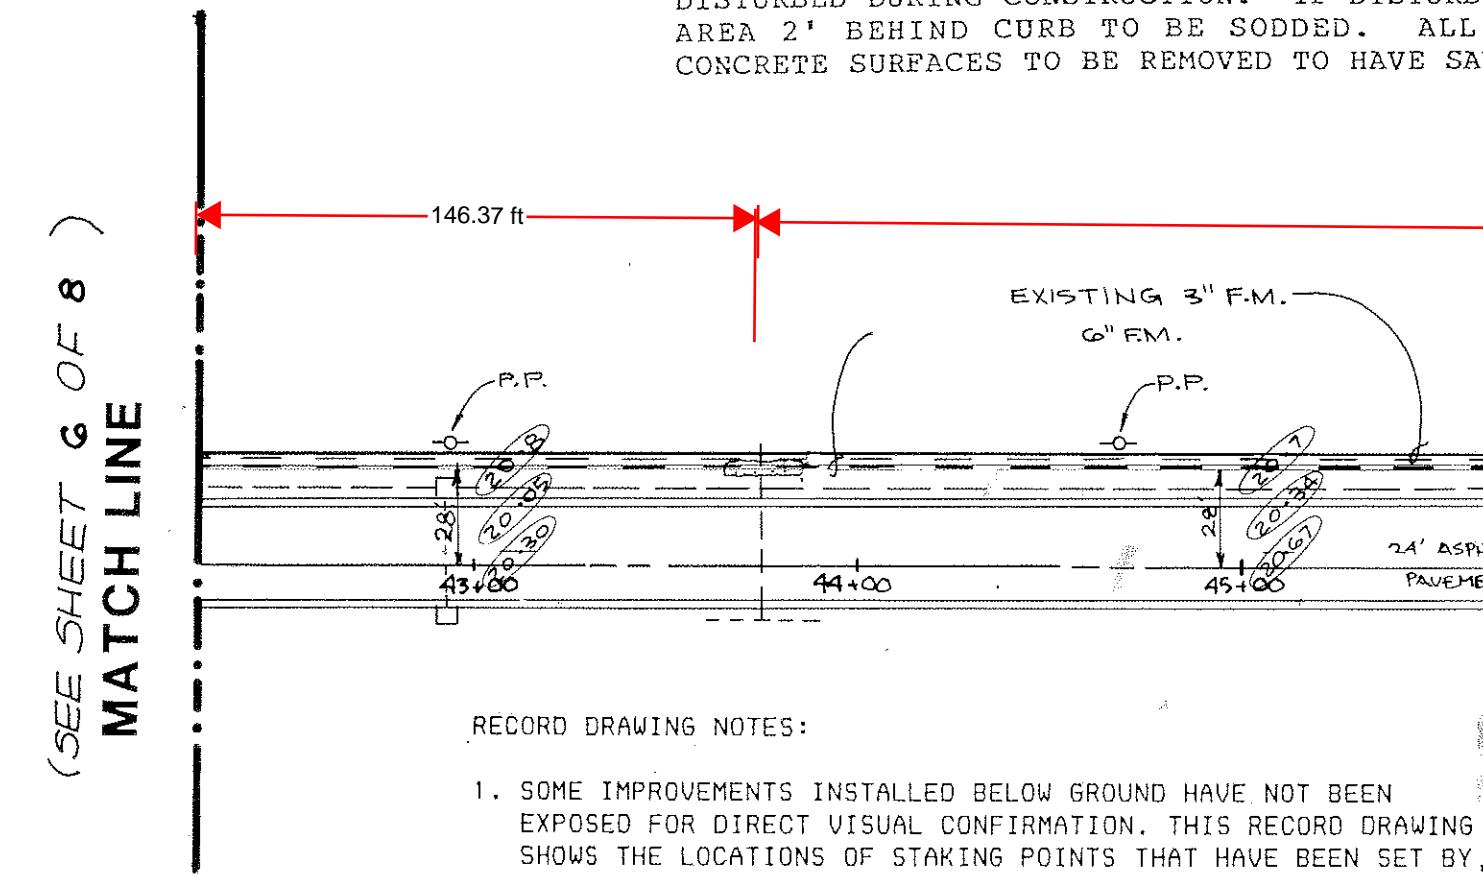


RECORD DRAWING NOTES:

- SOME IMPROVEMENTS INSTALLED BELOW GROUND HAVE NOT BEEN EXPOSED FOR DIRECT VISUAL CONFIRMATION. THIS RECORD DRAWING SHOWS THE LOCATIONS OF STAKING POINTS THAT HAVE BEEN SET BY, AND LOCATIONS DERIVED FROM INFORMATION SUPPLIED BY THE CONTRACTOR OF RECORD IN ADDITION TO THOSE FEATURES DIRECTLY VIEWED BY Z.N.S FIELD CREWS. ZOLLER, NAJJAR & SHROYER CANNOT GUARANTEE OR ASSUME RESPONSIBILITY FOR THE ACCURACY OF INFORMATION SUPPLIED BY, OR STAKING POINTS SET BY OTHERS.
- EXCEPT WHERE SHOWN, ALL WATER MAIN AND FORCE MAIN BENDS HAVE BEEN ATTAINED BY THE USE OF ELBOWS SMALLER THAN 45 OR BY PIPE DEFLECTION.
- THE FORCE MAIN CONSISTS OF 3,653 LINEAR FEET OF 6" PVC.
- THE OFF-SITE BASELINE USED IS THE MONUMENTED LAND LINE (SOUTH LINE OF THE NORTH 1/2 OF SECTION 24-34-16) DUE TO THE PAVEMENT OF 17th AVE. N.W. BEING SKEWED IN THE RIGHT OF WAY. PAVEMENT OFFSETS FROM THE BASELINE (ALSO BEING THE CENTERLINE OF THE MAINTAINED RIGHT OF WAY) ARE SHOWN IN VARIOUS LOCATIONS.

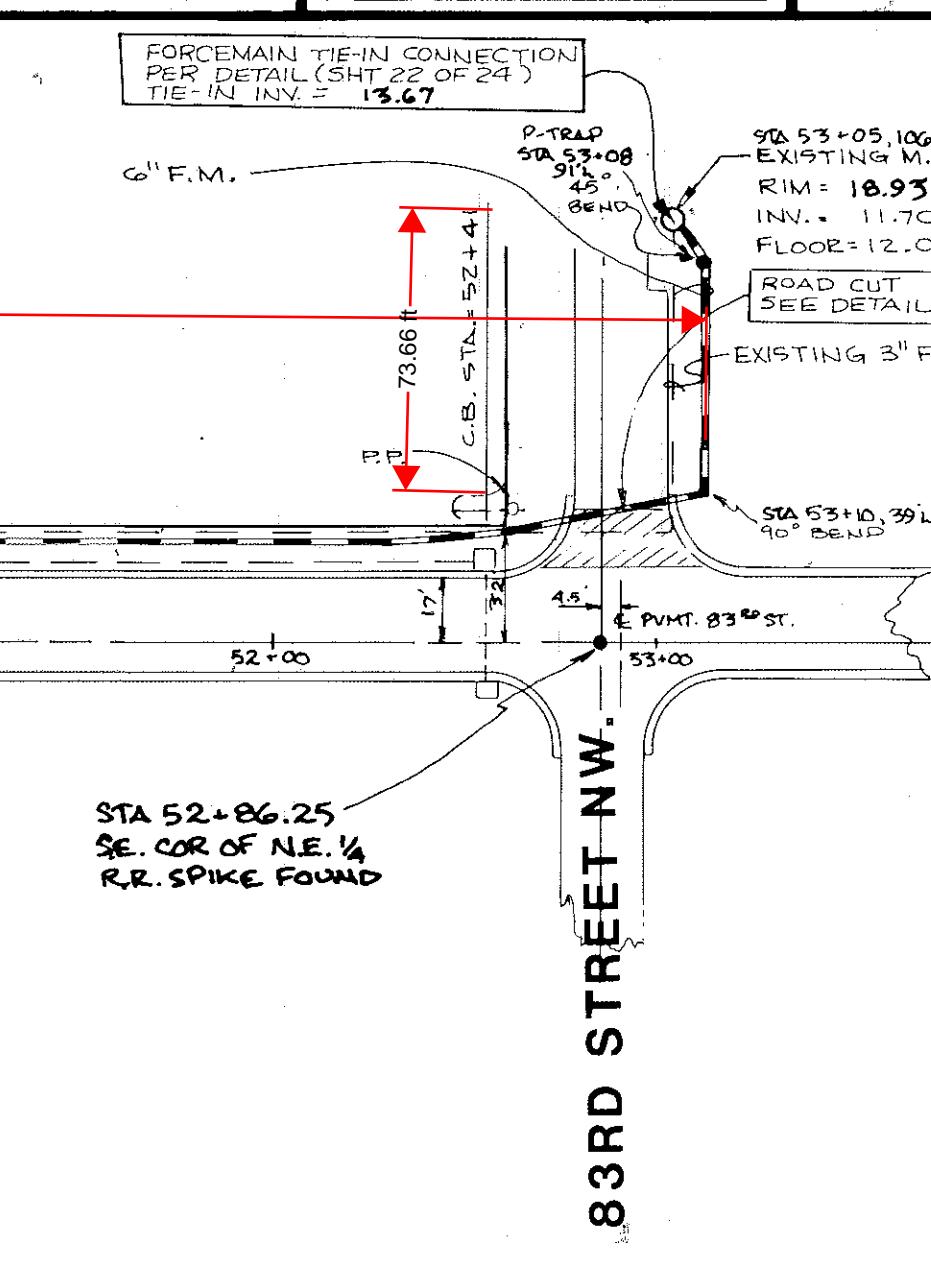17TH AVENUE NW.

RECORD DRAWING OF OFF-SITE FORCEMAIN PLAN FOR THE LOOP

LOCATED IN:
SEC. 24, TWP. 34 S., RGE. 16 E.
MANATEE COUNTY, FLORIDA

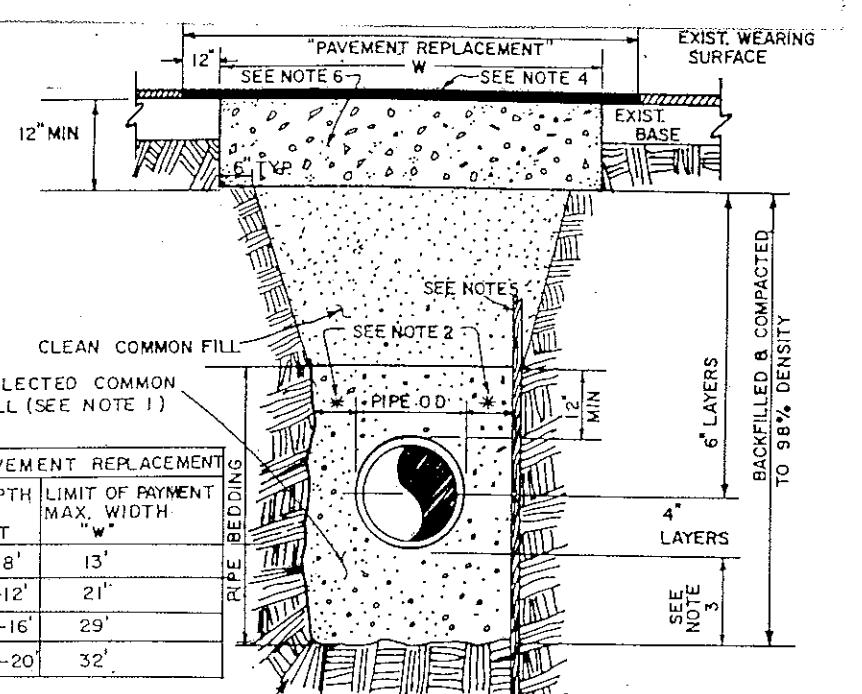


UTILITY ROAD CUT REPLACEMENT DETAIL

NOT TO SCALE

Scale:


Vert. 1" = 2'
Horiz. 1" = 50'

**NOTE : PROFILE IS NOT
PART OF RECORD DRAWING**

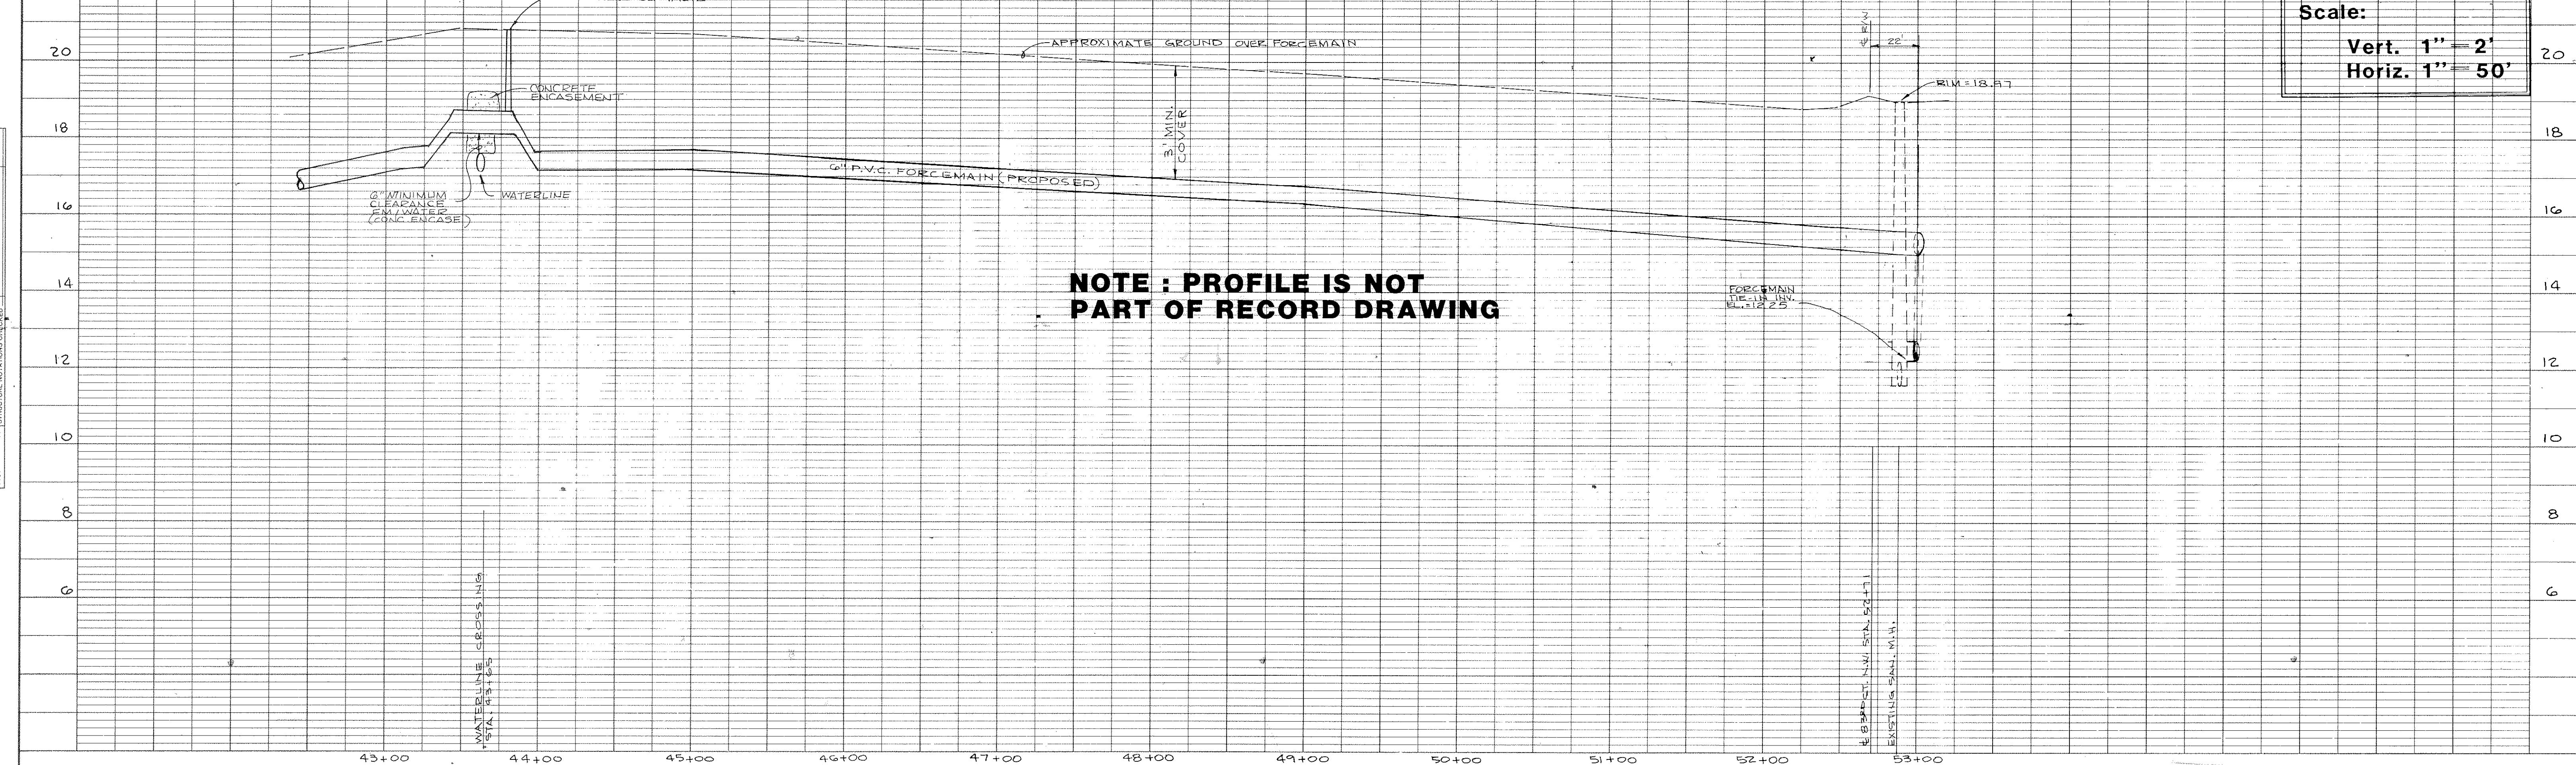

PUMP SPECIFICATIONS	
PUMPS	54 NX - ZEA
SIZE	5 BHP
PHASE	3
VOLTAGE	230
G.P.M.	210
T.D.H.	41.0
IMPELLER	7.50"
R.P.M.	1750

- NOTES:
- WET WELL AND VALVE BOX SHALL BE COATED INSIDE AND OUTSIDE WITH 2 COATS OF EPOXY TYPE PAINT AS APPROVED BY THE ENGINEER. ALL EXPOSED PIPING AND VALVES ABOVE PUMPS SHALL RECEIVE 2 FIELD COATS OF EPOXY PAINT AFTER ASSEMBLY. ALL SURFACES TO BE PAINTED SHALL BE THOROUGHLY CLEANED IN PREPARATION FOR PAINTING.
 - DETAILED SHOP DRAWINGS INCLUDING ALL COMPONENTS SHALL BE SUBMITTED AND APPROVED BY THE ENGINEER AND MANATEE COUNTY PUBLIC WORKS DEPT. (MCPWD) PRIOR TO CONSTRUCTION.
 - CONTRACTOR TO PROVIDE 5 LOCKS, KEYED ALIKE. LOCKS FOR PUBLIC LIFT STATIONS ARE TO BE OBTAINED FROM MANATEE COUNTY UTILITIES DEPARTMENT.
 - PUMP CONTROLS TO BE ACTIVATED BY APPROVED MERCURY FLOAT SWITCHES AS SHOWN. CONTROLS TO BE 24-VAC.
 - ELECTRIC CONTROLS TO BE HOUSED IN WEATHERPROOF NEMA 3R STAINLESS STEEL ENCLOSURE. LOAD CENTER SHALL BE SQUARE "D" OR EQUAL WITH FURNIS MAGNETIC ALTERNATOR. PANEL SHALL CONTAIN DISCONNECT 2 H.O.A. SWITCHES, HOUR METERS TO RECORD RUNNING TIME FOR EACH PUMP, AND ALL INTERNAL WIRING NECESSARY FOR A COMPLETE OPERATING SYSTEM MARKED AND IN COMPLIANCE WITH THE NATIONAL ELECTRIC CODE. CONTRACTOR TO OBTAIN MCPWD MINIMUM SPECIFICATIONS (SPCS) PRIOR TO ORDERING ELECTRICAL EQUIPMENT.
 - ALL ACCESS LIDS TO BE ALUMINUM, HINGED AND PADLOCKED AS SHOWN.
 - FORCE MAIN TO HAVE A MINIMUM OF 36" COVER.
 - FURNISH AND INSTALL PRESSURE TYPE VACUUM BREAKER, SIMILAR OR EQUAL TO WATTS MODEL 909, HWOT, ON LIFT STATION WATER SERVICE.
 - ALL WORK IS TO BE IN COMPLIANCE WITH MCPWD SPECS. IN CASE OF CONFLICT, THE MORE STRINGENT CRITERIA SHALL GOVERN.
 - CONTRACTOR SHALL SUBMIT SHOP DRAWINGS FOR APPROVAL IF PRE-CAST STRUCTURES ARE USED.
 - CONTRACTOR IS ADVISED TO CHECK THE LANDSCAPING PLAN FOR PLANTING AND IRRIGATION DETAILS.
 - ALL D.I.P. TO BE CL53 (MIN.).

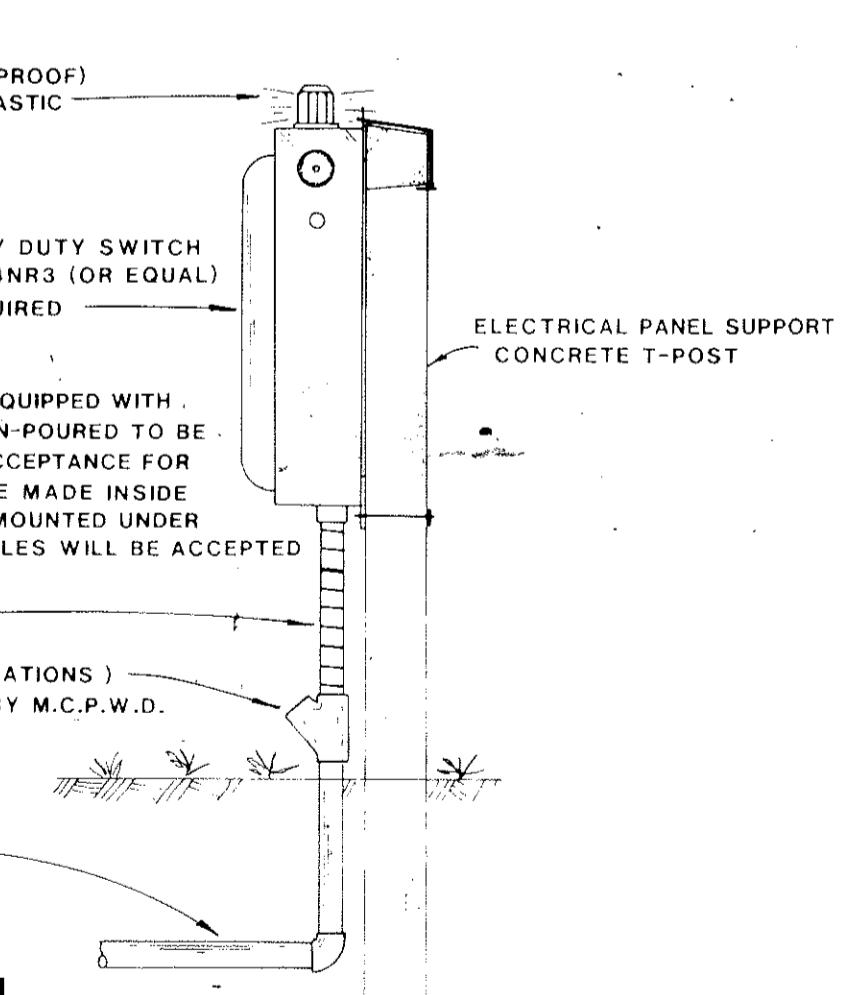

RECORD DRAWING OF LIFT STATION FOR THE LOOP

LOCATED IN:
SEC. 24, TWP. 34 S., RGE. 16 E.
MANATEE COUNTY, FLORIDA

Zoller, Najjar & Shroyer, Inc.


Engineers, Planners, Surveyors & Landscape Architects

BRADENTON, FLORIDA 32506
TELEPHONE (813) 748-8000


REVISIONS	
1	"L" & "M" SIZES REV/MODIFIED 7-24-90
2	RECORD DRAWING 7-24-90
3	FINAL SUBM. W/REV 5-14-91
4	PER MCPWD
5	
6	
7	

DESIGNED BY JH CHECKED MJD DATE MAY 1990 SCALE 1:100
DRAWN JH COMP JOB NO 756-11617 FILE NO 10640 SHEET 5 OF 8


I HEREBY CERTIFY THAT THE RECORD DRAWINGS OF THE UTILITIES SHOWN, SUPERIMPOSED UPON THE DESIGN CONSTRUCTION PLANS, IS TO THE BEST OF MY KNOWLEDGE, INFORMATION AND BELIEF, A TRUE AND CORRECT REPRESENTATION OF THE IMPROVEMENTS AS SHOWN.
ZOLLER, NAJJAR & SHROYER, INC.
P.O. BOX 9448
BRADENTON, FLORIDA 34206
JAMES A. GATCH, JR. PLS. #4295
DATE OF FIELD WORK : 12-20- 4-91 DATE OF CERTIFICATION:

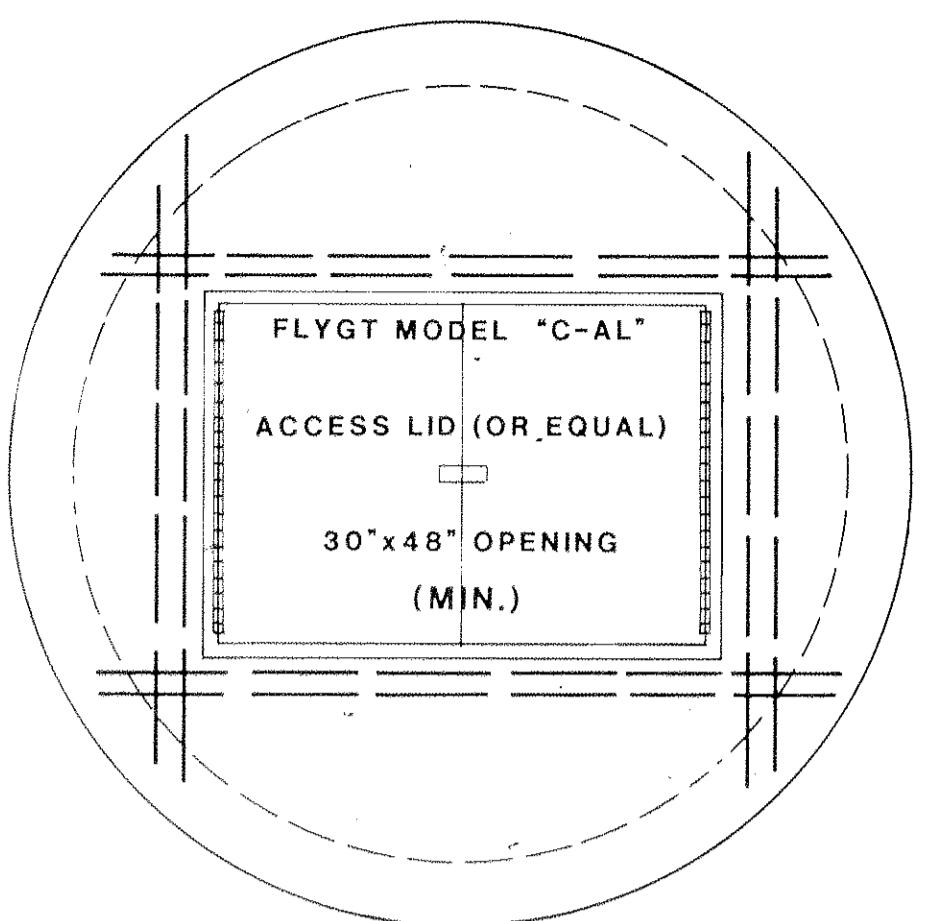


PLAN VIEW

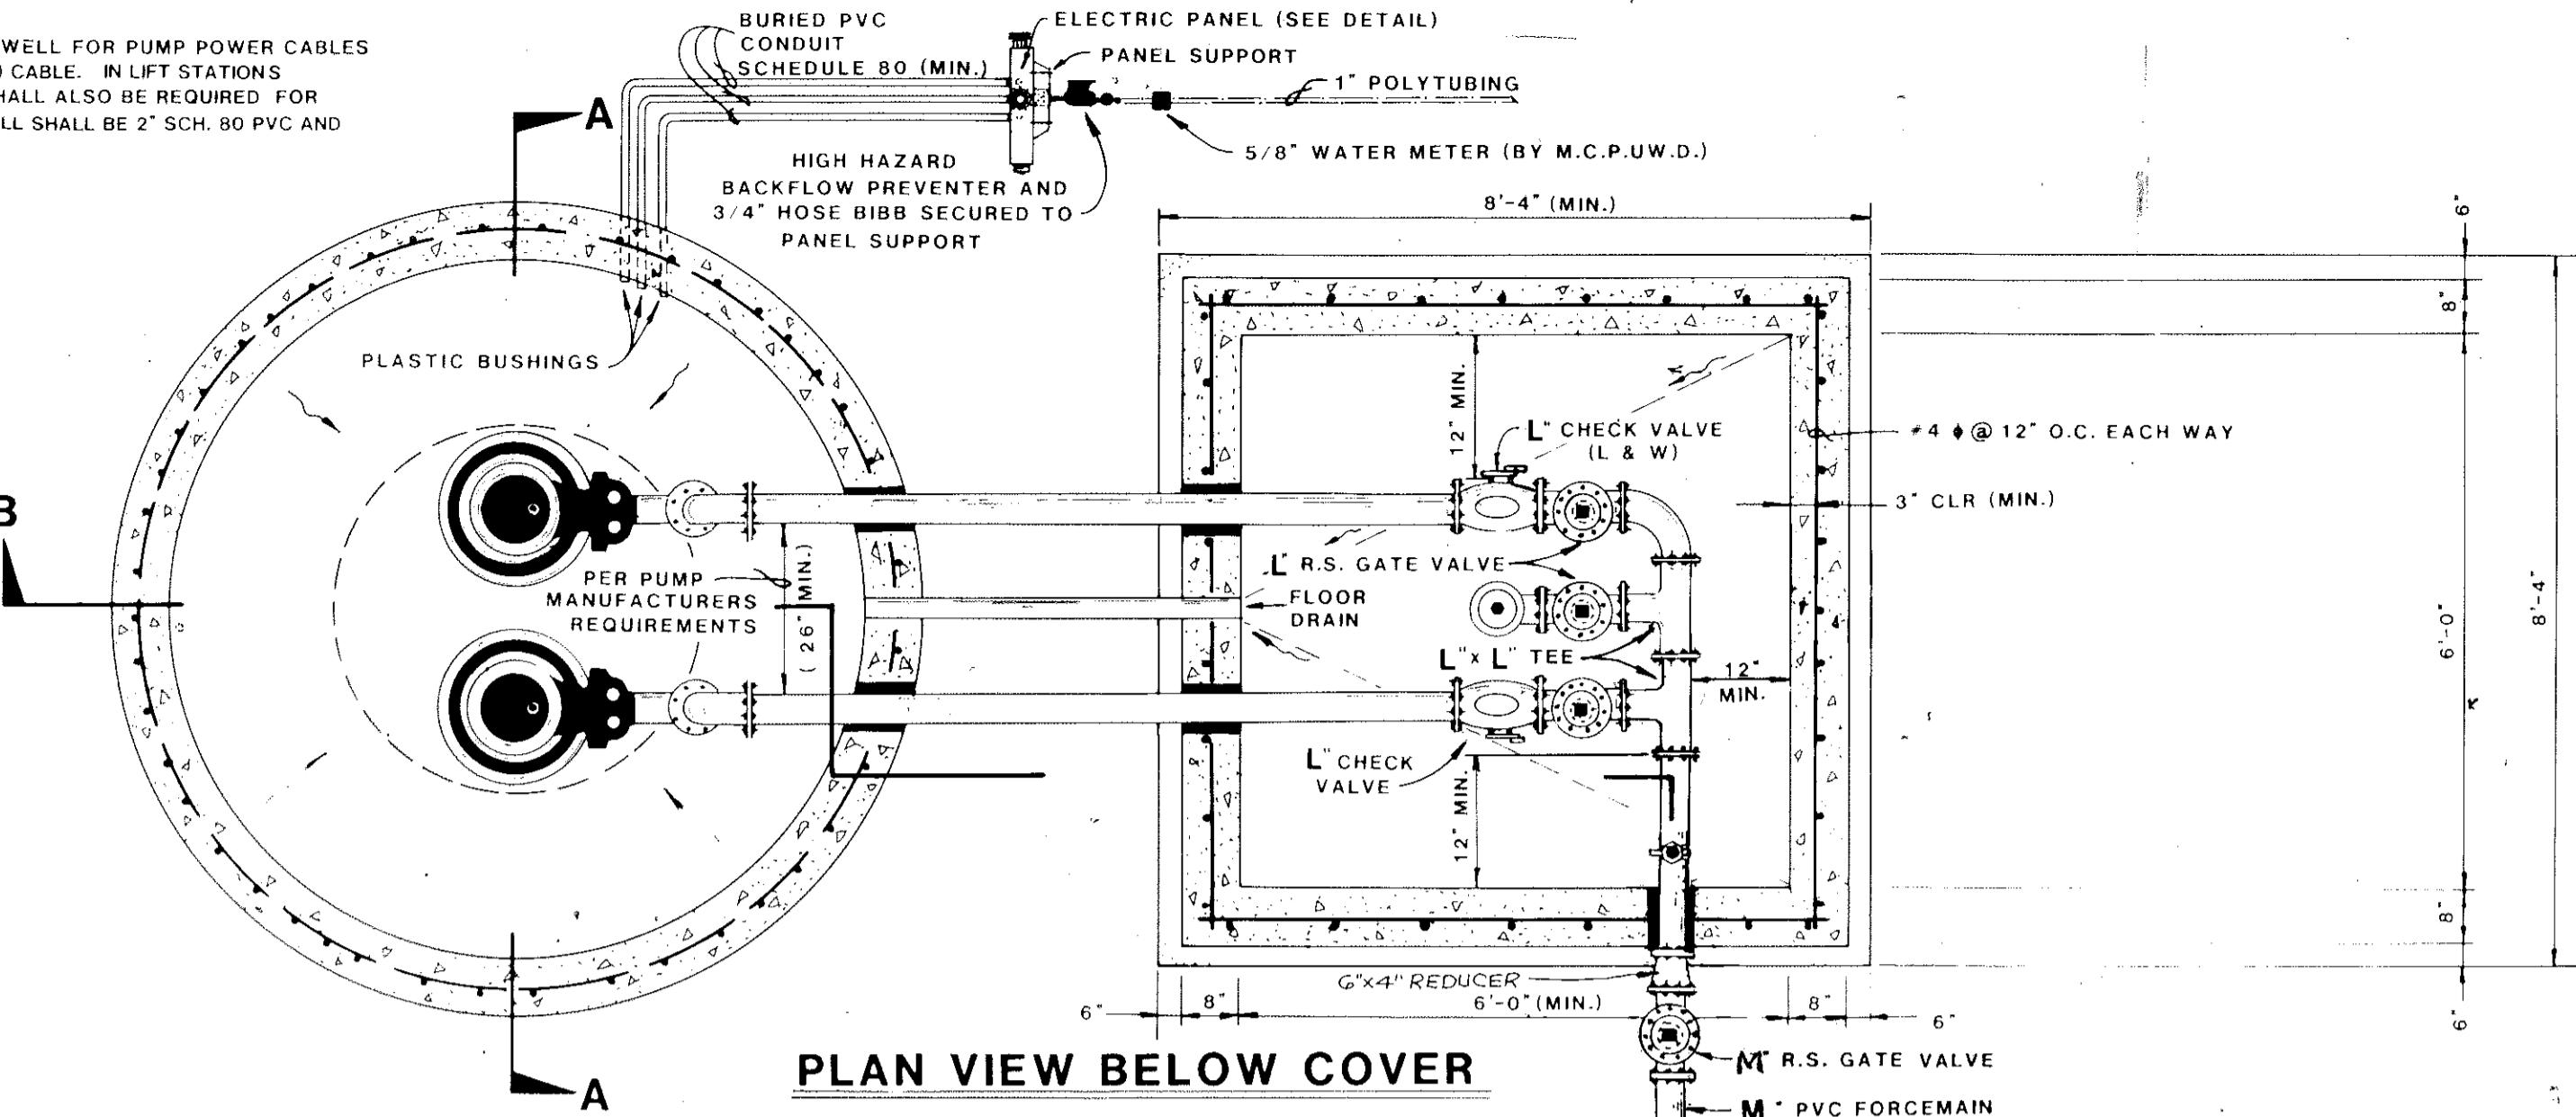

PLAN VIEW BELOW COVER

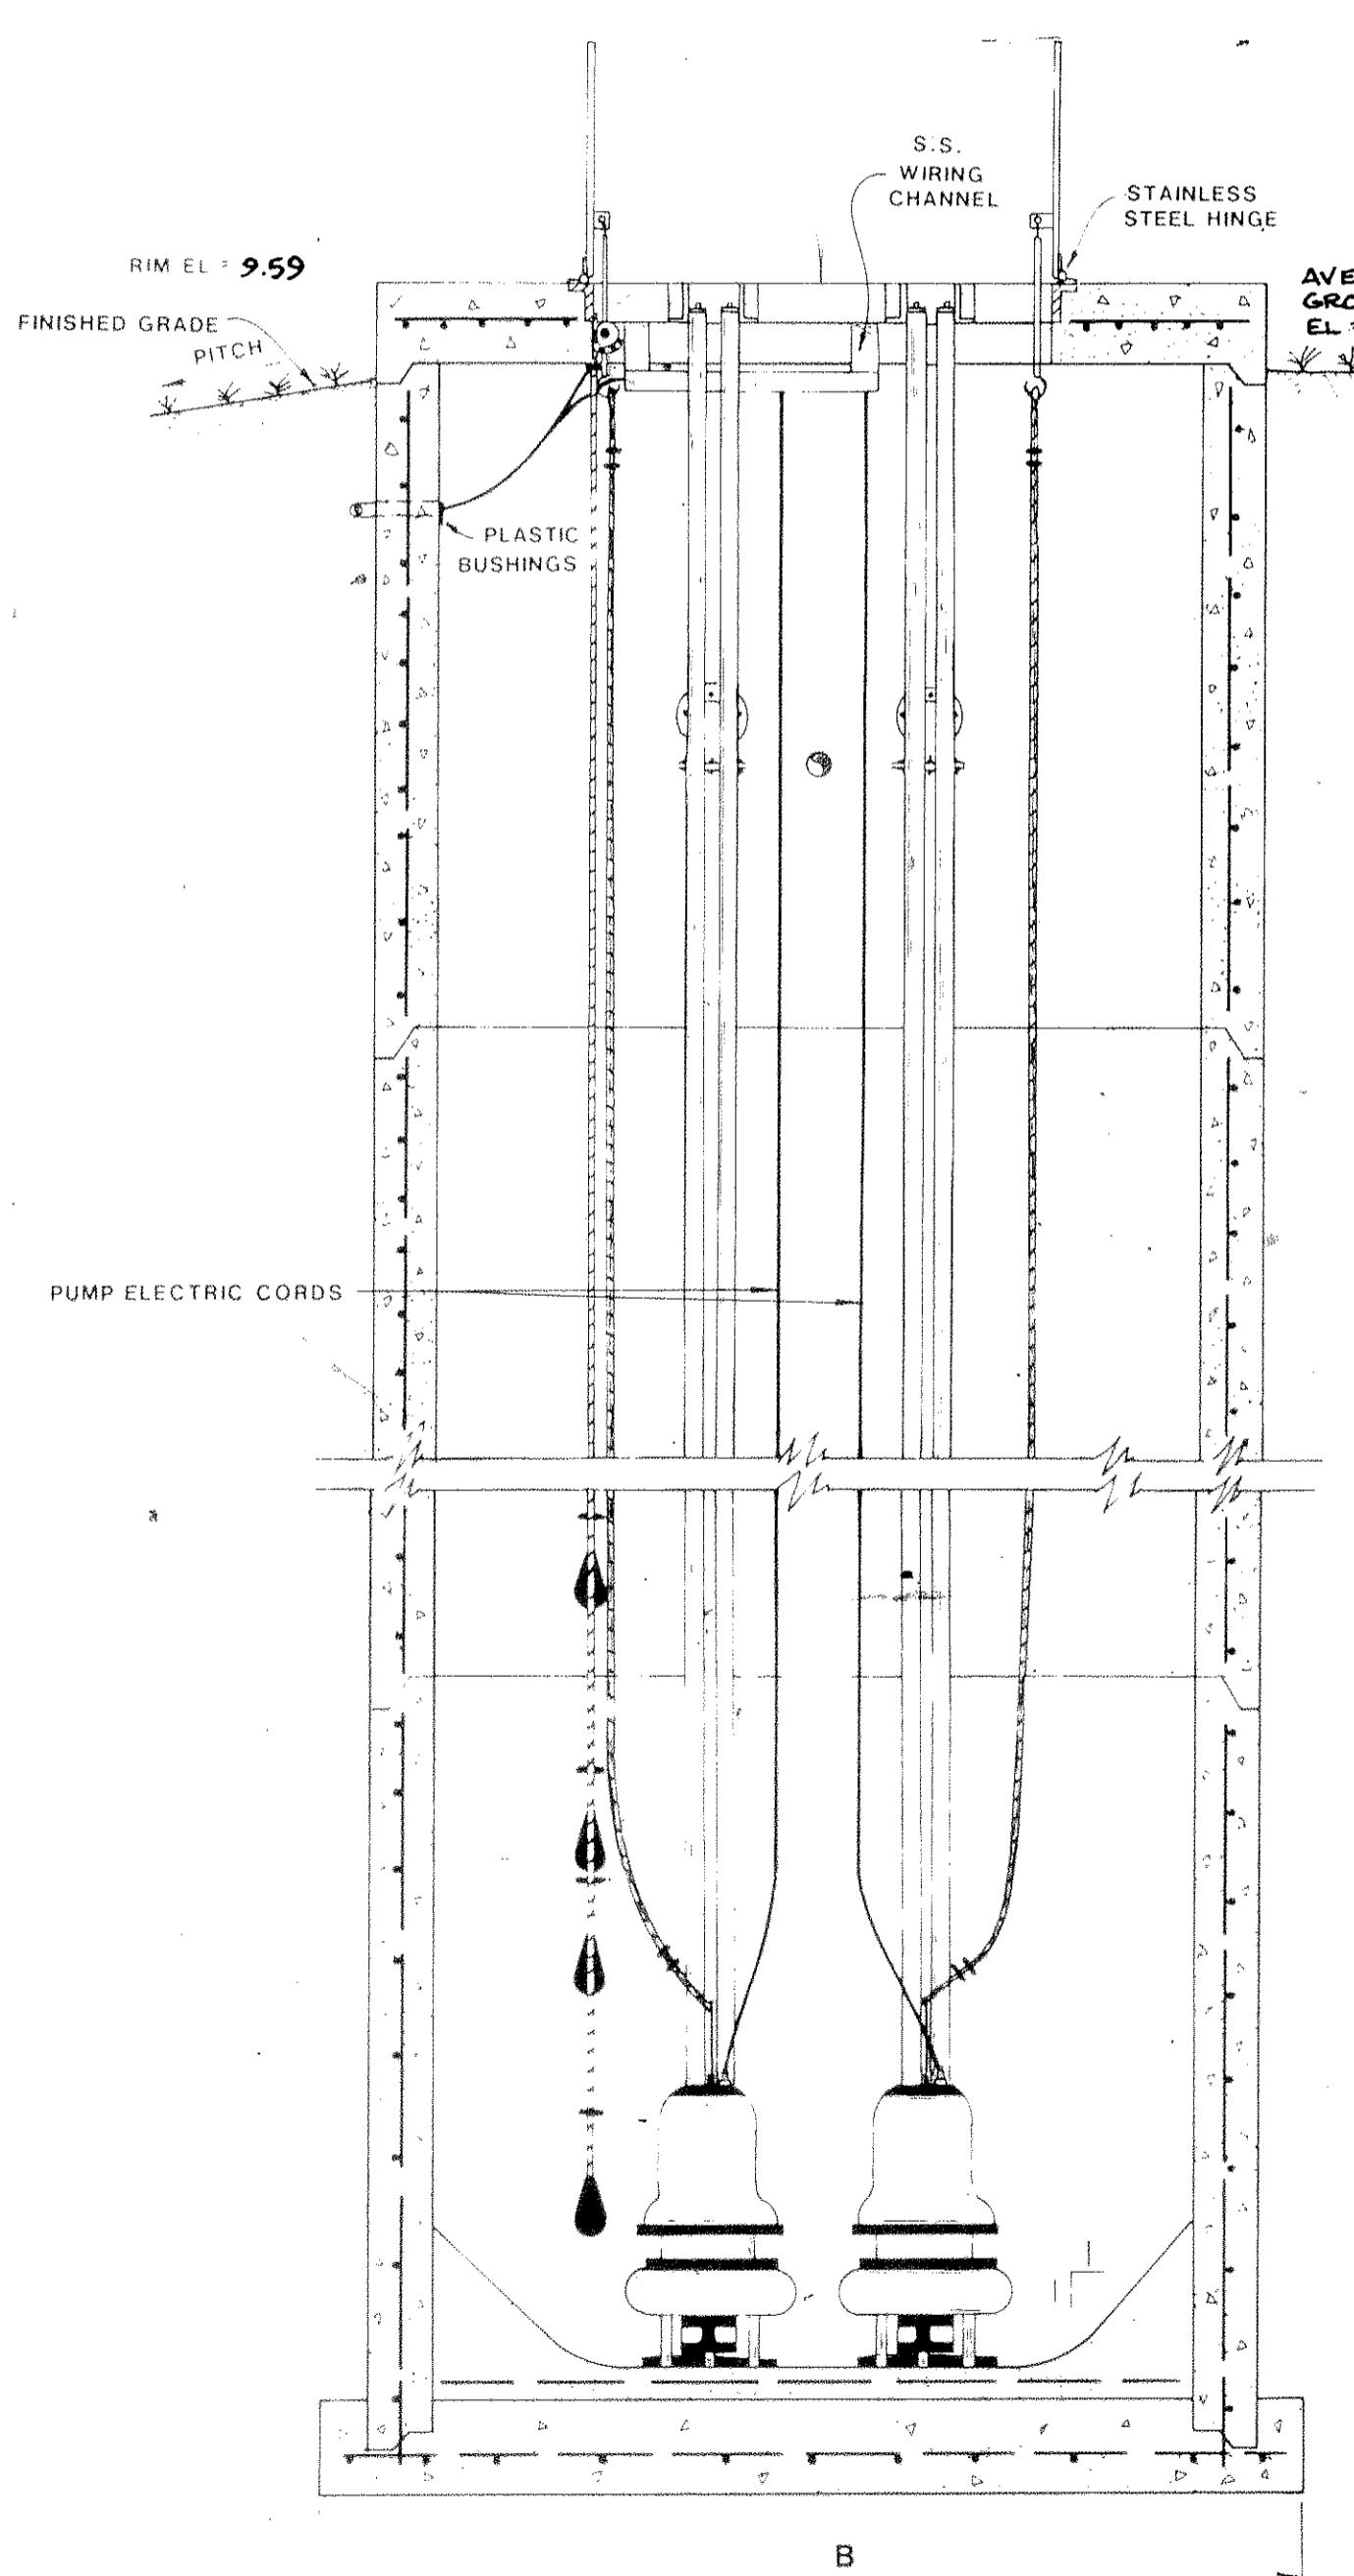


SECTION "A-A"

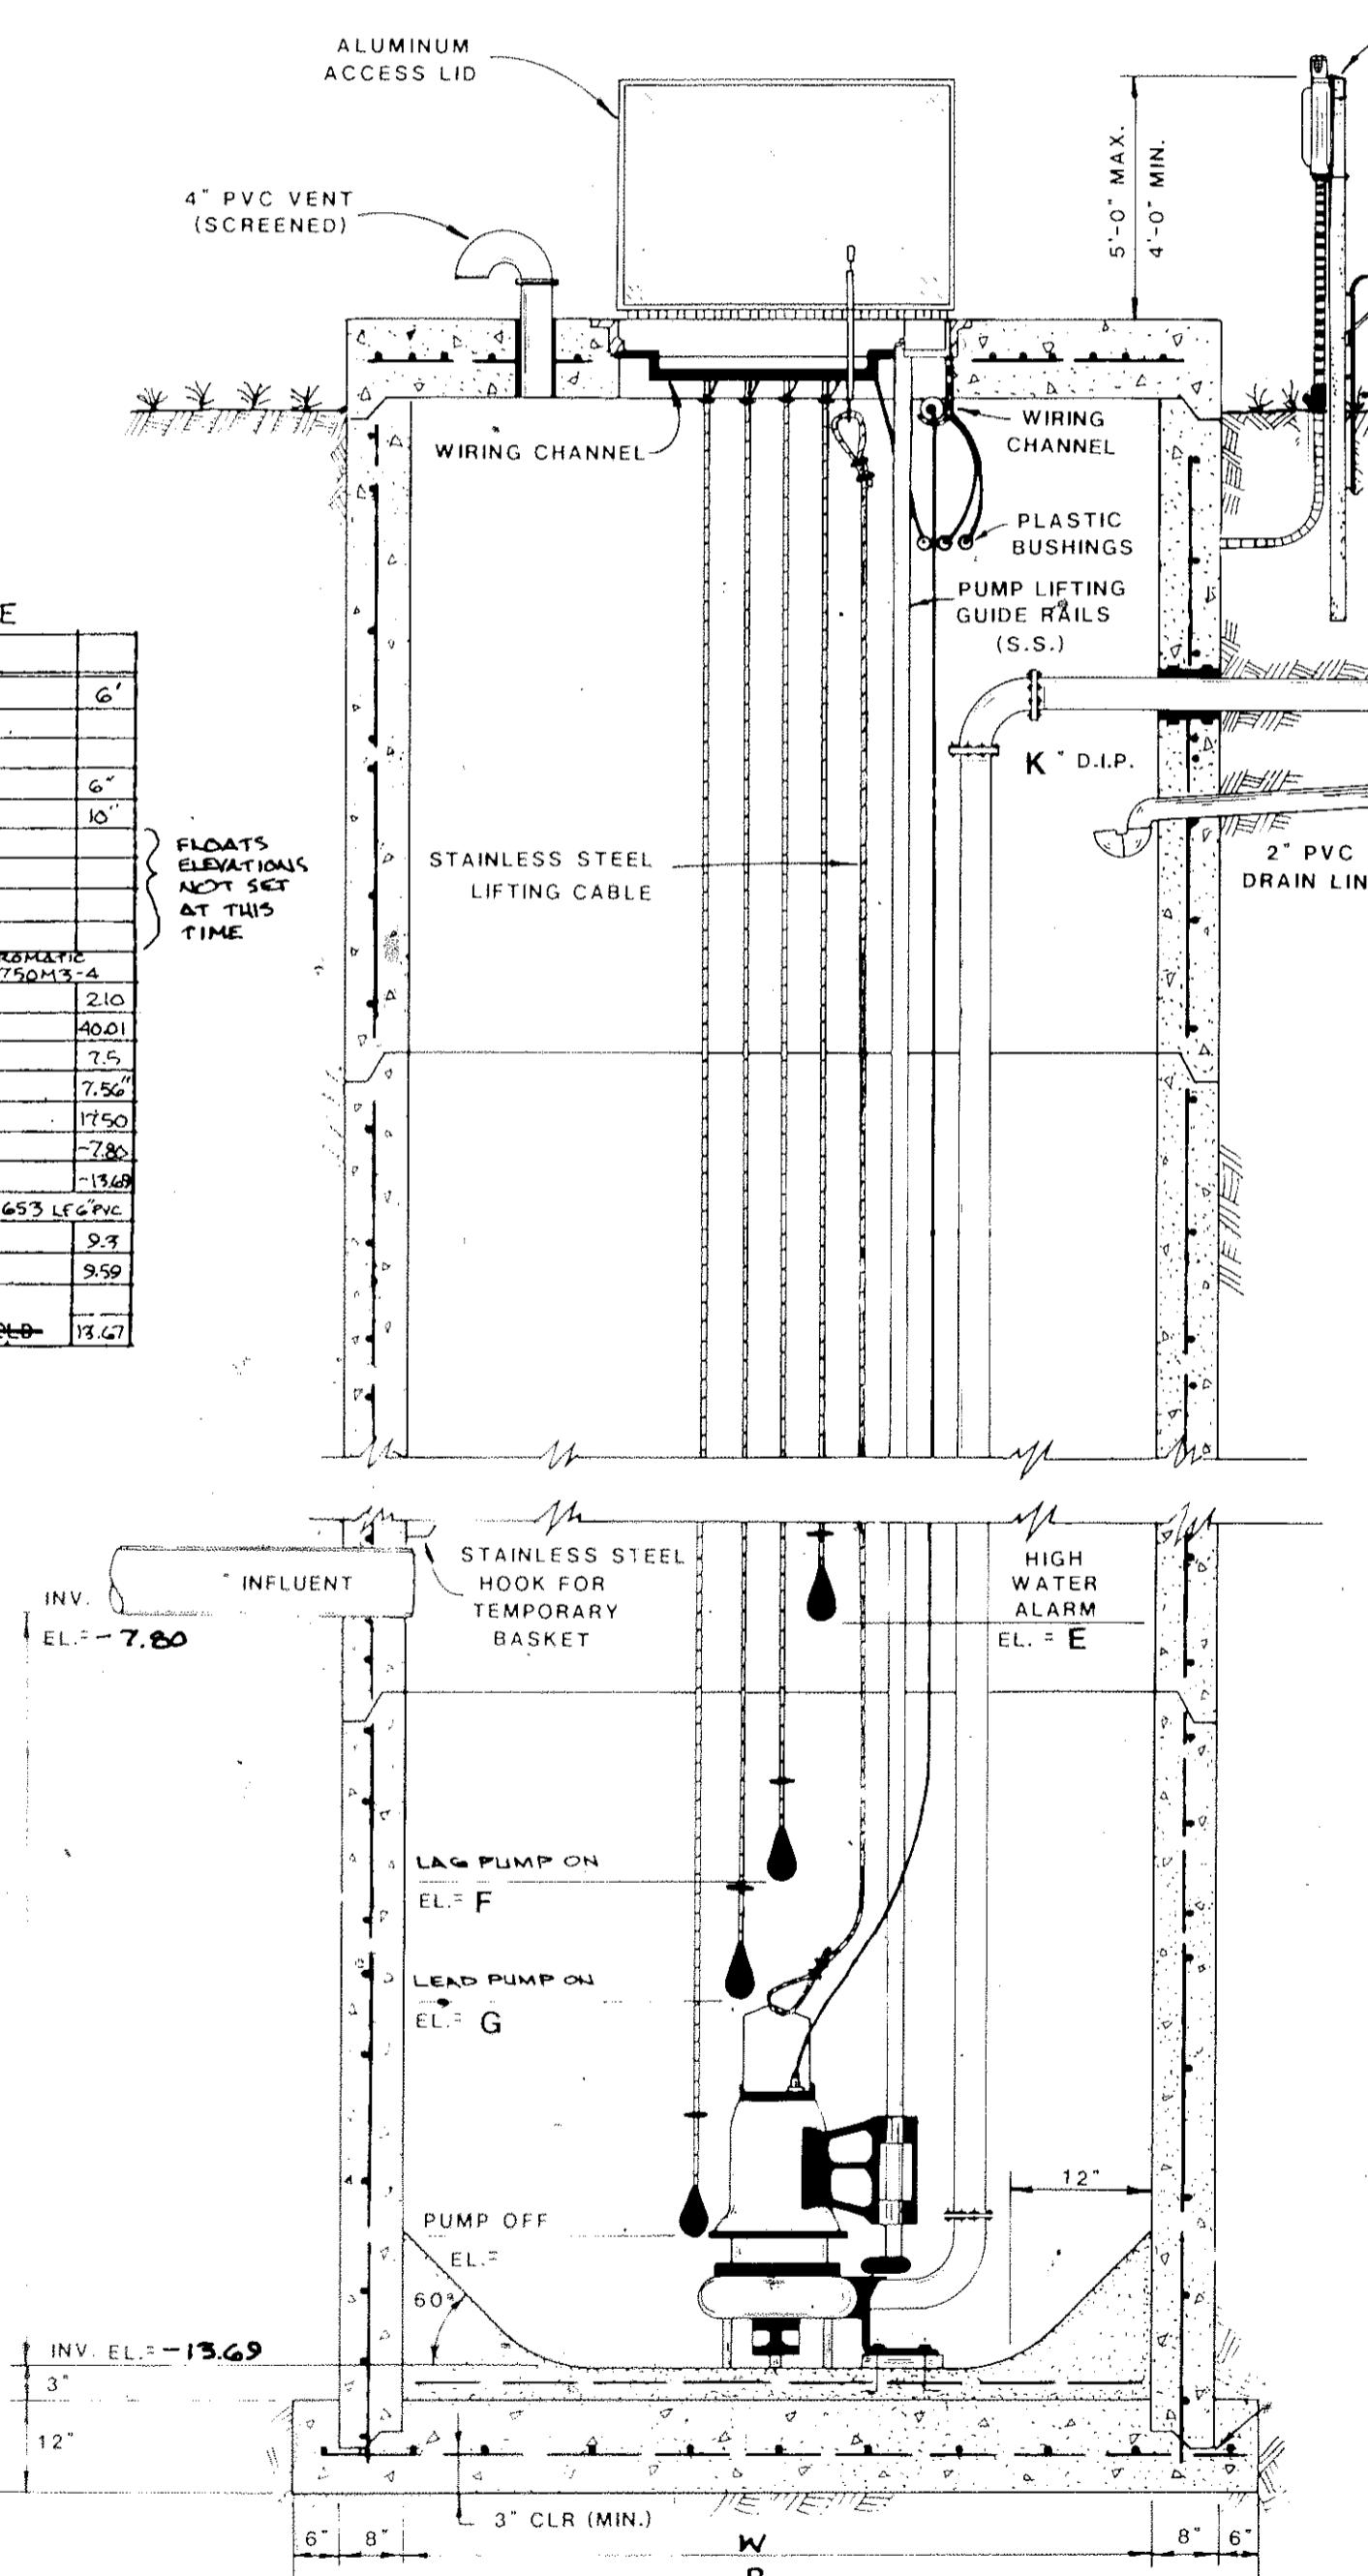

SECTION "B-B"

NOTE: FLOAT CONTROL LEVELS MAY BE ADJUSTED AT TIME OF
INSTALLATION TO MEET PROPOSED SERVICE CONDITIONS.

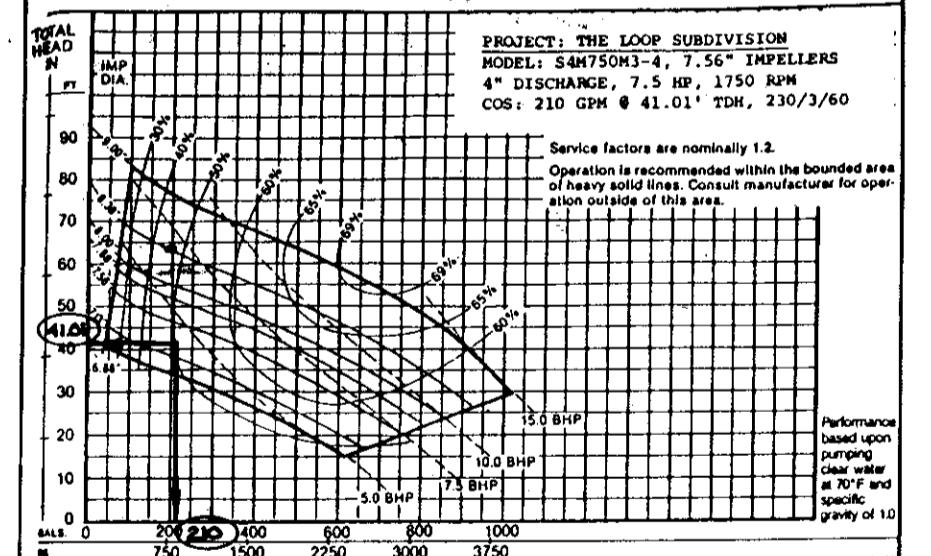

TYPICAL PERFORMANCE CURVE

RECORD DRAWING NOTES:

- CERTAIN INFORMATION ON THIS SHEET DOES NOT NECESSARILY APPLY TO THE LIFT STATION AND PUMPS ACTUALLY INSTALLED. ONLY THE INFORMATION SPECIFICALLY REQUIRED FOR RECORD DRAWING PURPOSES HAS BEEN ALTERED FROM THE ORIGINAL ENGINEERING DRAWING.
- THE FORCE MAIN CONSISTS OF 3,653 LINEAR FEET OF 6" PVC.

201 5TH AVENUE DRIVE EAST POST OFFICE BOX 9448	BRADENTON, FLORIDA 32506 TELEPHONE (813) 748-8000
DESIGNED BY JH CHECKED MJD DATE MAY 1990 SCALE 1:100 DRAWN JH COMP JOB NO 756-11617 FILE NO 10640 SHEET 5 OF 8	

T240