



F:\PROJECT\09217088.16\Drawings\Engineering Drawings\Revisions (May 2020)\Sheet 5-6 - Existing and Proposed Conditions.dwg May 04, 2020 - 11:56am Layout Name: 4382kcc

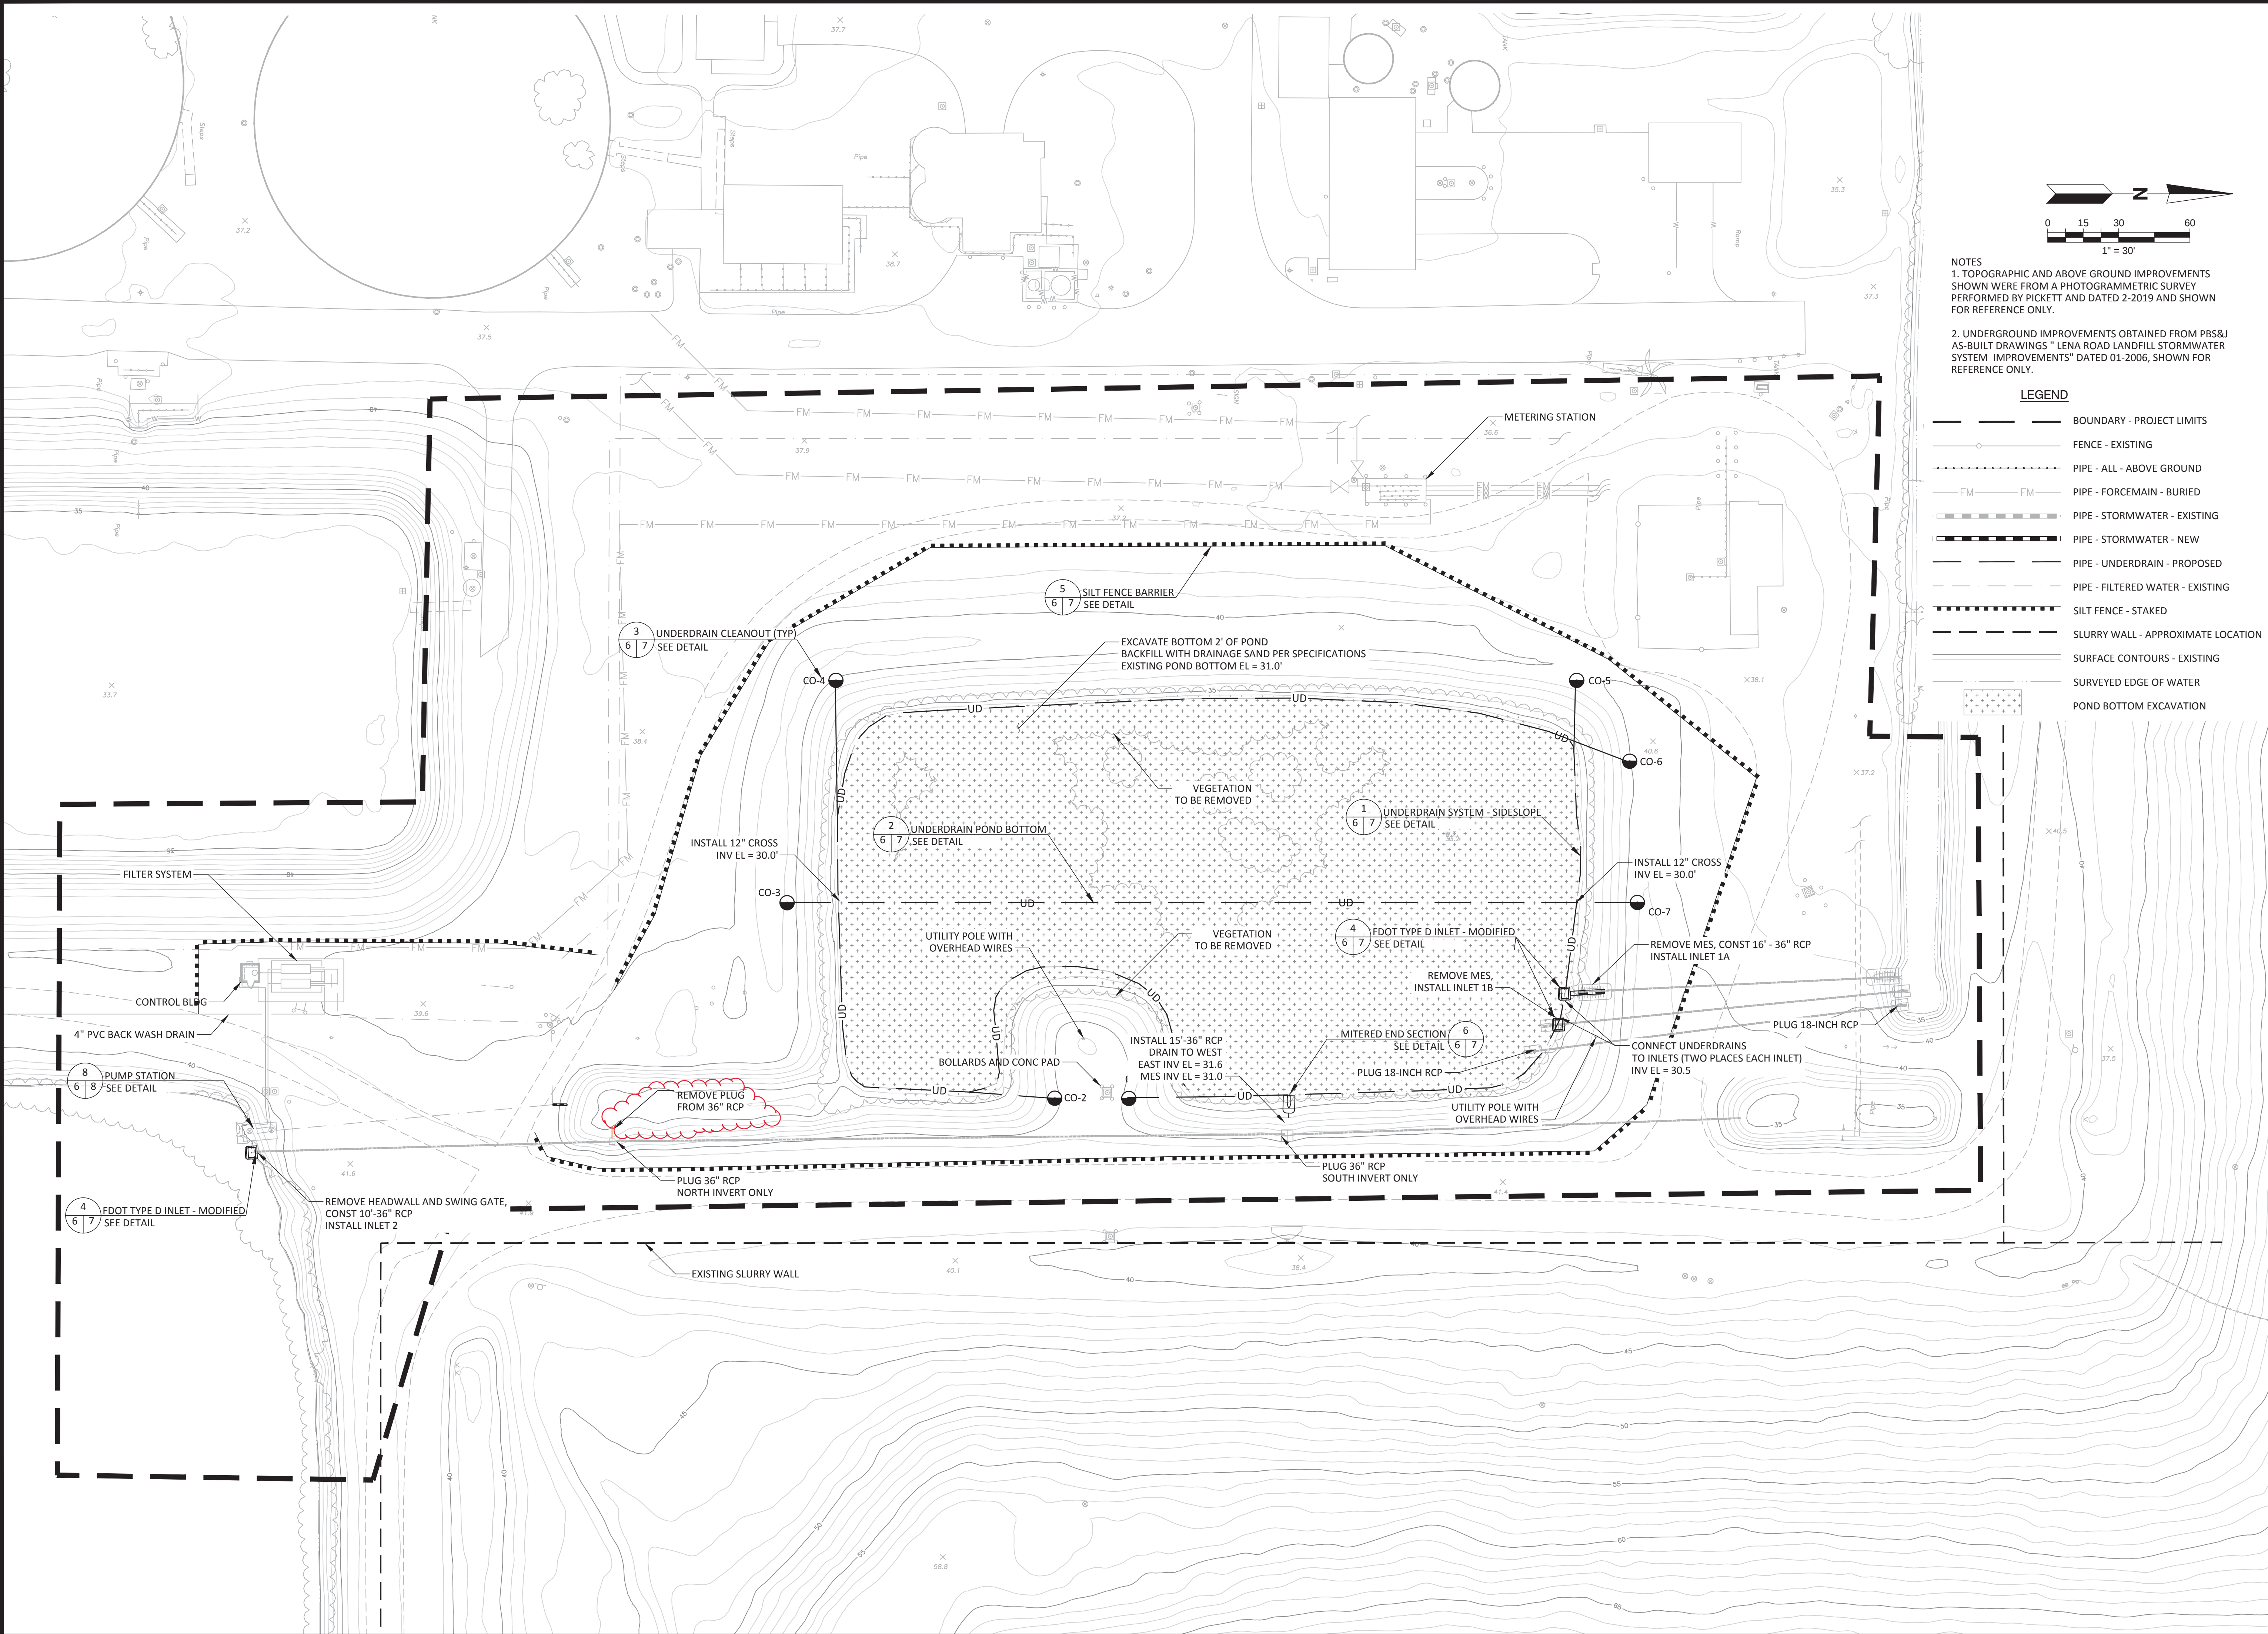

NOTES
1. TOPOGRAPHIC AND ABOVE GROUND IMPROVEMENTS SHOWN WERE FROM A PHOTOGRAMMETRIC SURVEY PERFORMED BY PICKETT AND DATED 2-2019 AND SHOWN FOR REFERENCE ONLY.
2. UNDERGROUND IMPROVEMENTS OBTAINED FROM PBS&J AS-BUILT DRAWINGS "LENA ROAD LANDFILL STORMWATER SYSTEM IMPROVEMENTS" DATED 01-2006, SHOWN FOR REFERENCE ONLY.

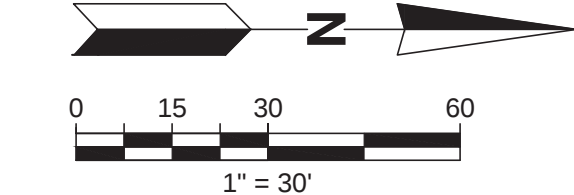


- LEGEND**
- BOUNDARY - PROJECT LIMITS
 - FENCE - EXISTING
 - PIPE - ALL - ABOVE GROUND
 - PIPE - FORCEMAIN - BURIED
 - PIPE - STORMWATER - EXISTING
 - PIPE - STORMWATER - NEW
 - PIPE - UNDERDRAIN - PROPOSED
 - PIPE - FILTERED WATER - EXISTING
 - SILT FENCE - STAKED
 - SLURRY WALL - APPROXIMATE LOCATION
 - SURFACE CONTOURS - EXISTING
 - SURVEYED EDGE OF WATER
 - POND BOTTOM EXCAVATION

CHK BY	
DESCRIPTION	IDENTIFY GROUT PLUG REMOVAL
DATE	6/1/2020
REV	
SHEET TITLE POND CONTROL MODIFICATION PLAN	
PROJECT TITLE LENA ROAD LANDFILL STORMWATER SYSTEM REVISIONS	
CLIENT MANATEE COUNTY UTILITIES DEPARTMENT 4410 66TH STREET WEST BRADENTON, FLORIDA 34210	
CADD FILE: SHEET 5-6 - EXISTING AND PROPOSED CONDITIONS	
DATE: MAY 2020	
SCALE: AS SHOWN	
DRAWING NO. 6	
SHEET 6 of 8	


SCS ENGINEERS
STEARNS, CONRAD AND SCHMIDT
CONSULTING ENGINEERS
3922 COCONUT PALM DRIVE, SUITE 102, TAMPA, FL 33619
PH (813) 621-0080 FAX NO. (813) 623-4757
FLORIDA FIRM REGISTRATION RY-4892

PRED. NO. 09217085.16	DRAWN BY KCC	C/CARAWAY BY SRF
CHECK BY WJE	APP. BY WJE	SRF

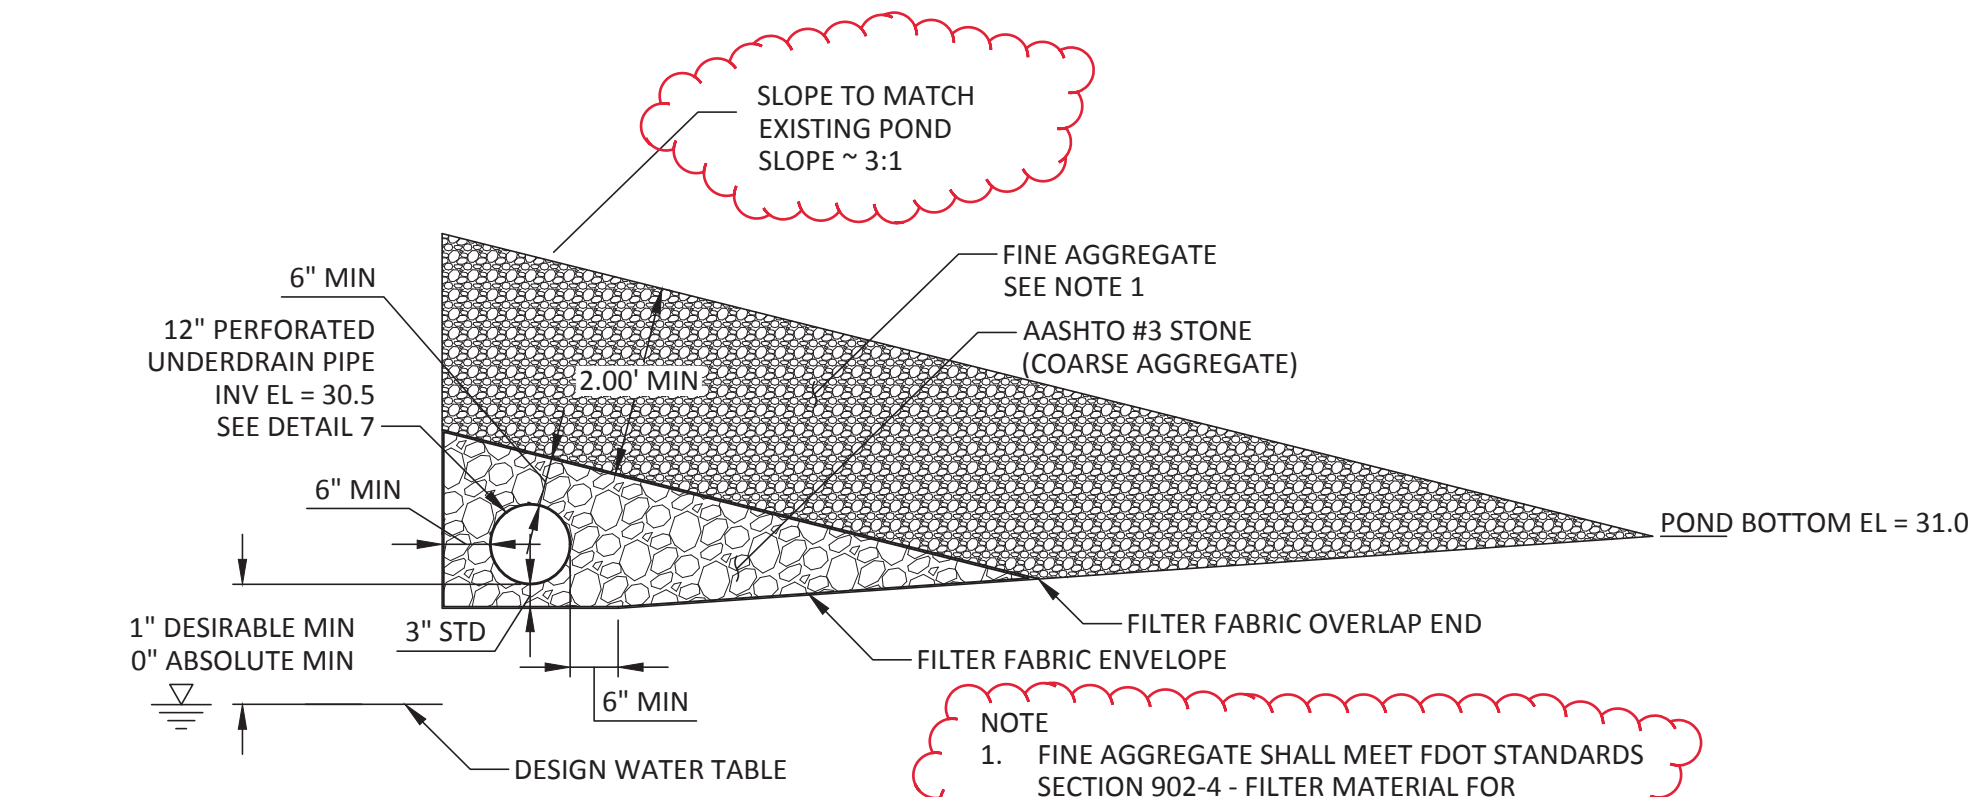


UNDERDRAIN SYSTEM - SIDESLOPE DETAIL

1
6 7

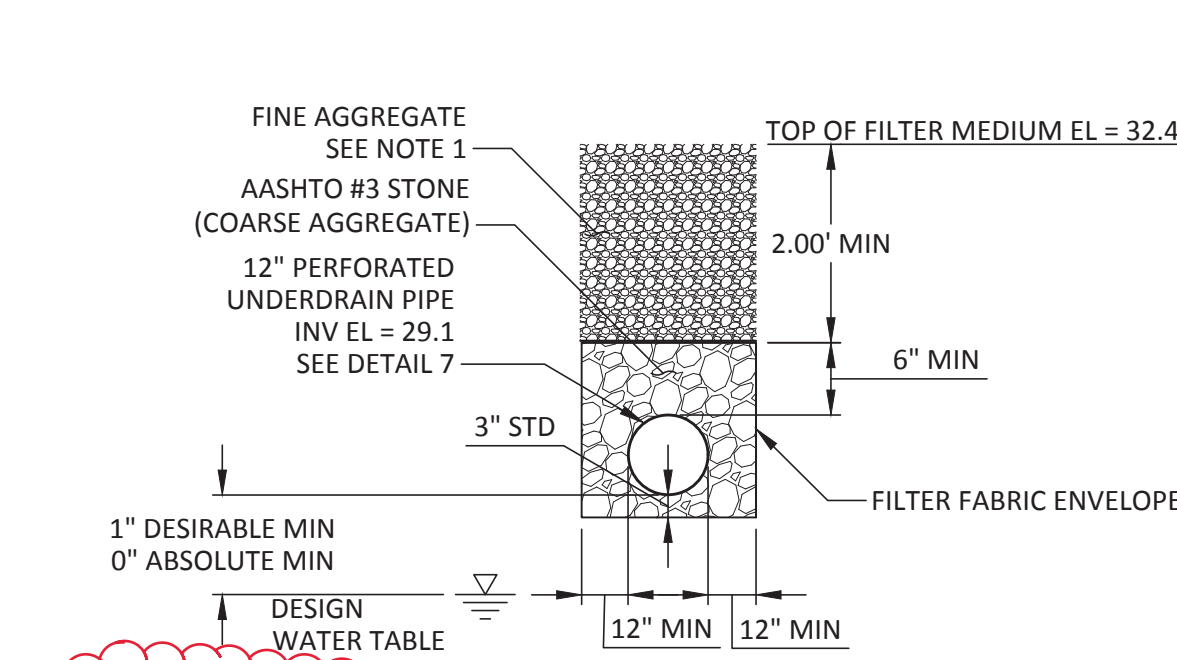


UNDERDRAIN POND BOTTOM DETAIL

2
6 7

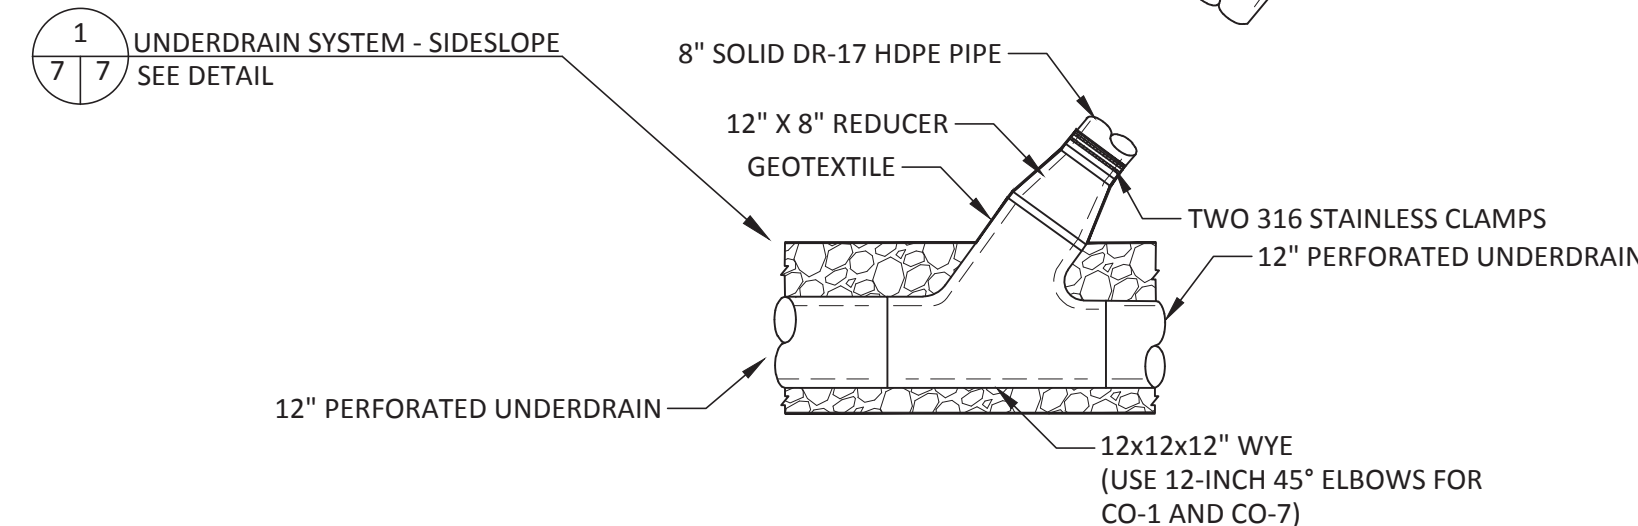


UNDERDRAIN CLEANOUT DETAIL

3
6 7

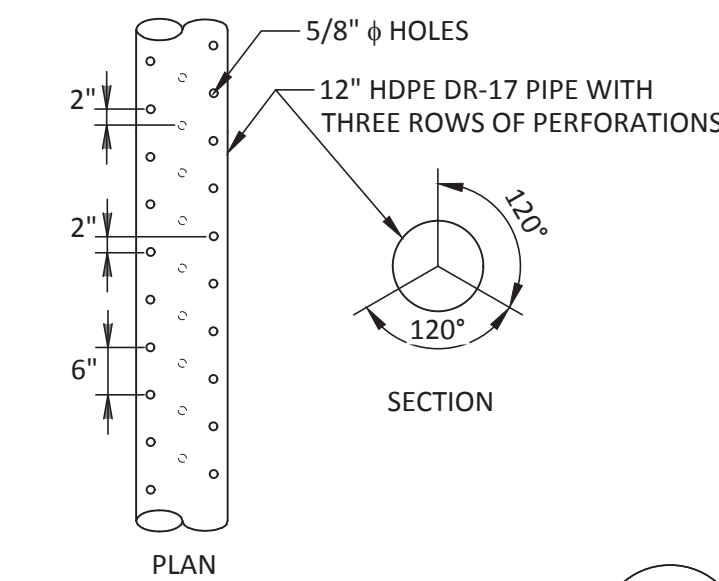

PIPE PERFORATION

7
7 7

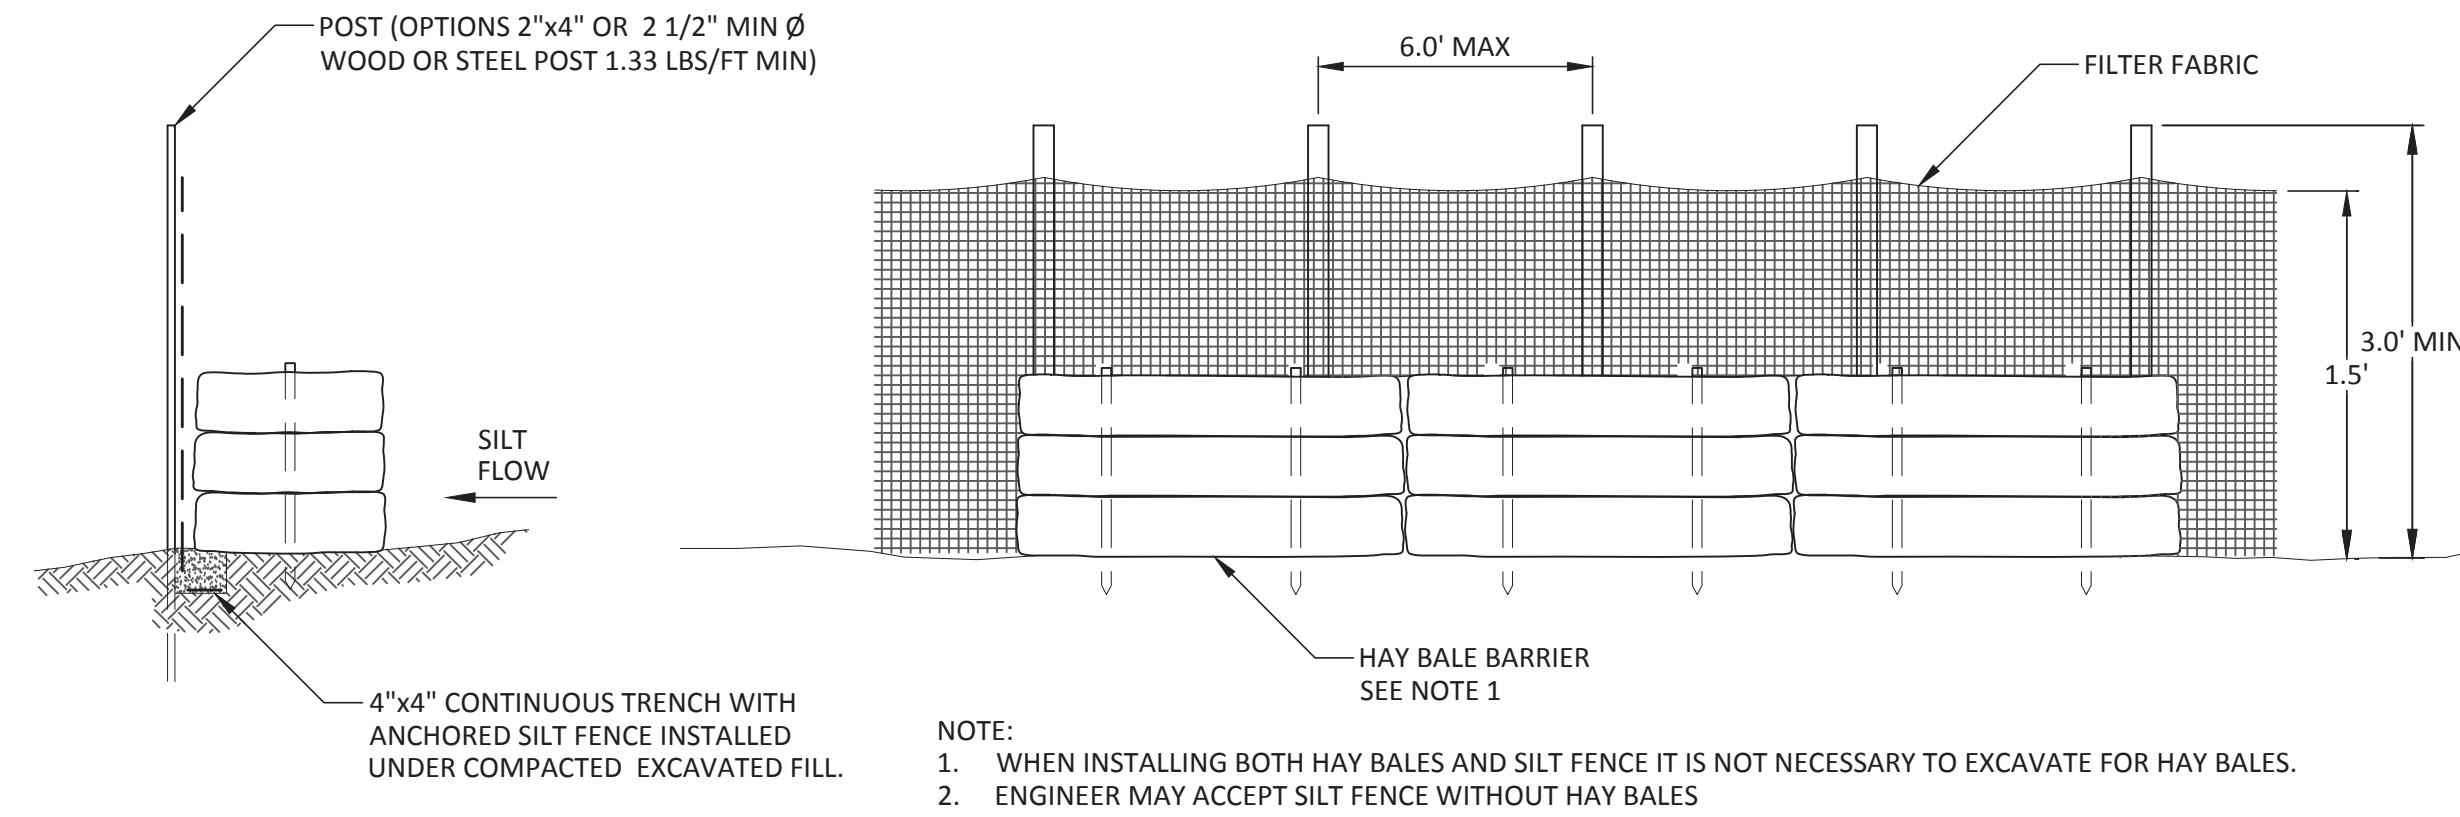


SILT FENCE BARRIER DETAIL

5
6 7



STR. NO.	ELEVATION 'A'	ELEVATION 'B'	ELEVATION 'C'	ELEVATION 'D'
1A	38.0	37.0	30.5 36" RCP	30.0* 12" HDPE
1B	37.5	36.5	30.0* 18" RCP	30.0* 12" HDPE
2	37.7	36.7	30.0* 36" RCP	32.0 12" PVC

* INLET BOTTOM INTERIORS SET AT LOWEST INVERT ELEVATION WHICH IS AT ELEVATION 30.0 FOR EACH STRUCTURE.

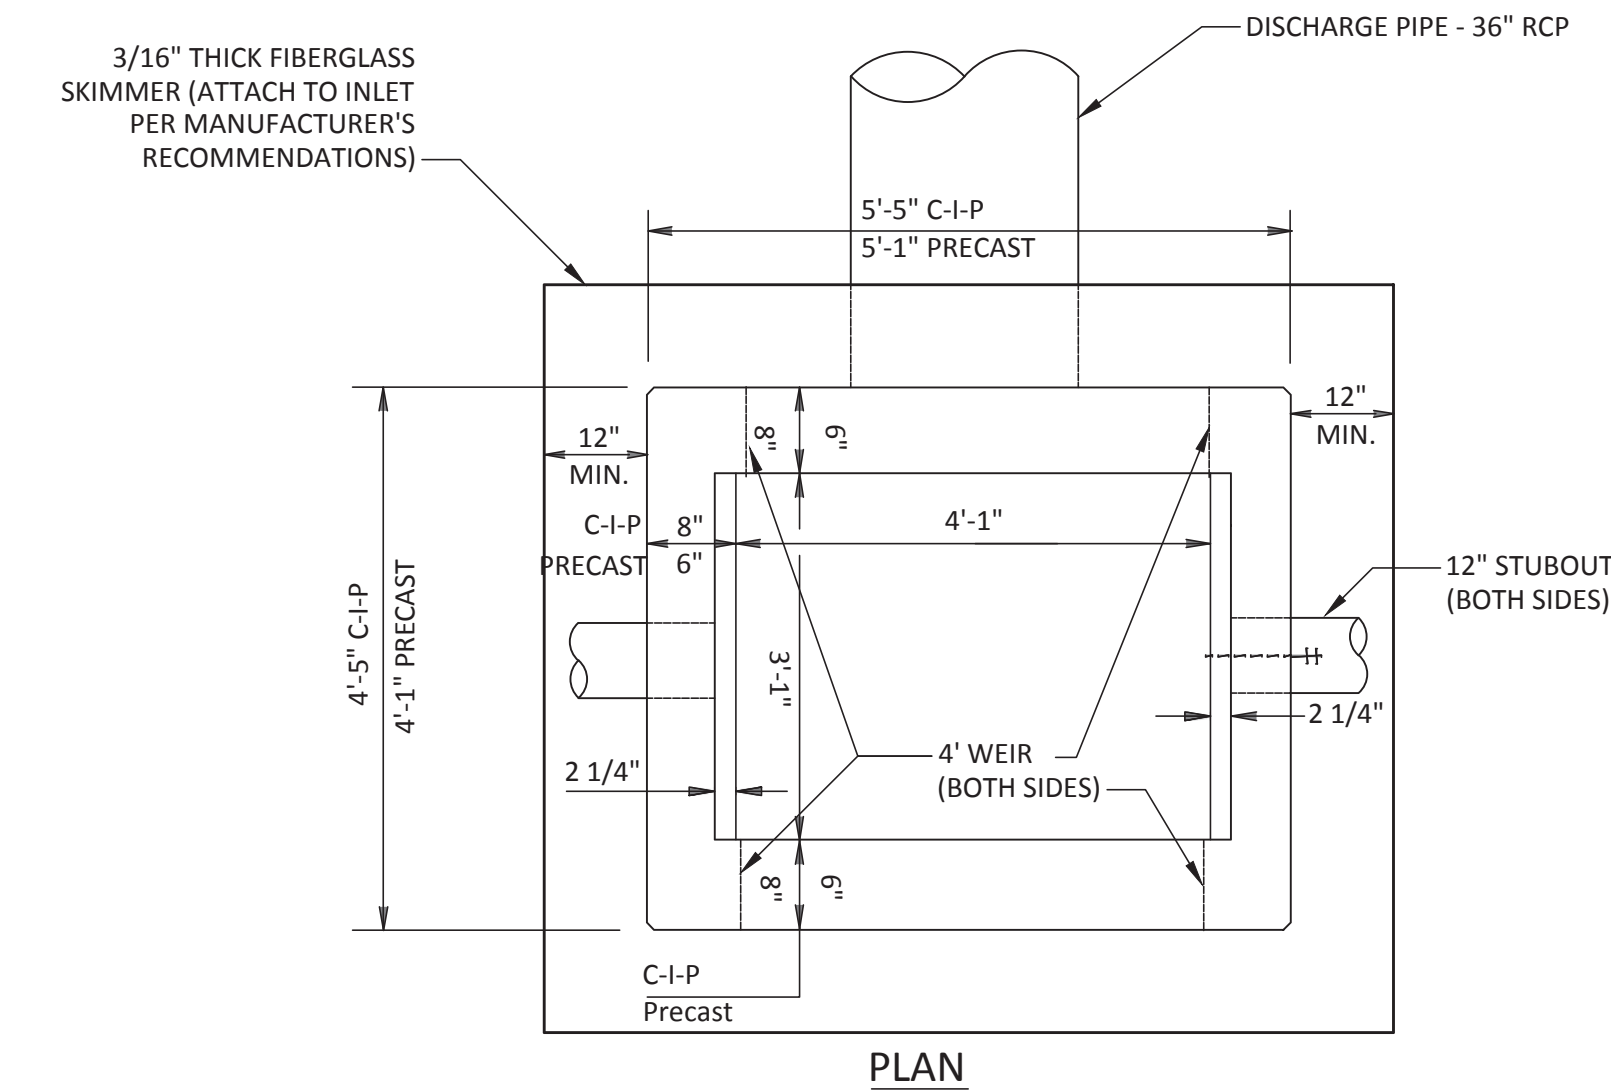

CONTROL STRUCTURE DETAIL

4
6 7

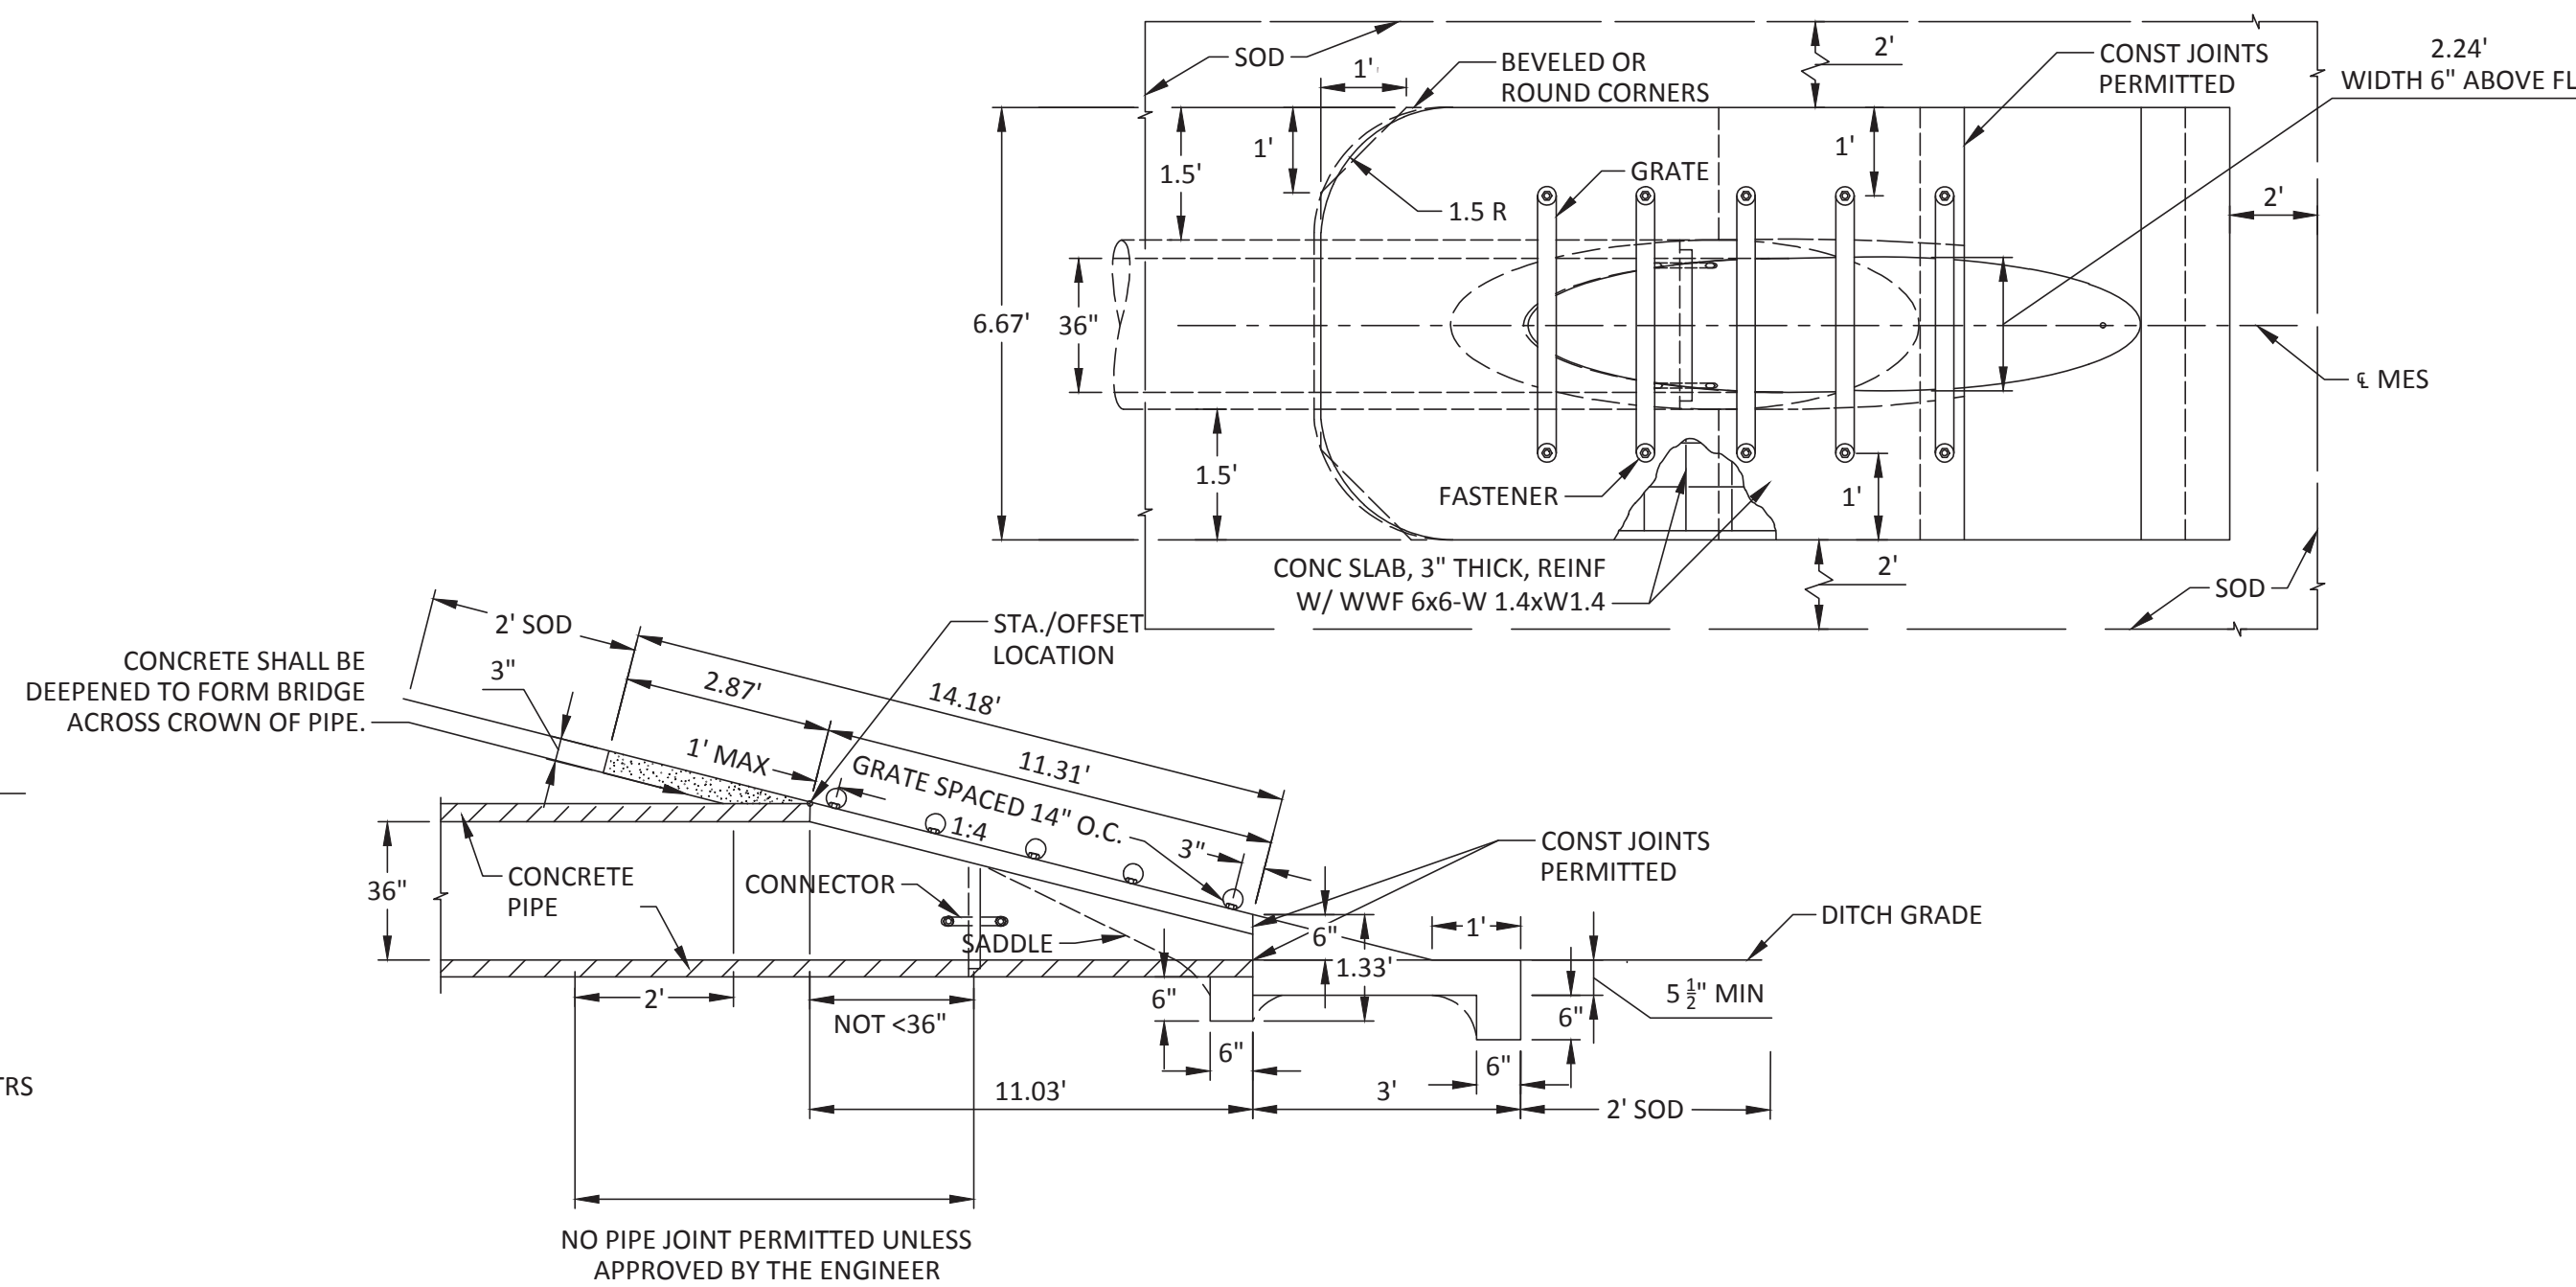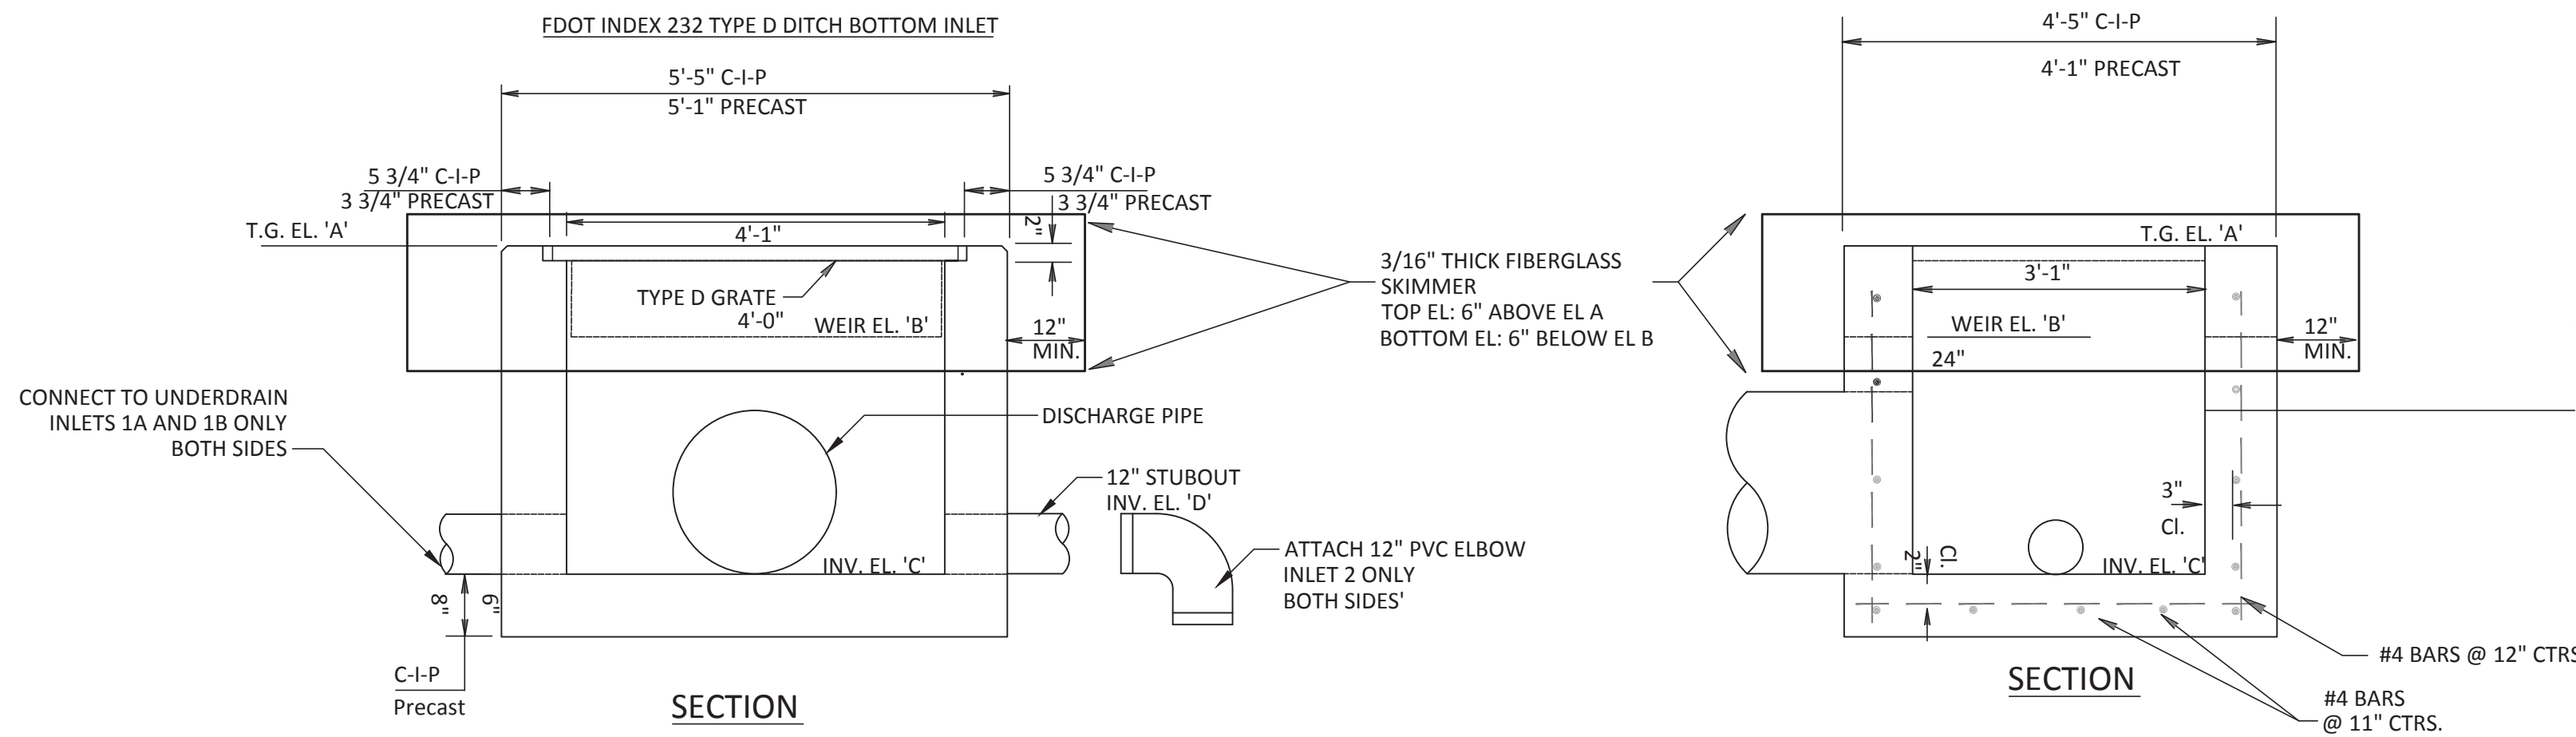

MITERED END SECTION

6
6 7

MANATEE COUNTY UTILITIES
DEPARTMENT
4410 66TH STREET WEST
BRADENTON, FLORIDA 34210

SCS ENGINEERS
STEARN, CONRAD AND SCHMIDT
CONSULTING ENGINEERS
3922 COCONUT PALM DRIVE, SUITE 102, TAMPA, FL 33619
PH (813) 621-0080 FAX NO. (813) 623-6757
FLORIDA FIRM REGISTRATION RY-4892

CHK. BY: SRF
APP. BY: SRF
DATE: MAY 2020
SHEET 7-8 - DETAILS

DATE: MAY 2020
SCALE: AS SHOWN
DRAWING NO. 7
SHEET 7 of 8

DETAILS
SHEET TITLE
PROJECT TITLE
LENNA ROAD LANDFILL
STORMWATER SYSTEM REVISIONS

MANATEE COUNTY UTILITIES
DEPARTMENT
4410 66TH STREET WEST
BRADENTON, FLORIDA 34210

SCS ENGINEERS
STEARN, CONRAD AND SCHMIDT
CONSULTING ENGINEERS
3922 COCONUT PALM DRIVE, SUITE 102, TAMPA, FL 33619
PH (813) 621-0080 FAX NO. (813) 623-6757
FLORIDA FIRM REGISTRATION RY-4892

CHK. BY: SRF
APP. BY: SRF
DATE: MAY 2020
SHEET 7-8 - DETAILS

DATE: MAY 2020
SCALE: AS SHOWN
DRAWING NO. 7
SHEET 7 of 8

