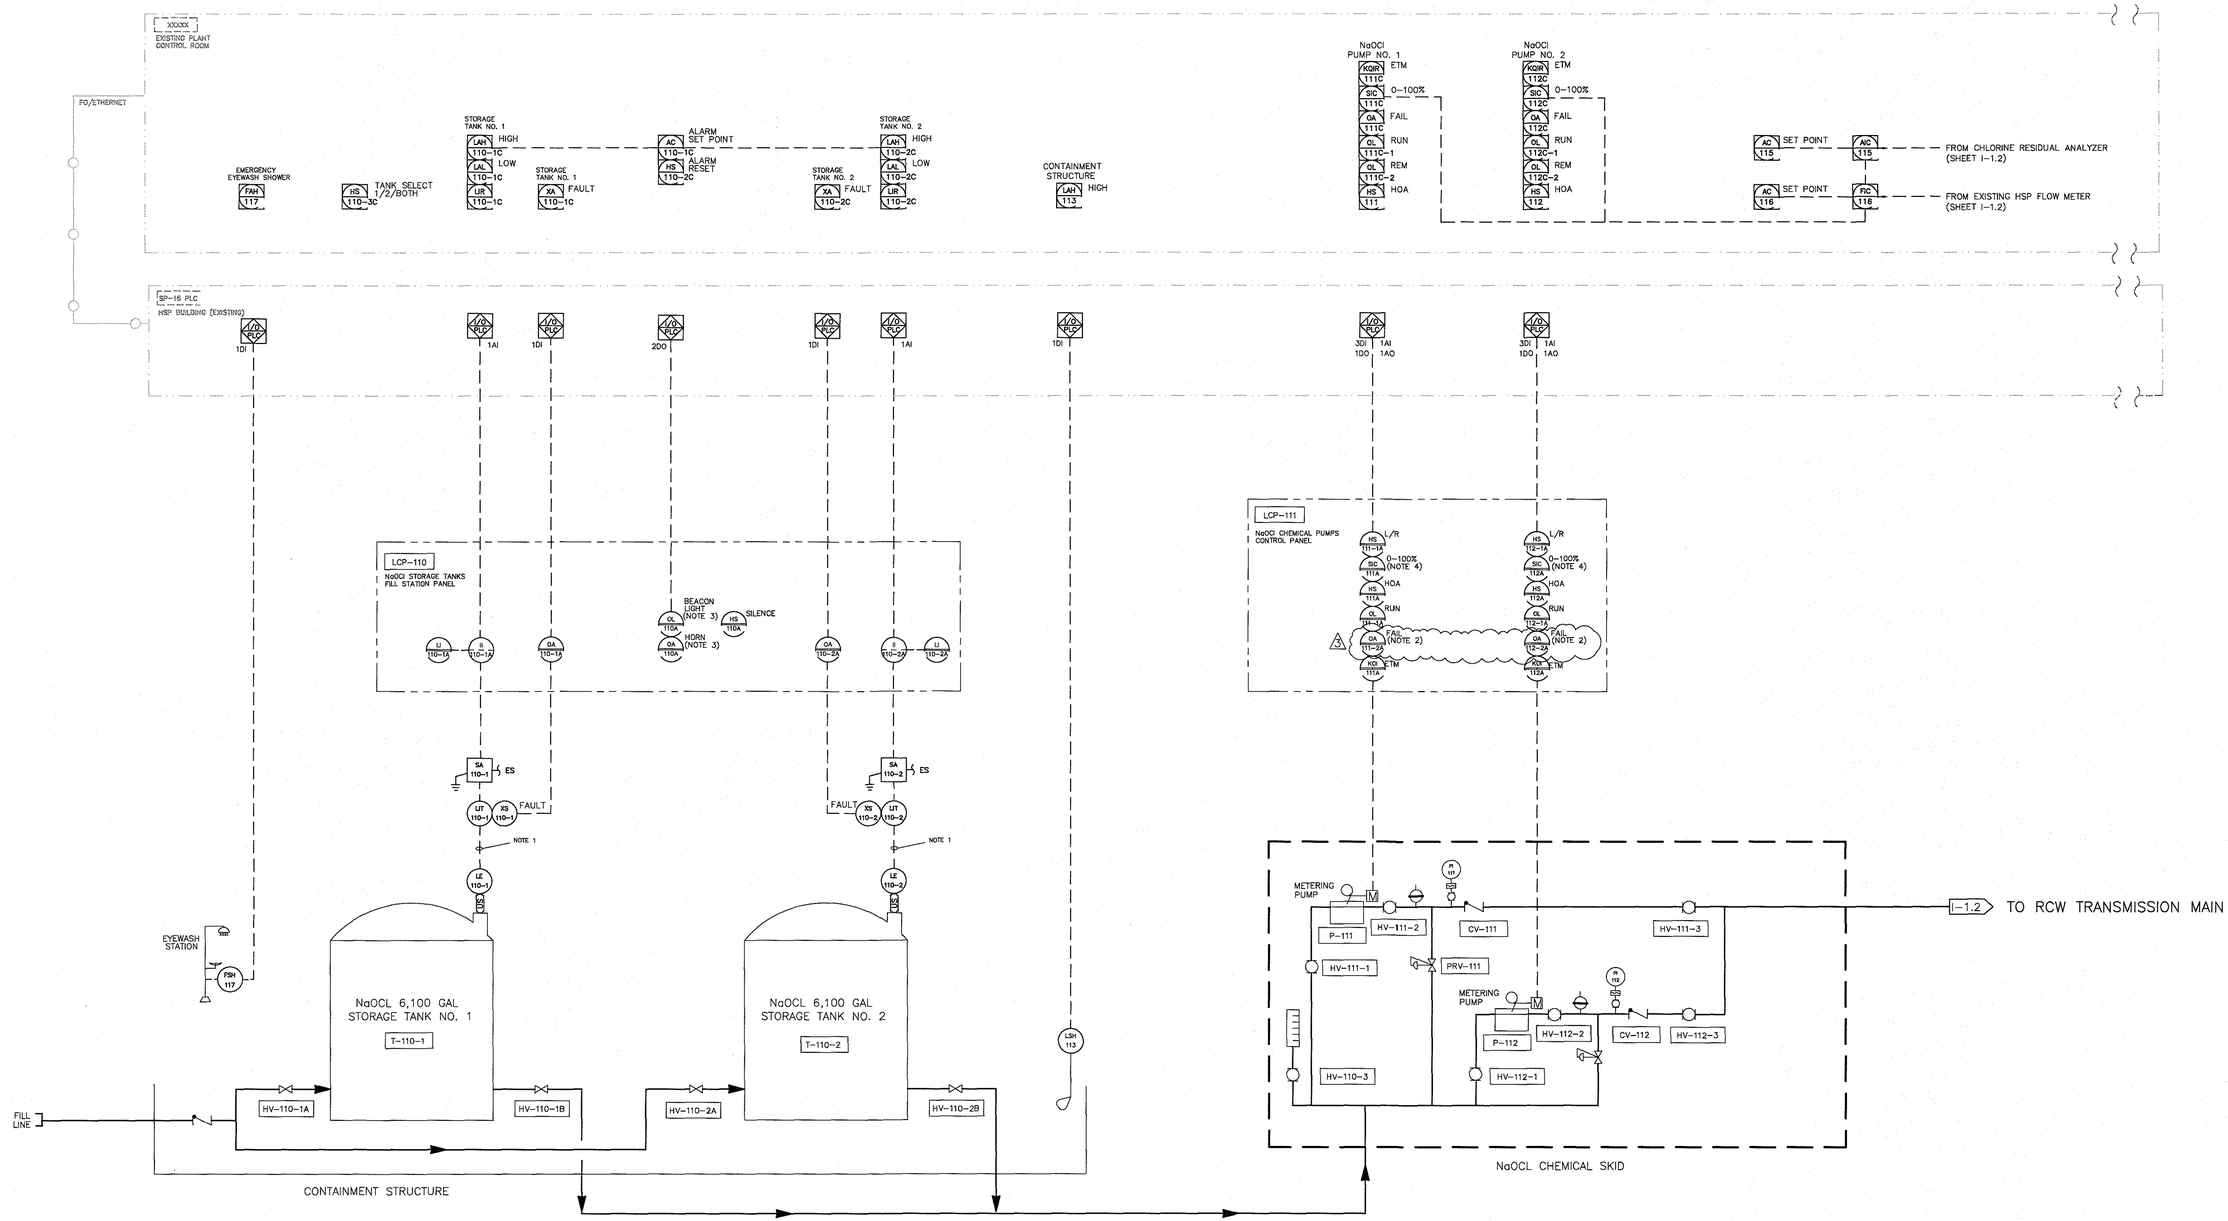

NaOCL CHEMICAL SYSTEM (CHEMICAL BUILDING)

NOTES:

1. ~~MANUFACTURER CABLE W/NO SPLICES.~~
2. PUMP FAILED PILOT LIGHT, AMBER.
3. ~~ACTIVATE ON TANK 1 OR 2 HIGH LEVEL.~~
4. SPEED FEEDBACK IS PROPORTIONAL TO THE SPEED OF THE PUMP ONLY

REV.NO.	DESCRIPTIONS	DATE
	ADDENDUM #3	OCT. 2015

REVISIONS

SEAL

MICHAEL TWEEDIE LICENSE No 60290 STATE OF FLORIDA PROFESSIONAL ENGINEER
10-7-2015
MICHAEL TWEEDIE No. 60290

SEAL

McKIM&CREED
378 Interstate Court
Sarasota, FL 34240
Phone: (941)379-3404, Fax: (941)379-3530
CA Lic. No. 29588
www.mckimcreed.com

Manatee County FLORIDA

MARS CHLORINATION SYSTEM AT THE SWWRF

PROCESS AND INSTRUMENTATION DIAGRAM SODIUM HYPOCHLORITE STORAGE AND PUMPING

DATE:	JULY 2015
MCE PROJ. #	1024-0168
DRAWN	RRO
DESIGNED	RRO
CHECKED	MDT
PROJ. MGR.	BRP

SCALE
HORIZONTAL: NA
VERTICAL: NA

DRAWING NUMBER
I-1.1

STATUS: ISSUED FOR BID
REVISION

C:\Users\rrosquesto\Microtec SWWRF (CL2)\Addendum #3\1024-0168-1_I.dwg, 10/6/2015 3:25:07 PM, Rebecca Desquesto