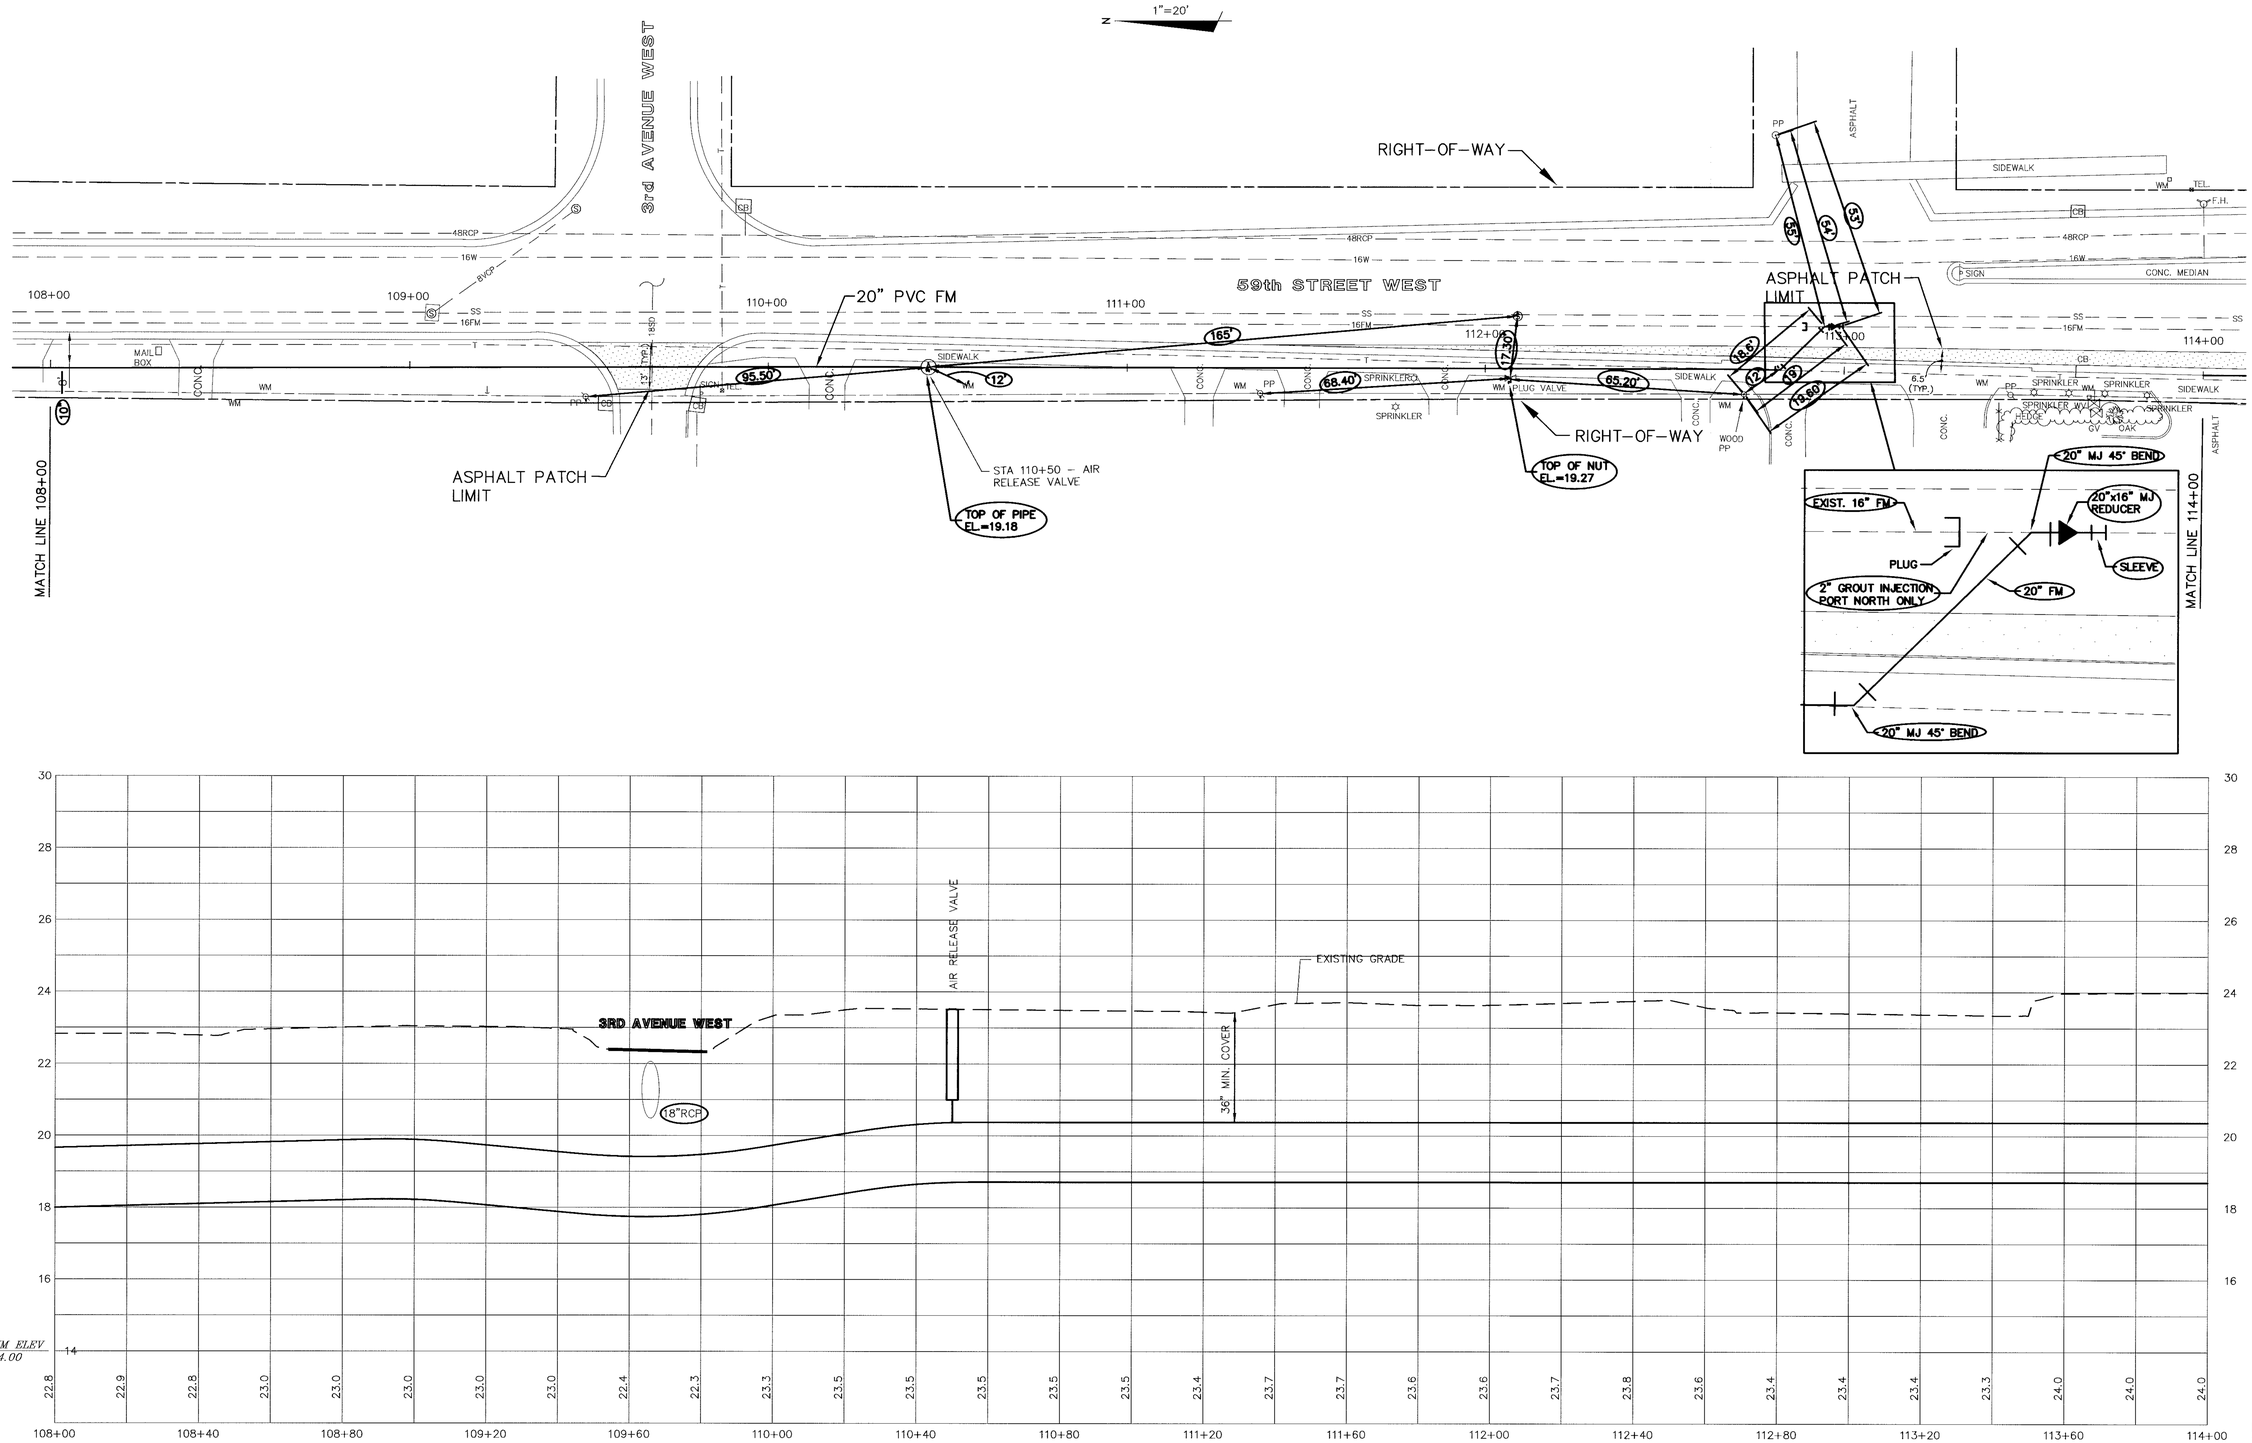


| REV. | | CHECK | DRAWN | APP. | DATE |
|---|---|---|---|---|---|
| F | RECORD DRAWING | NJS | TMZ | ASL | 9/29/00 |
| E | ISSUED FOR BID | NJS | SPS | ASL | 6/13/97 |
| D | 100% CLIENT SUBMITTAL | NJS | SPS | ASL | 5/7/97 |
| C | 90% CLIENT SUBMITTAL | NJS | TG | ASL | 3/19/97 |
| B | 60% CLIENT SUBMITTAL | NJS | SPS | ASL | 1/8/97 |
| A | 30% CLIENT SUBMITTAL | NJS | SPS | ASL | 12/6/96 |

McKIM&CREED
ENGINEERS • ARCHITECTS • SURVEYORS

# PLAN & PROFILE
# STATION 108+00 TO 114+00

FORCE MAIN 15D – MANATEE COUNTY

| | |
|---|---|
| DESIGNED BY: | NJS |
| DRAWN BY: | SPS |
| CHECKED BY: | NJS |
| APPROVED BY: | ASL |
| DATE: | |
| PROJ. NUMBER: | 1024-0006 |
| SHEET NUMBER: | C-21 |
| REV | E |

S:\1024\0006\80-Dwg\80-Record\pal21.dwg Fri Sep 29 16:14:42 2000